

1847
sheet
1/2

OK

OK

Paul

see
survey

-020
Pt. -009
Pt. 56.00A.
55.00 Ac.

7847

APPROVED LORAIN CO. MAP DEPT.
DATE 3-29-74
PAGE
BY: <i>Paul</i>
VOID AFTER

7847

APPROVED LORAIN CO. MAP DEPT.
DATE 3-29-74
PAGE 12-00-043-A+B
BY: <i>Paul</i>
VOID AFTER

3-29-86


Pg. 12.00-093-A

sheet
2/2

7847

Pg. 12.00-093-B

-020
Pt. -009
Pt. 56.00A.
55.00 Ac.

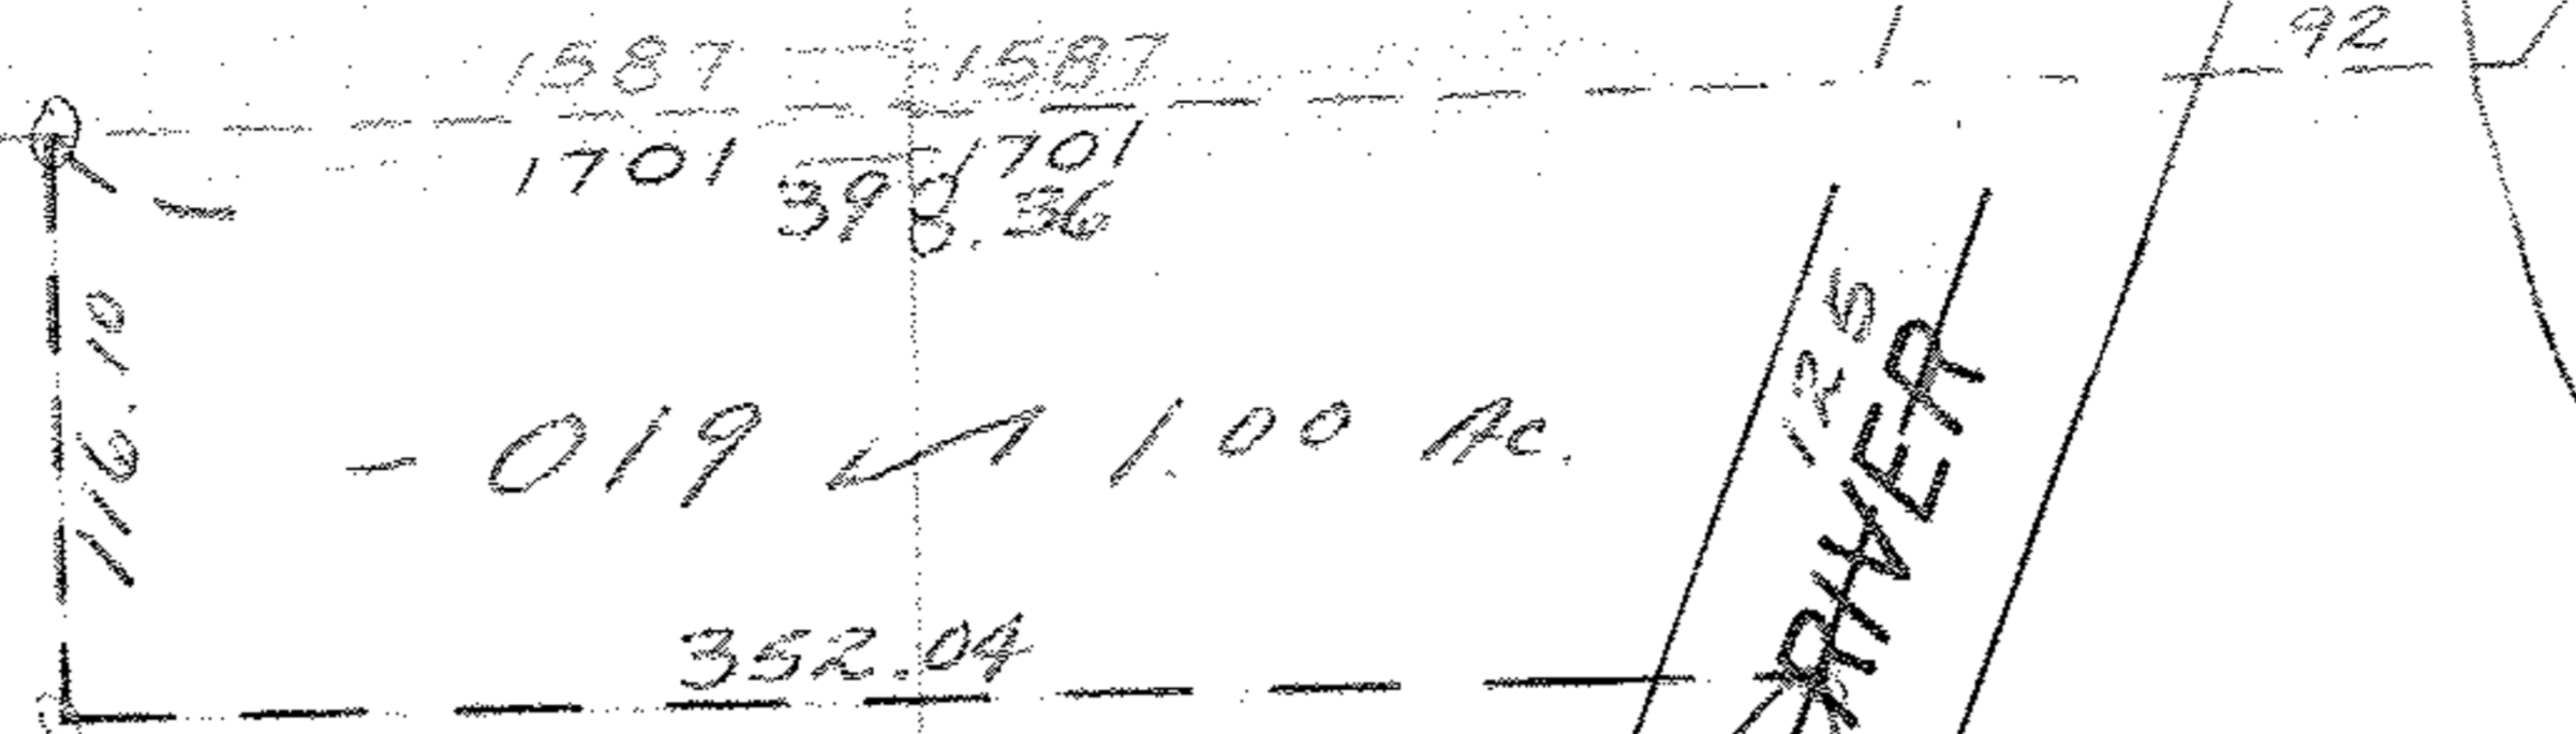

- 019 \angle 1.00 Ac.

352.04

116.10

1587 1587
1701 398.36

WEST RIVER

WEST RIVER

COLUMBIA

6039.80

92