

SEE 4-0


7848

~~-015~~
5.78A.

-039
5.74 AC.

-038
.04 AC.

205
910-10
50

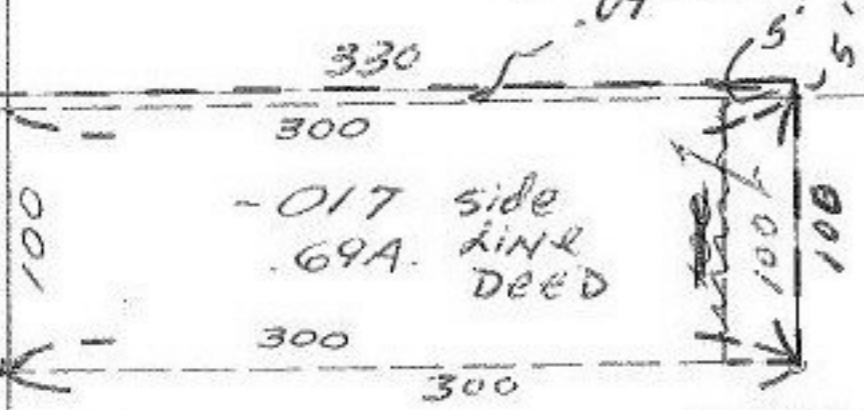

-017 side
.69A. line
DEED

1228.24

103

7848

APPROVED
LORAIN CO.
MAP DEPT.

-016
5.09A. **OK**

DATE 3-29-74

PAGE 4-00-026-A.

BY Paul

NOTE:
MAP CORRECTION
OF -017. IT IS A
SIDE LINE DEED
P.R. DEED VOL'S.

1034.43

V. 915 P. 402
V. 804 P. 234-018
1.90A.
O.R. Smith

1034.56

-019
1.90A.

1034.54

300
-020
.55A.

334.54

80

320

-021
.55A.

-022
.55A.

7-7-18-12-6

89° 10' 00"

80