

#7851

~~Pt. 040~~
~~Pt. 79.30 A~~

102

Pt - 045
Pt 77.30 AC.

Change Number
& Approye on page


SEE 7-H A

OK

#7851

APPROVED LORAIN CO. MAP DEPT.
DATE 4-2-74
PAGE 7-00-012-14 * 7-H
BY Paul
VOID AFTER

7-31-81

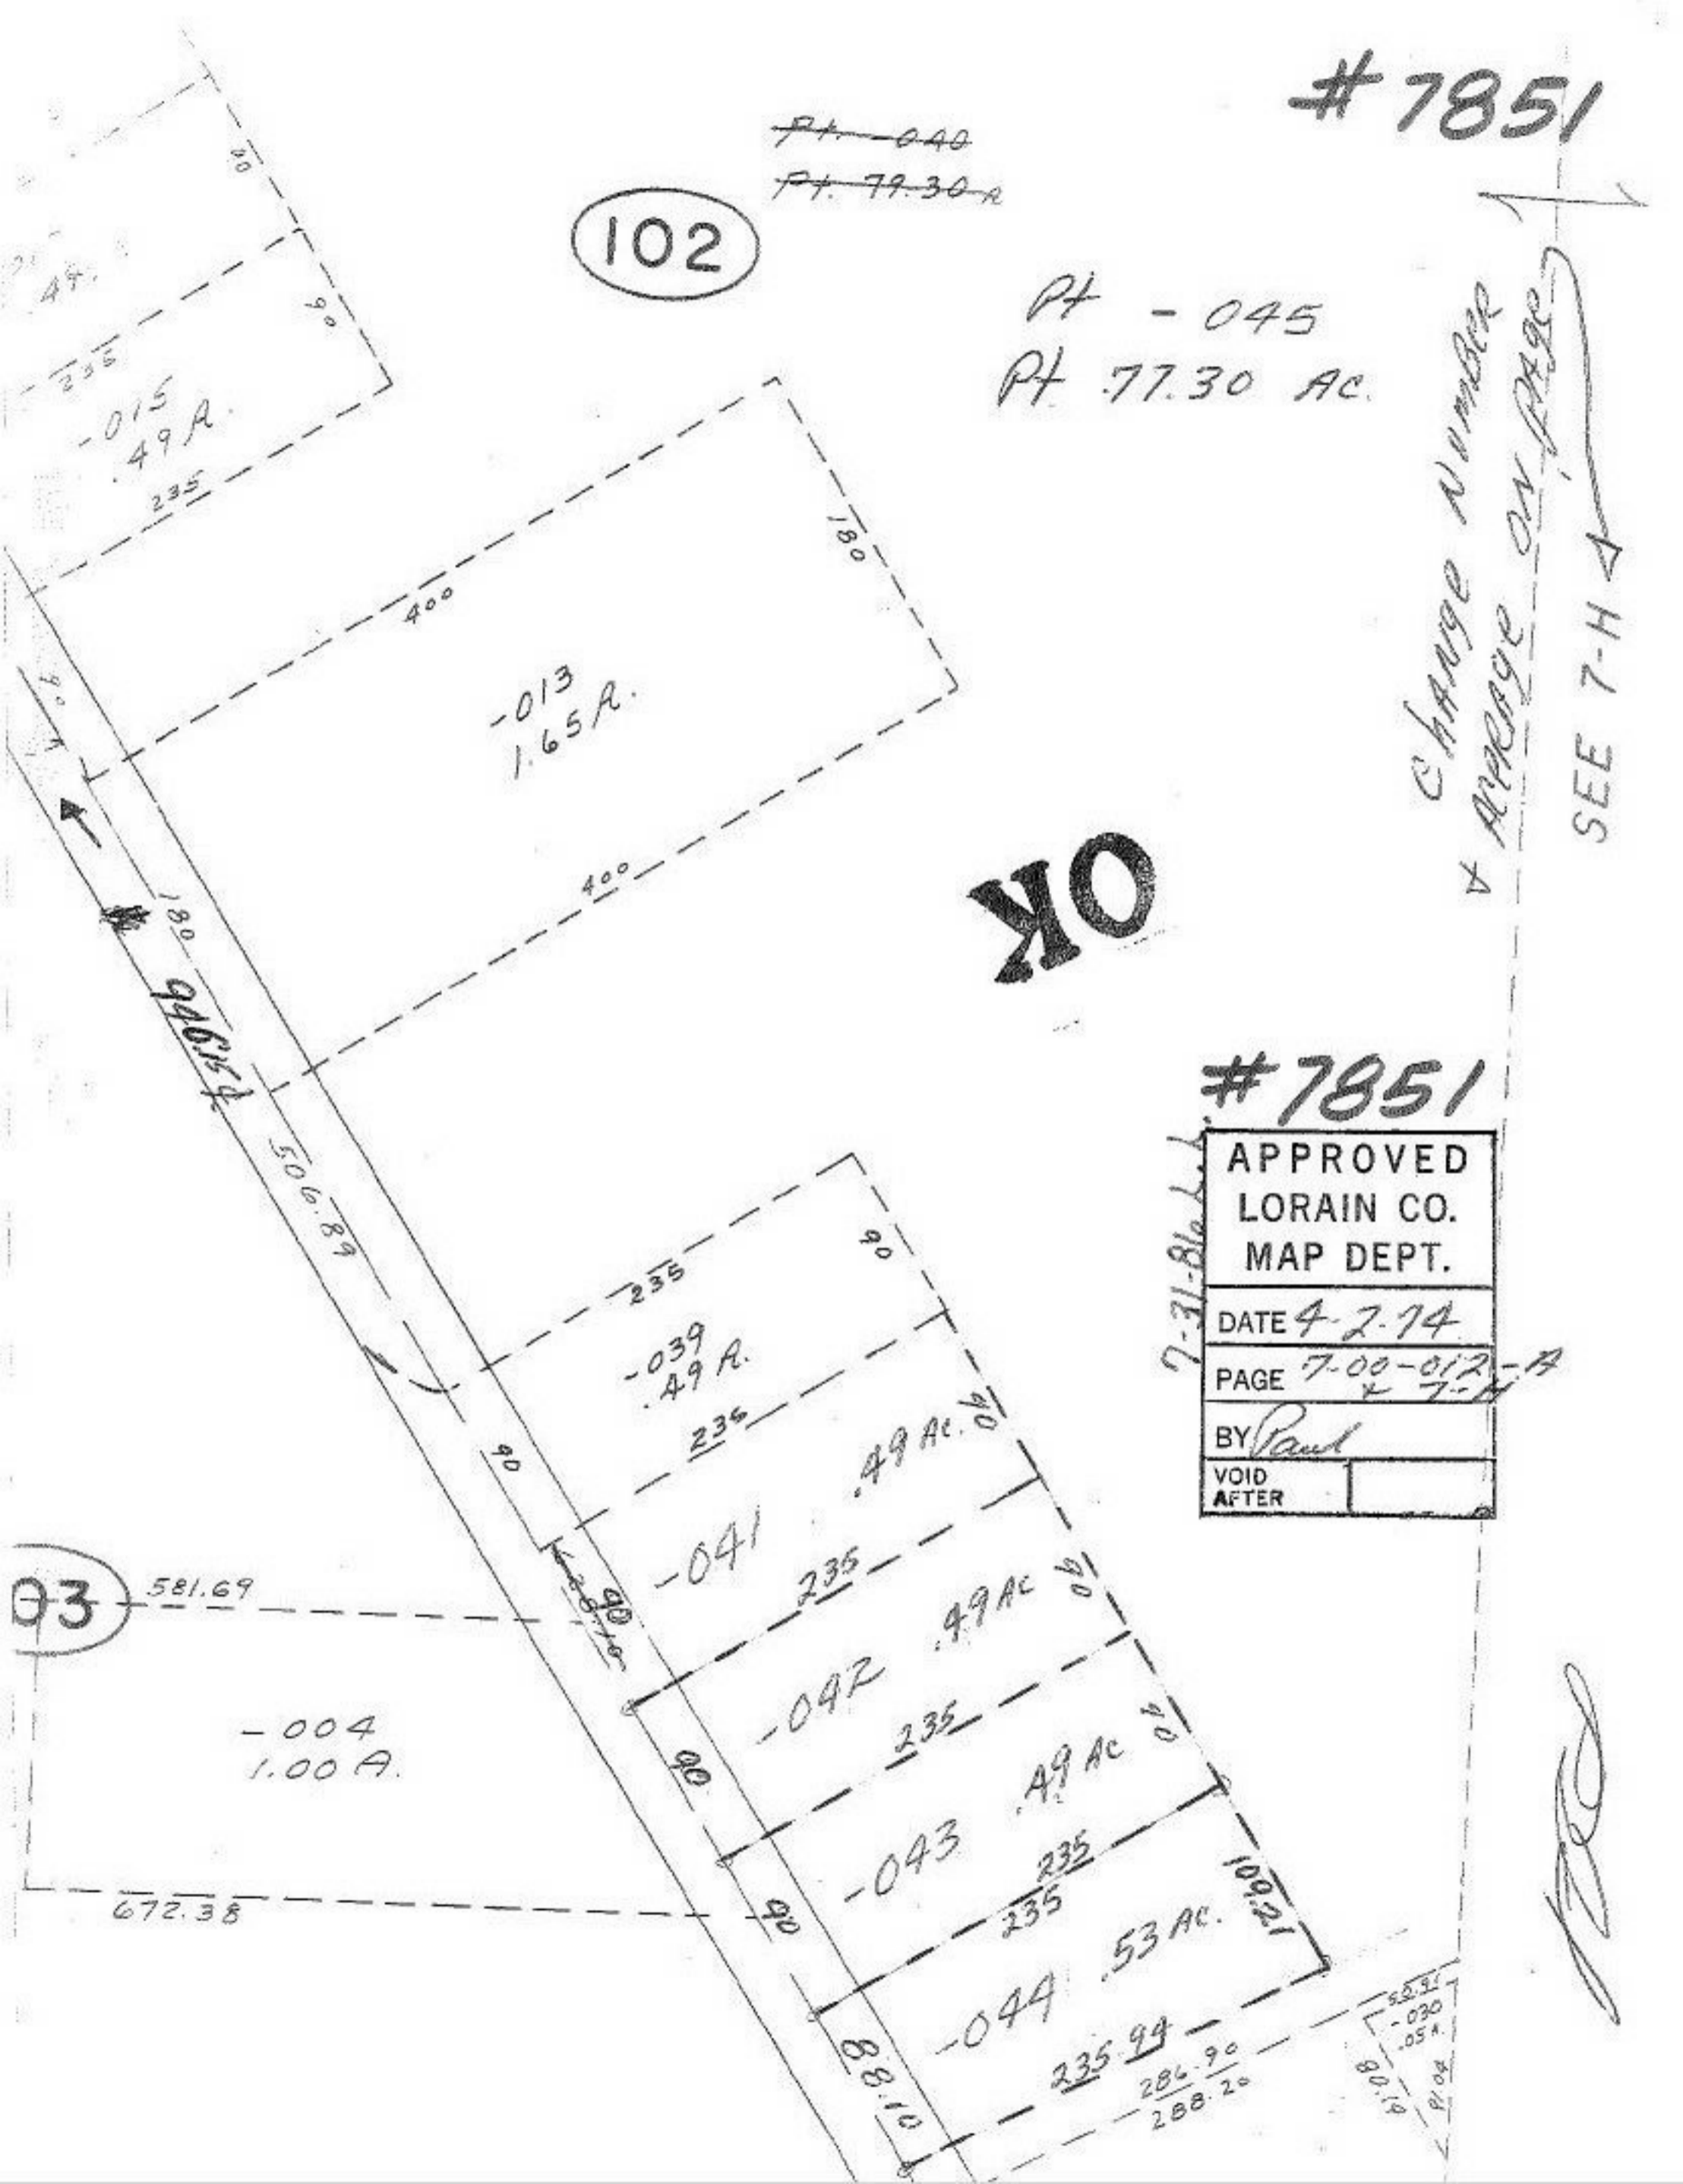

[Handwritten signature]