


#7853

Old

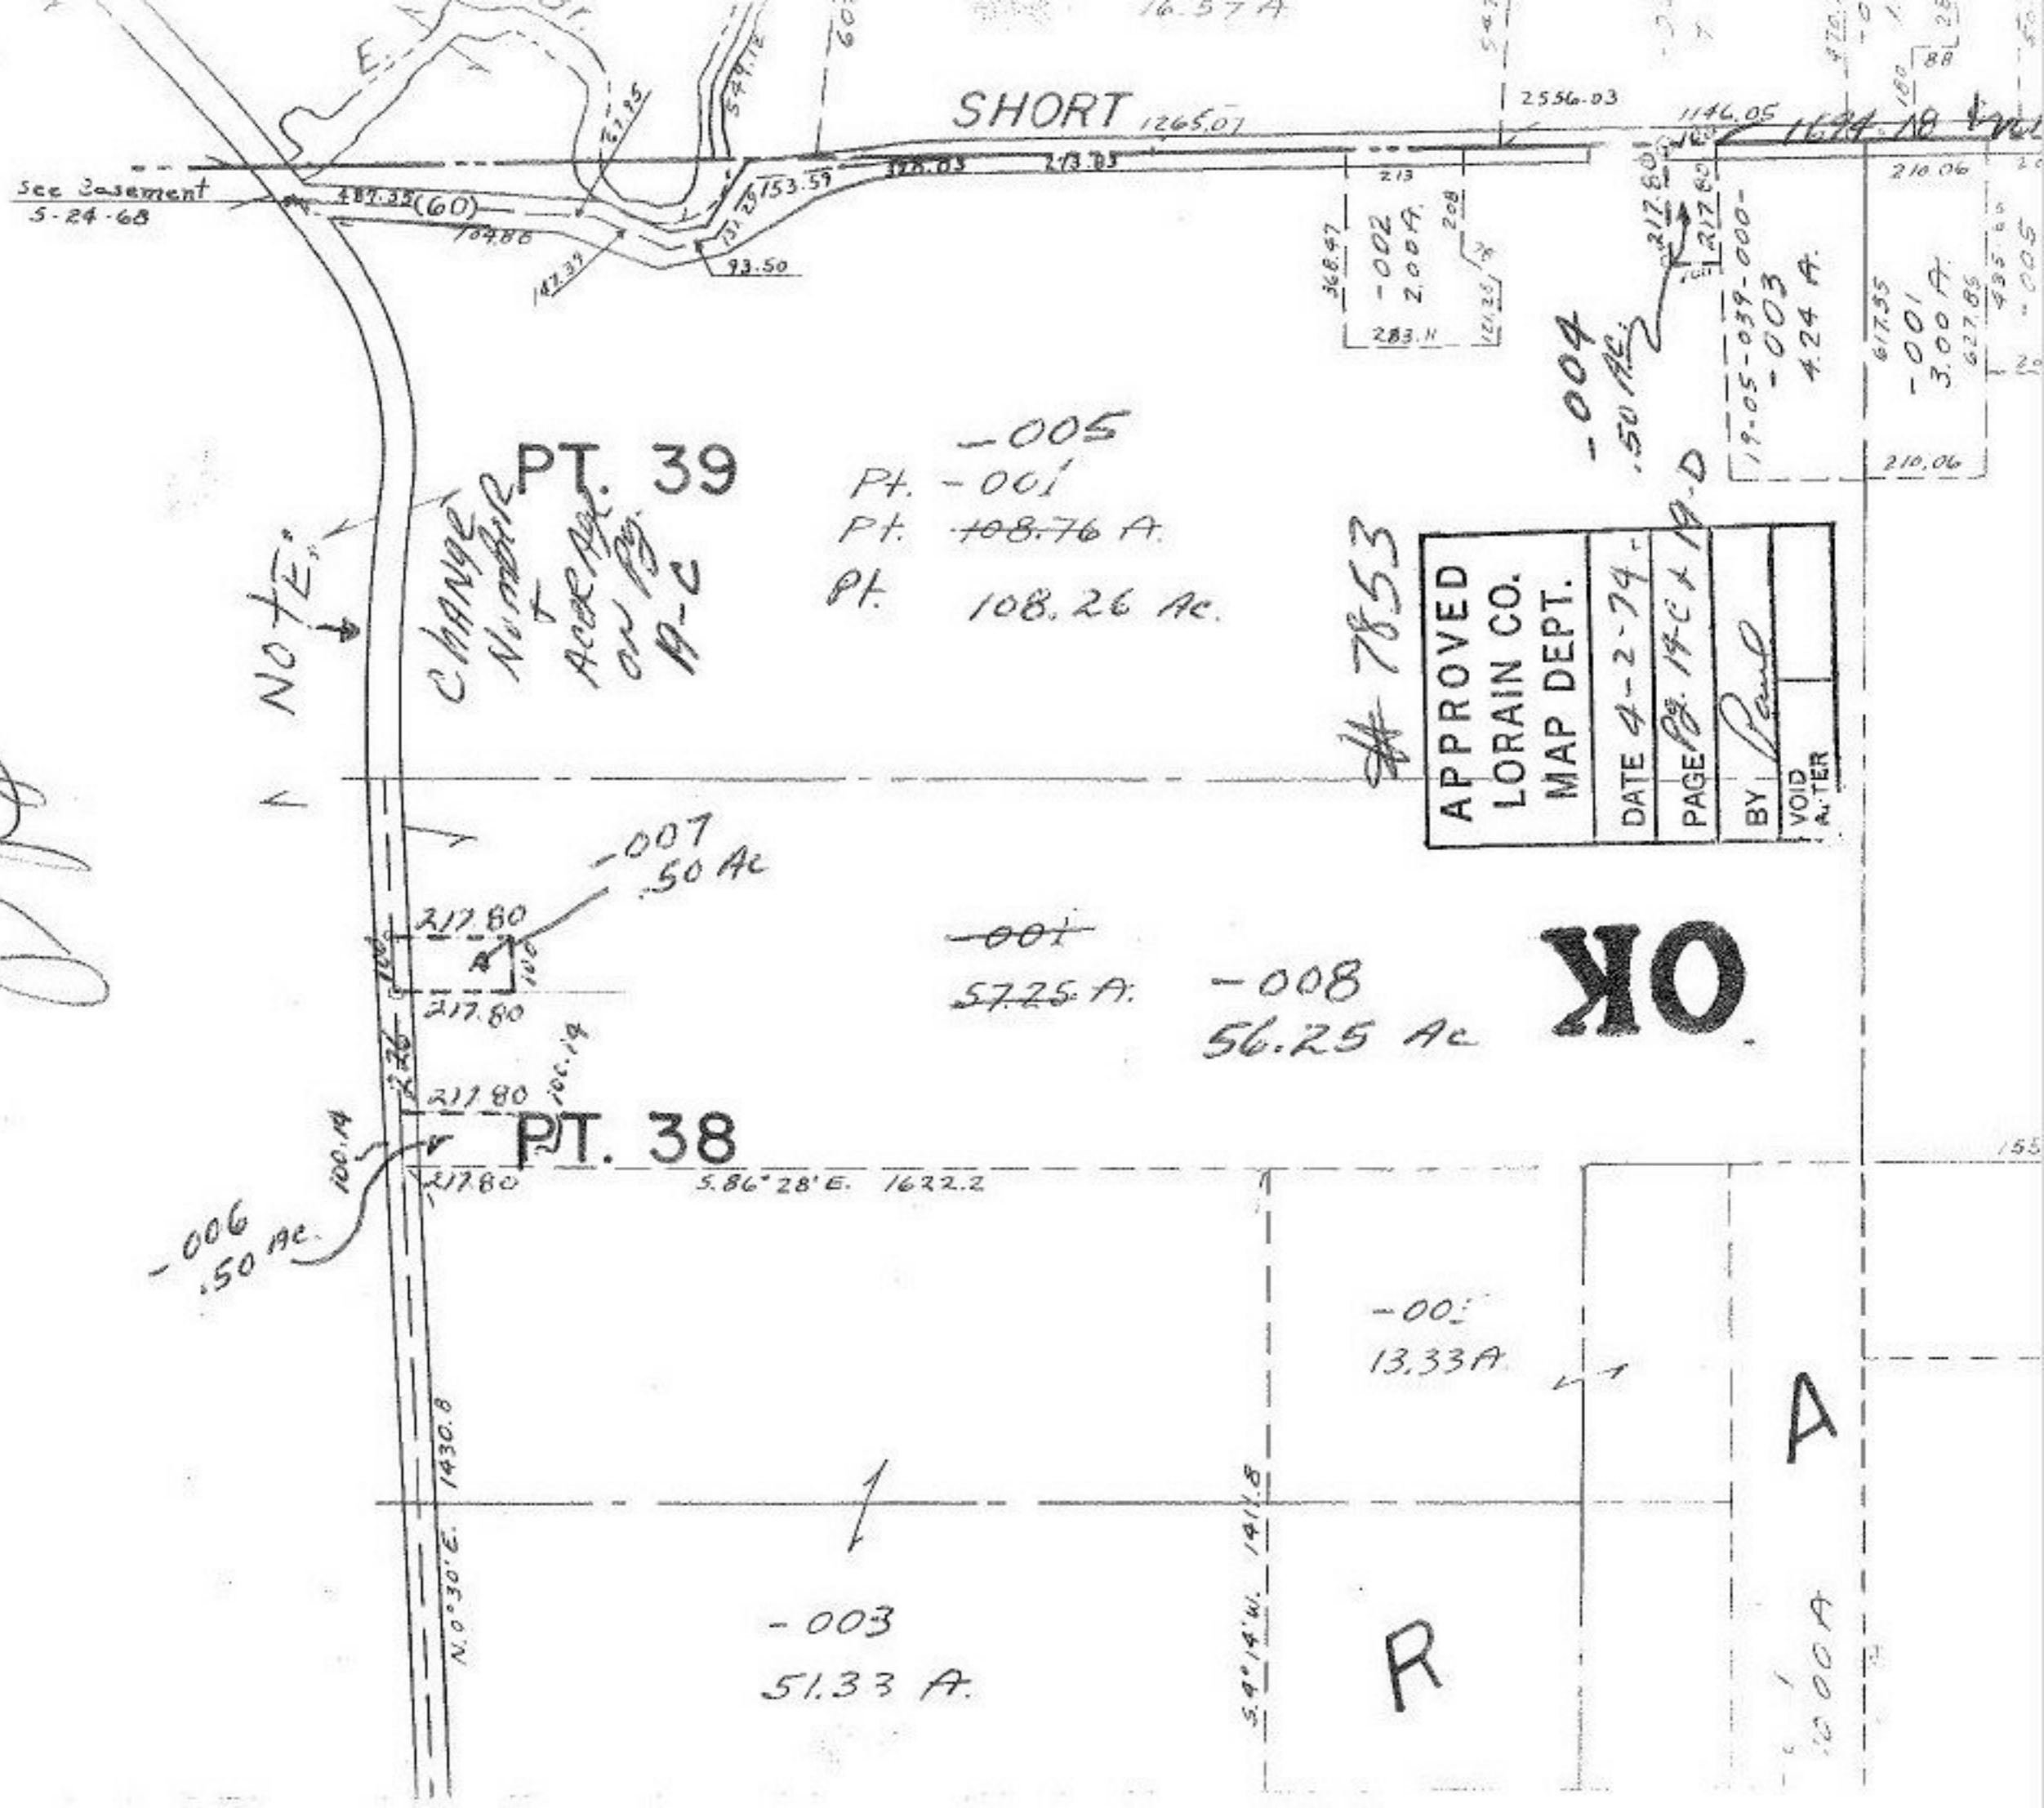

See Basement
5-24-68

NOTE

CHANGE
Number
ACER AGE
ON PG.
M-C
PT. 39

-005
Pt. -001
Pt. 108.76 A.
Pt. 108.26 Ac.

-007
50 Ac

-001
57.25 A.
-008
56.25 Ac

PT. 38

-006
50 Ac

-005
13.33 A.

-003
51.33 A.

R

A

1000 A

OK

#7853

APPROVED
LORAIN CO.
MAP DEPT.
DATE 4-2-74
PAGE PG. 19-C X 19-D
BY Paul
VOID AFTER

368.97
-002
2.00 A.
283.11

-004
.50 AC

19-05-039-000-
-003
4.24 A.

617.55
-001
3.00 A.
627.85

SHORT 1265.07

2556.03

1146.05

1624.10

N.0°30'E. 1430.8

S.86°28'E. 1622.2

S.9°14'W. 1411.8

487.32 (60)

107.86

147.39

93.50

60

574.72

E.1.95

16.57 A

5.47

7

470

100

88

20

210.06

210.06

155