


7859

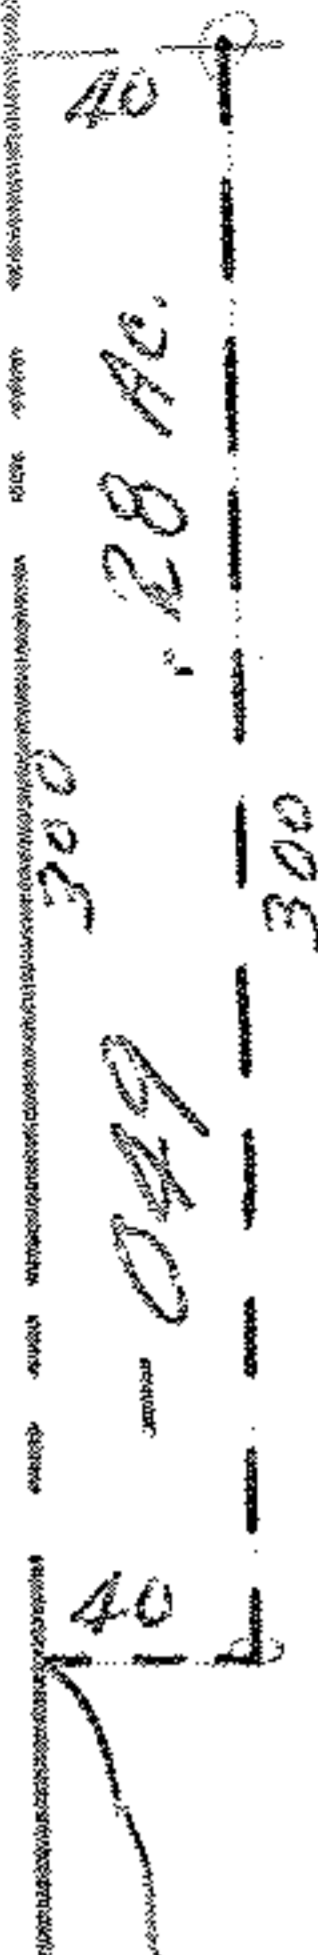

PR

OK

7859

APPROVED. LORAIN CO. MAP DEPT.	
DATE	4-4-74
PAGE	7-00-047-C & 7-E
BY	<i>Paul</i>
VOID AFTER	

7-31-86

[Handwritten signature]

2390

*Pt - 050
Pt. 34.72 Ac.*

*Note:
Charge number
& acreage
on pg. E*

*000
00000*

004