

7872

7/1.30

PR

OK

-036


14.89 A.

YV

7872

APPROVED
LORAIN CO.
MAP DEPT.
DATE 4-9-74
PAGE 10-00-025-F
BY Paul
VOID

1872

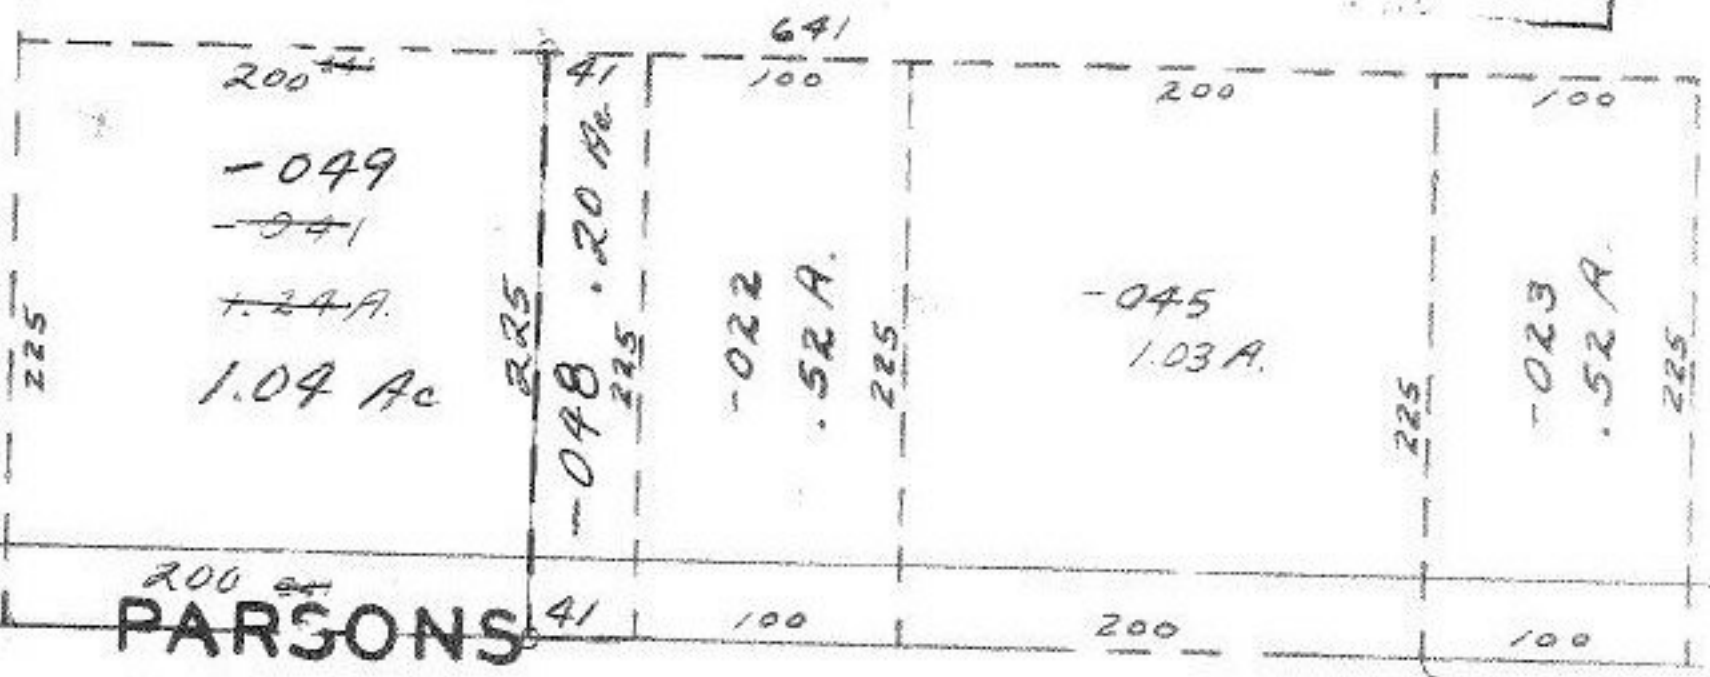

SEE 15-D