


COB

014

~~012~~

29.05 A.

25.32 A.

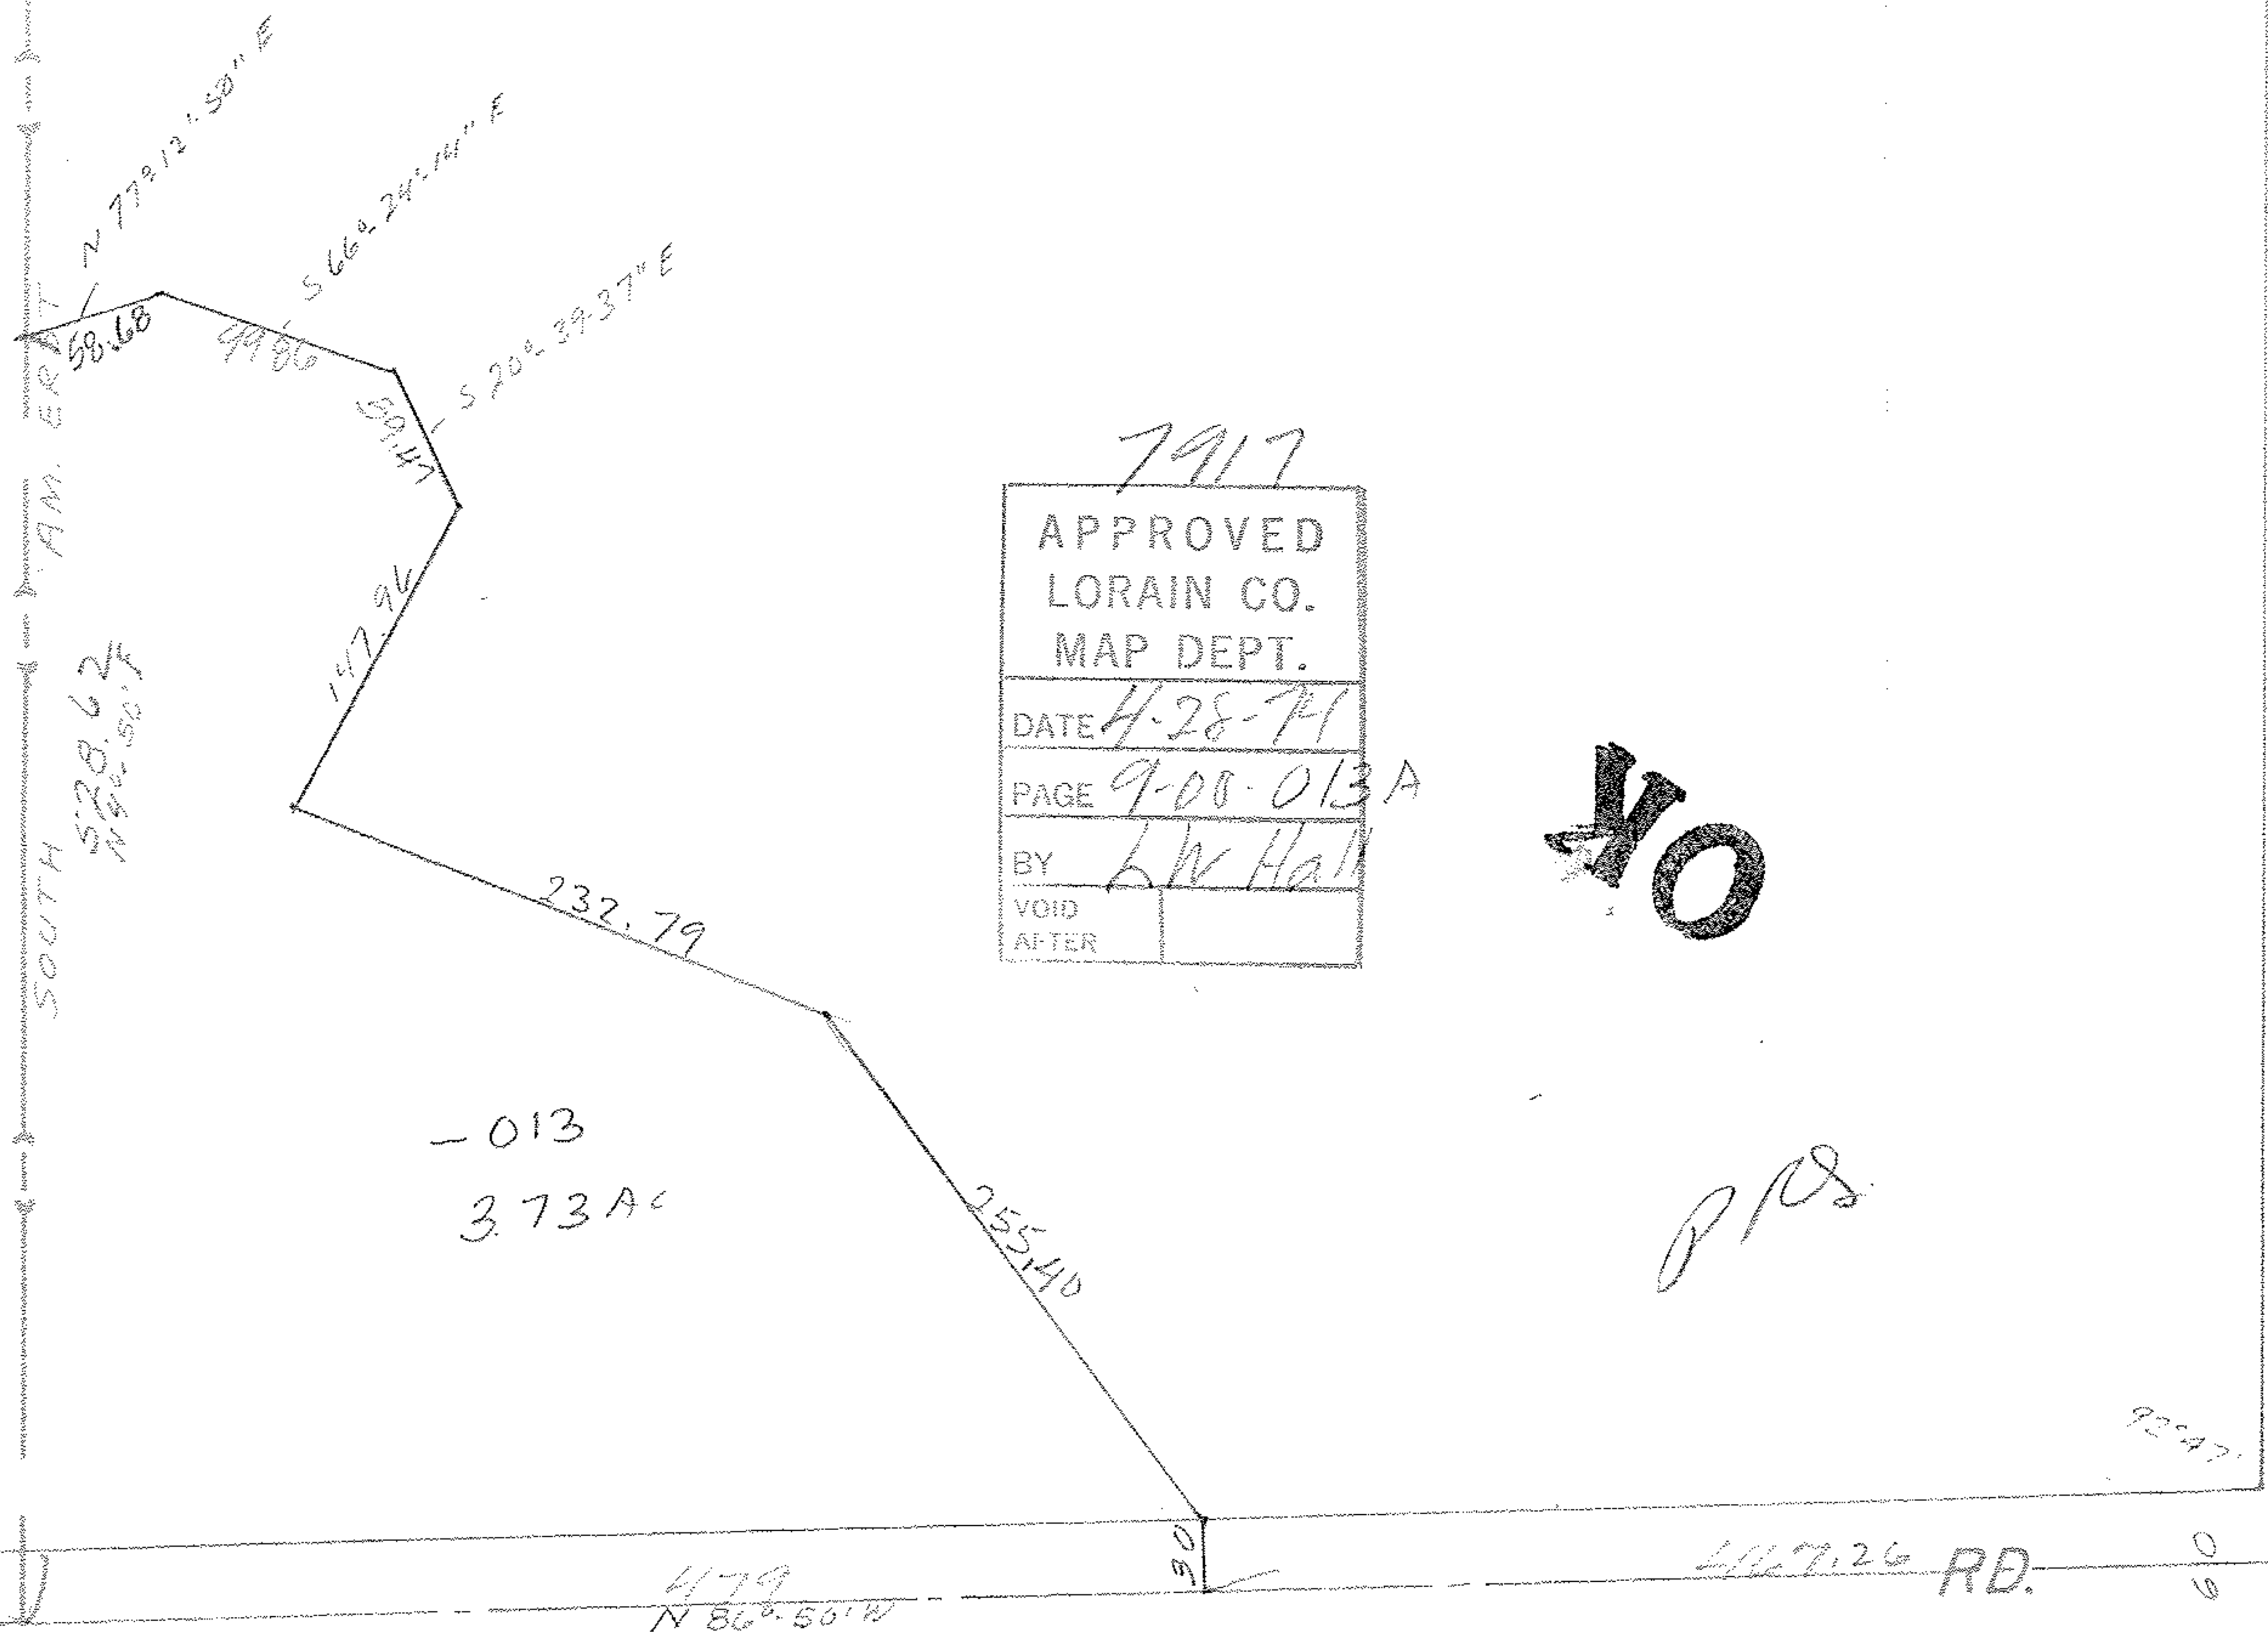

7917

APPROVED
LORAIN CO.
MAP DEPT.
DATE 4-28-71
PAGE 9-00-013A
BY L W Hall
VOID
AFTER

40

P.P.s

-013
3.73 A.

SEE 9-00-023-A

SOUTH HILLOS AMHERST