


7918

693.70

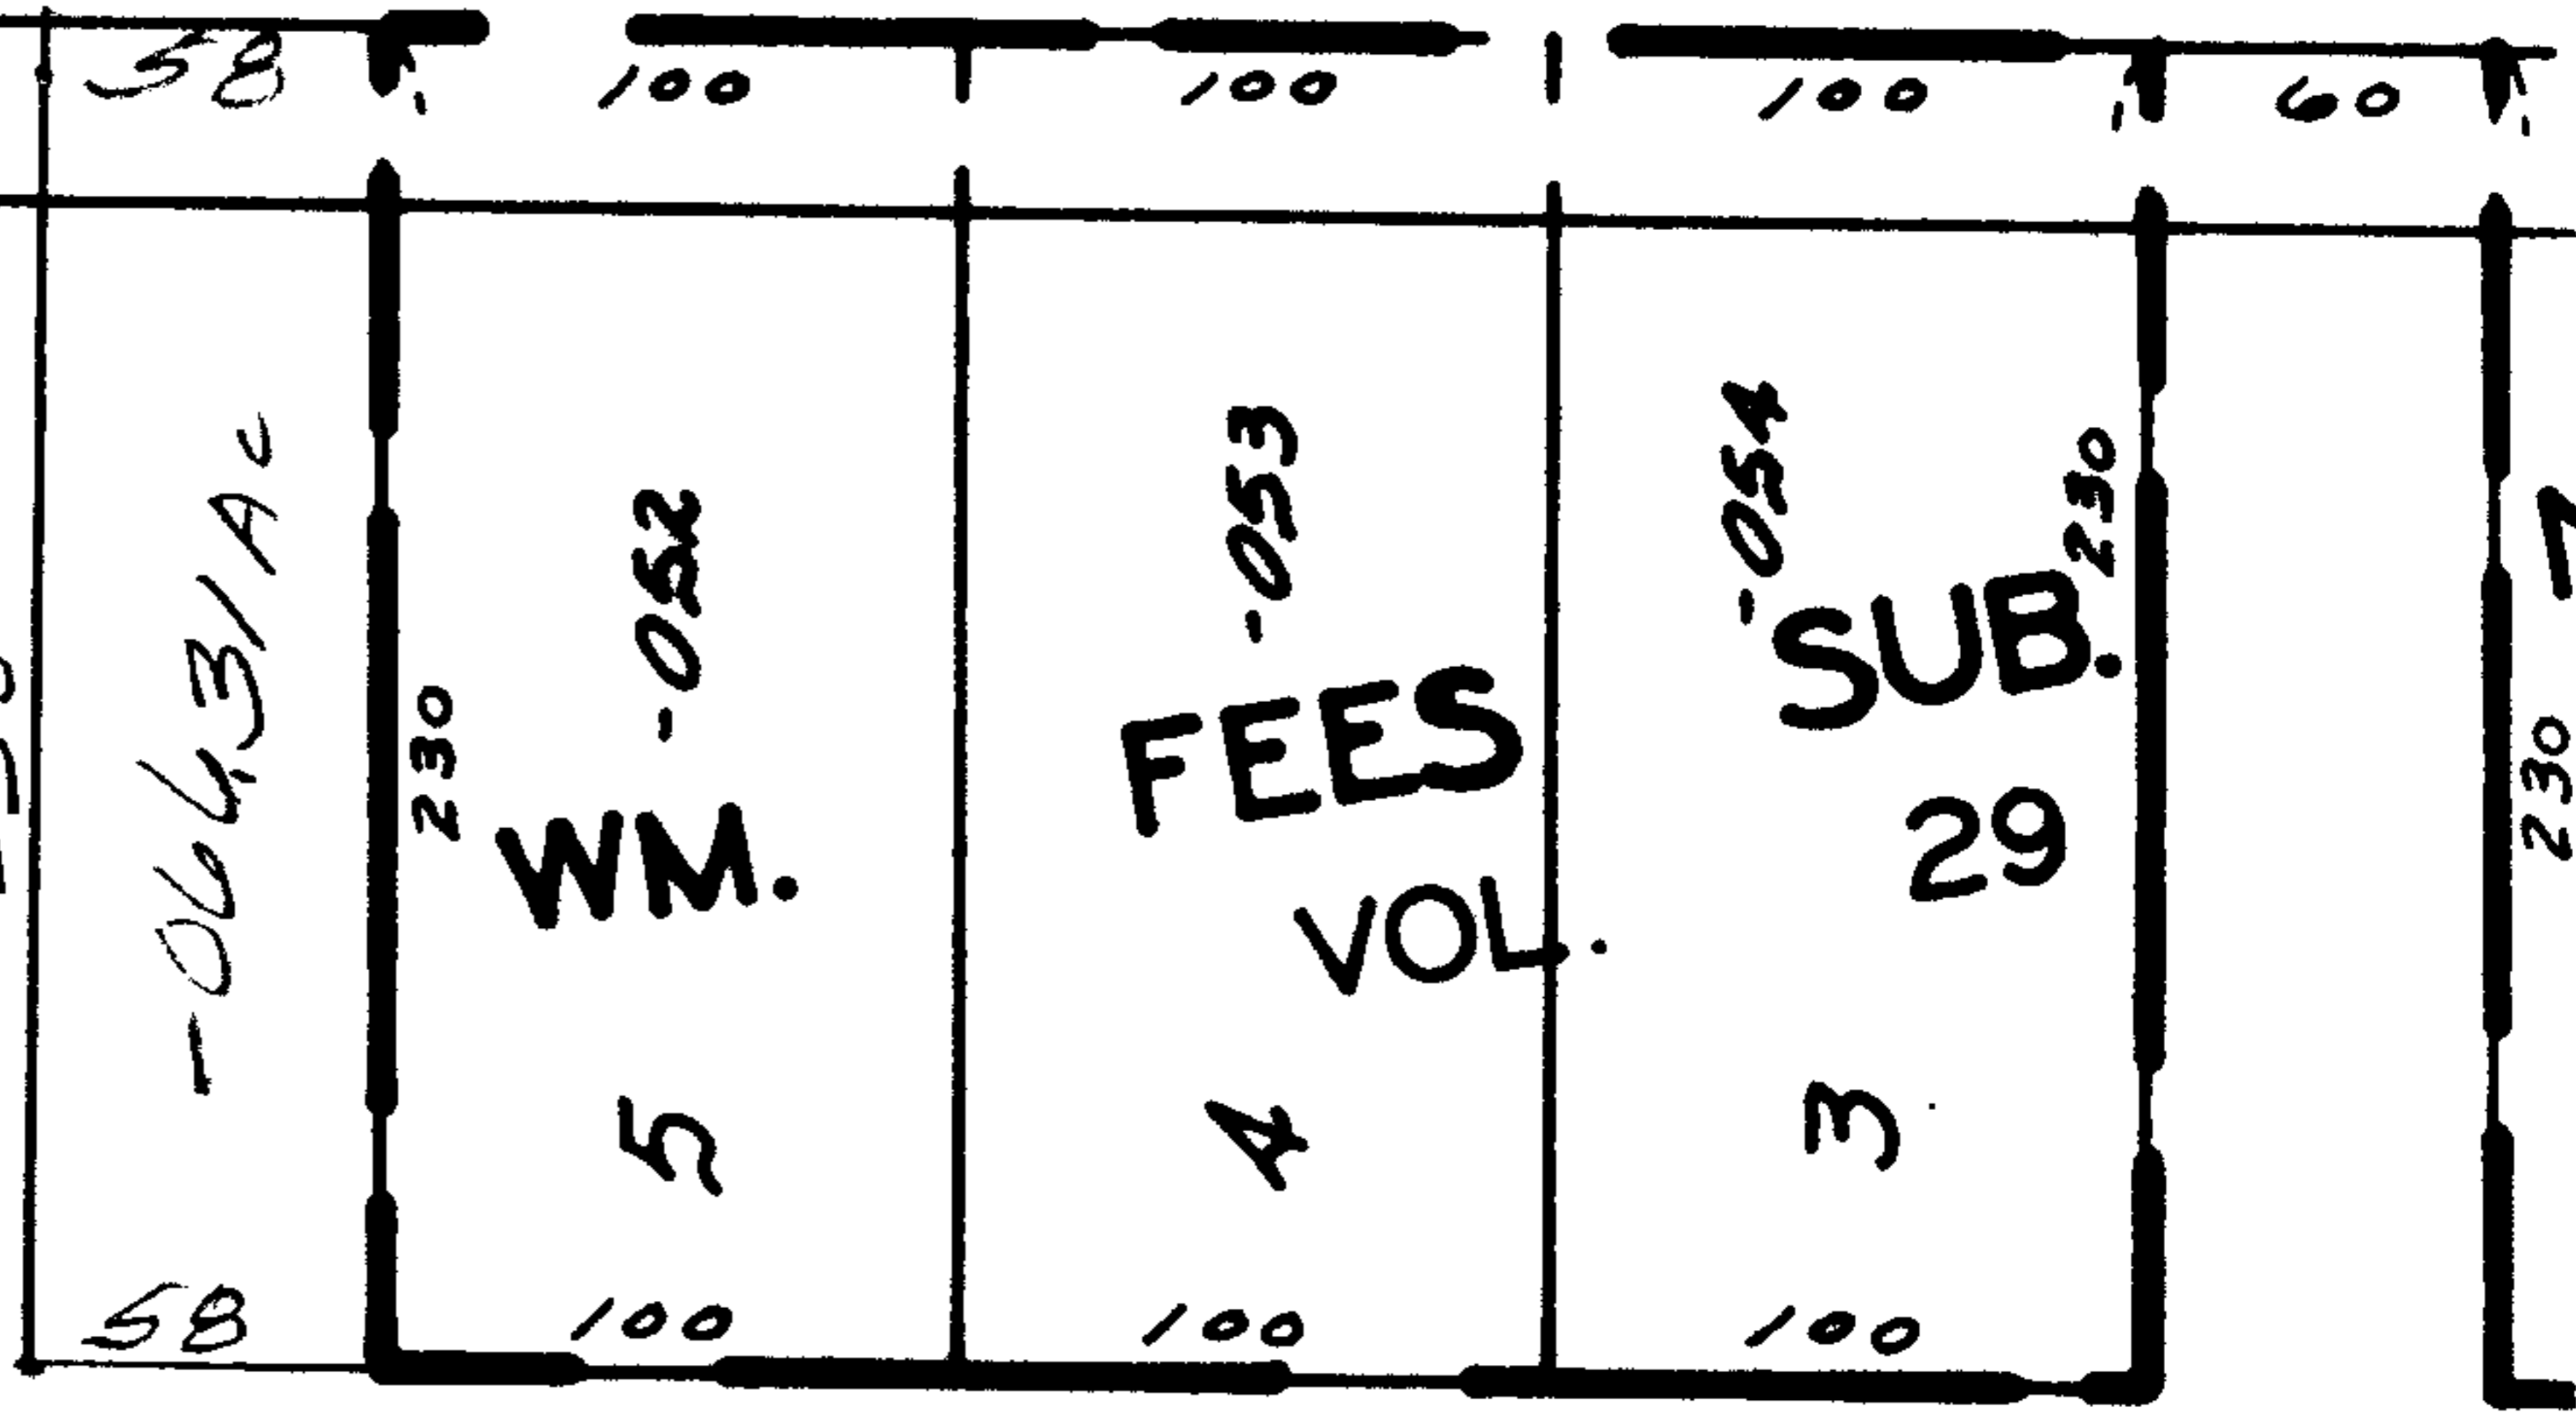

**OK**

7918

APPROVED LORAIN CO. MAP DEPT.
DATE 5-1-74
PAGE 10-00-024 B
BY H. W. Hall
VOID AFTER

8-5-56

Pt. ~~057~~

067

Pt. ~~53-59A~~

53.28 AC

Pt

Change NUMBER & ACRAGE 10-00-029-F