

7920

7920

7-31-86 L.L.


APPROVED
LORAIN CO.
MAP DEPT.

DATE 5-1-74

PAGE 4-00-007C

BY LW Hall

VOID AFTER

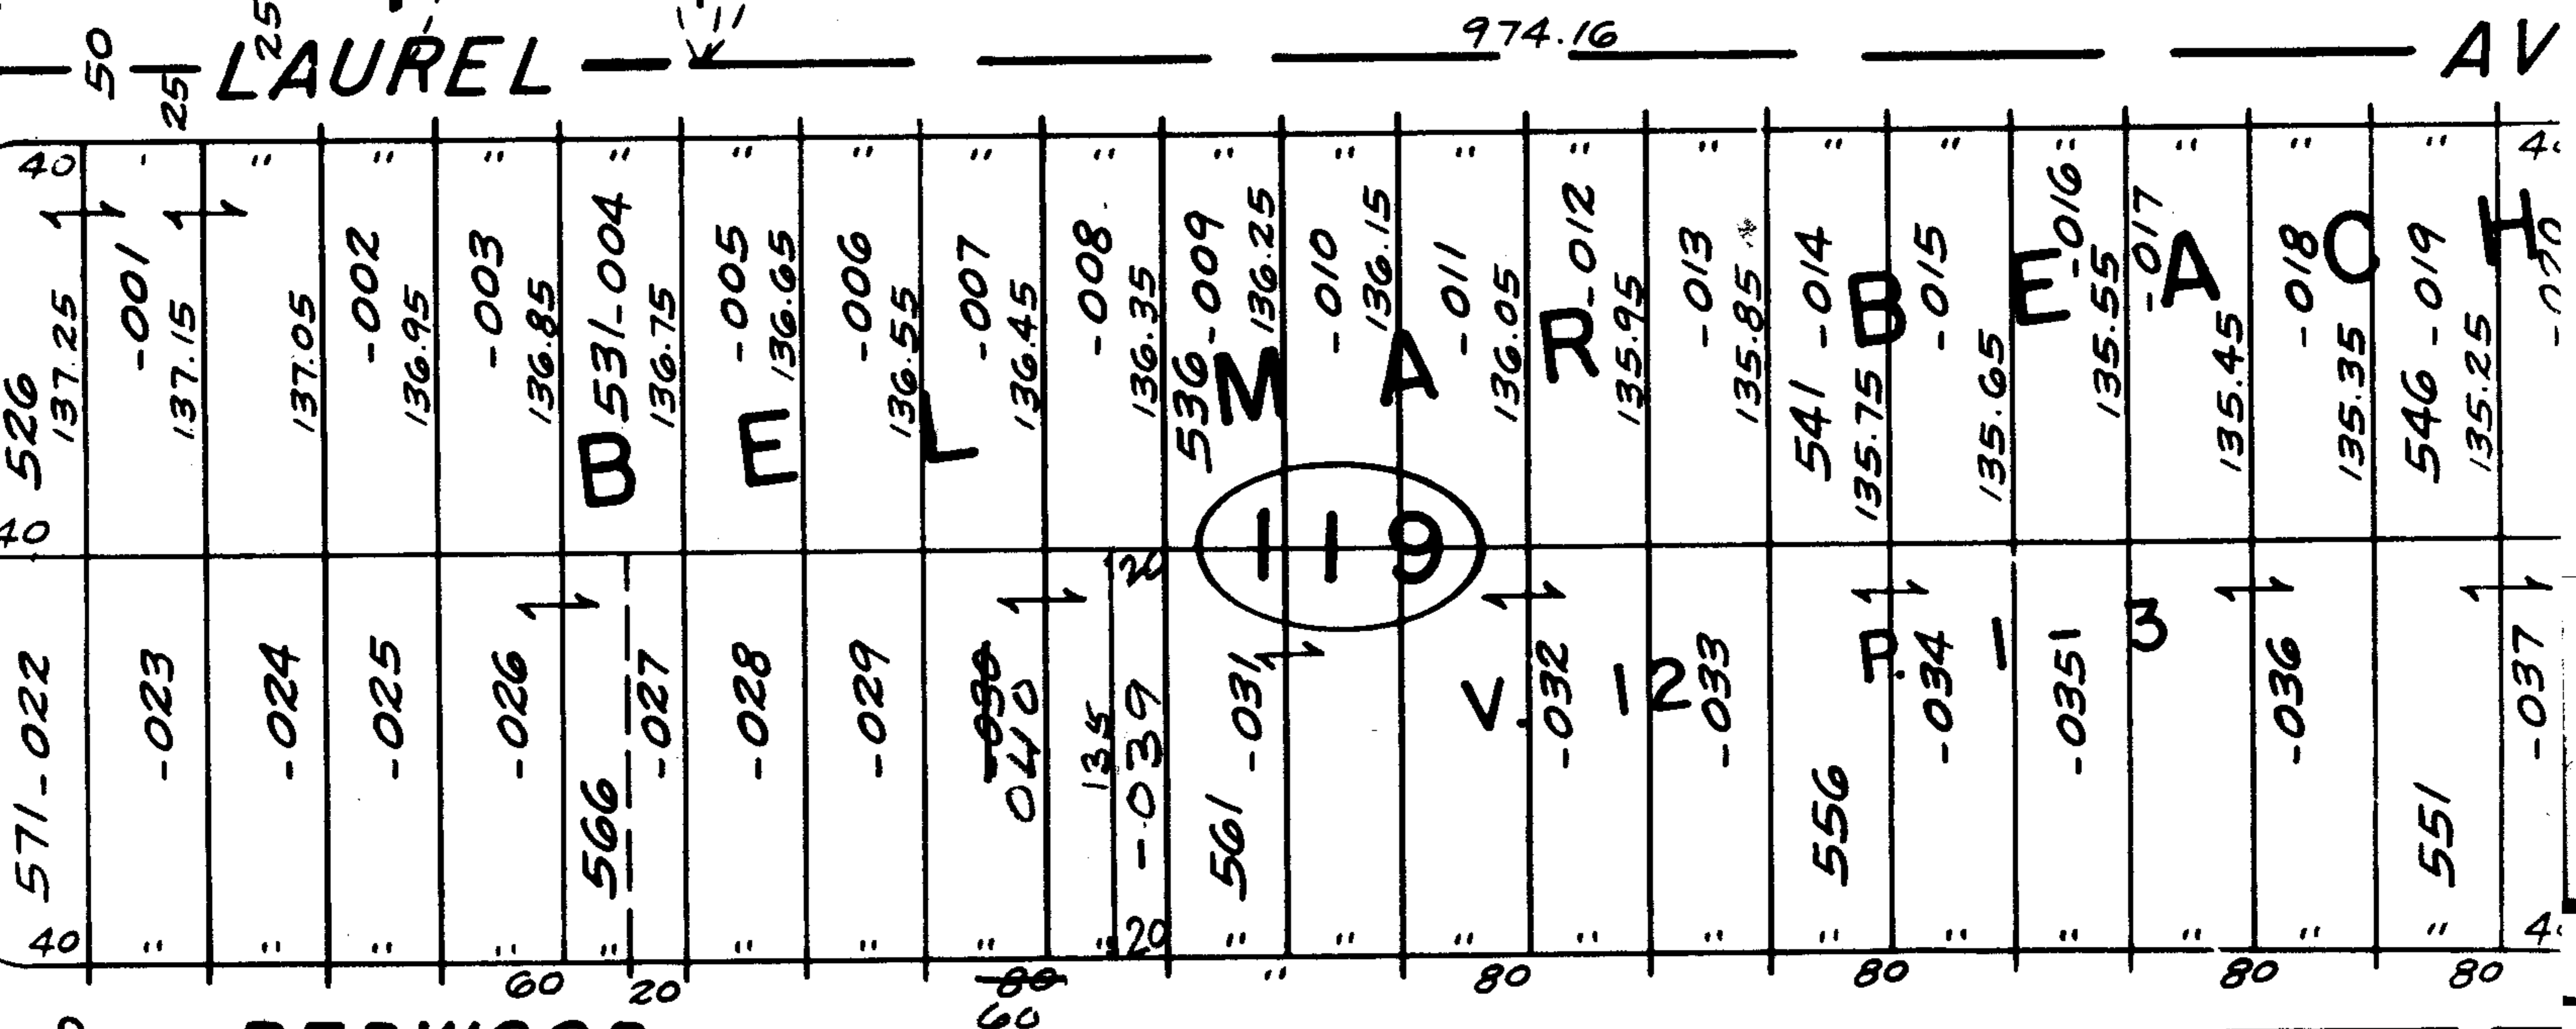

LAUREL

REDWOOD

OK

SEE 4-00-007-G

VON LAKE VILLAGE

SCALE: 1" = 100'

[Handwritten signature]

W