


7923


RD.

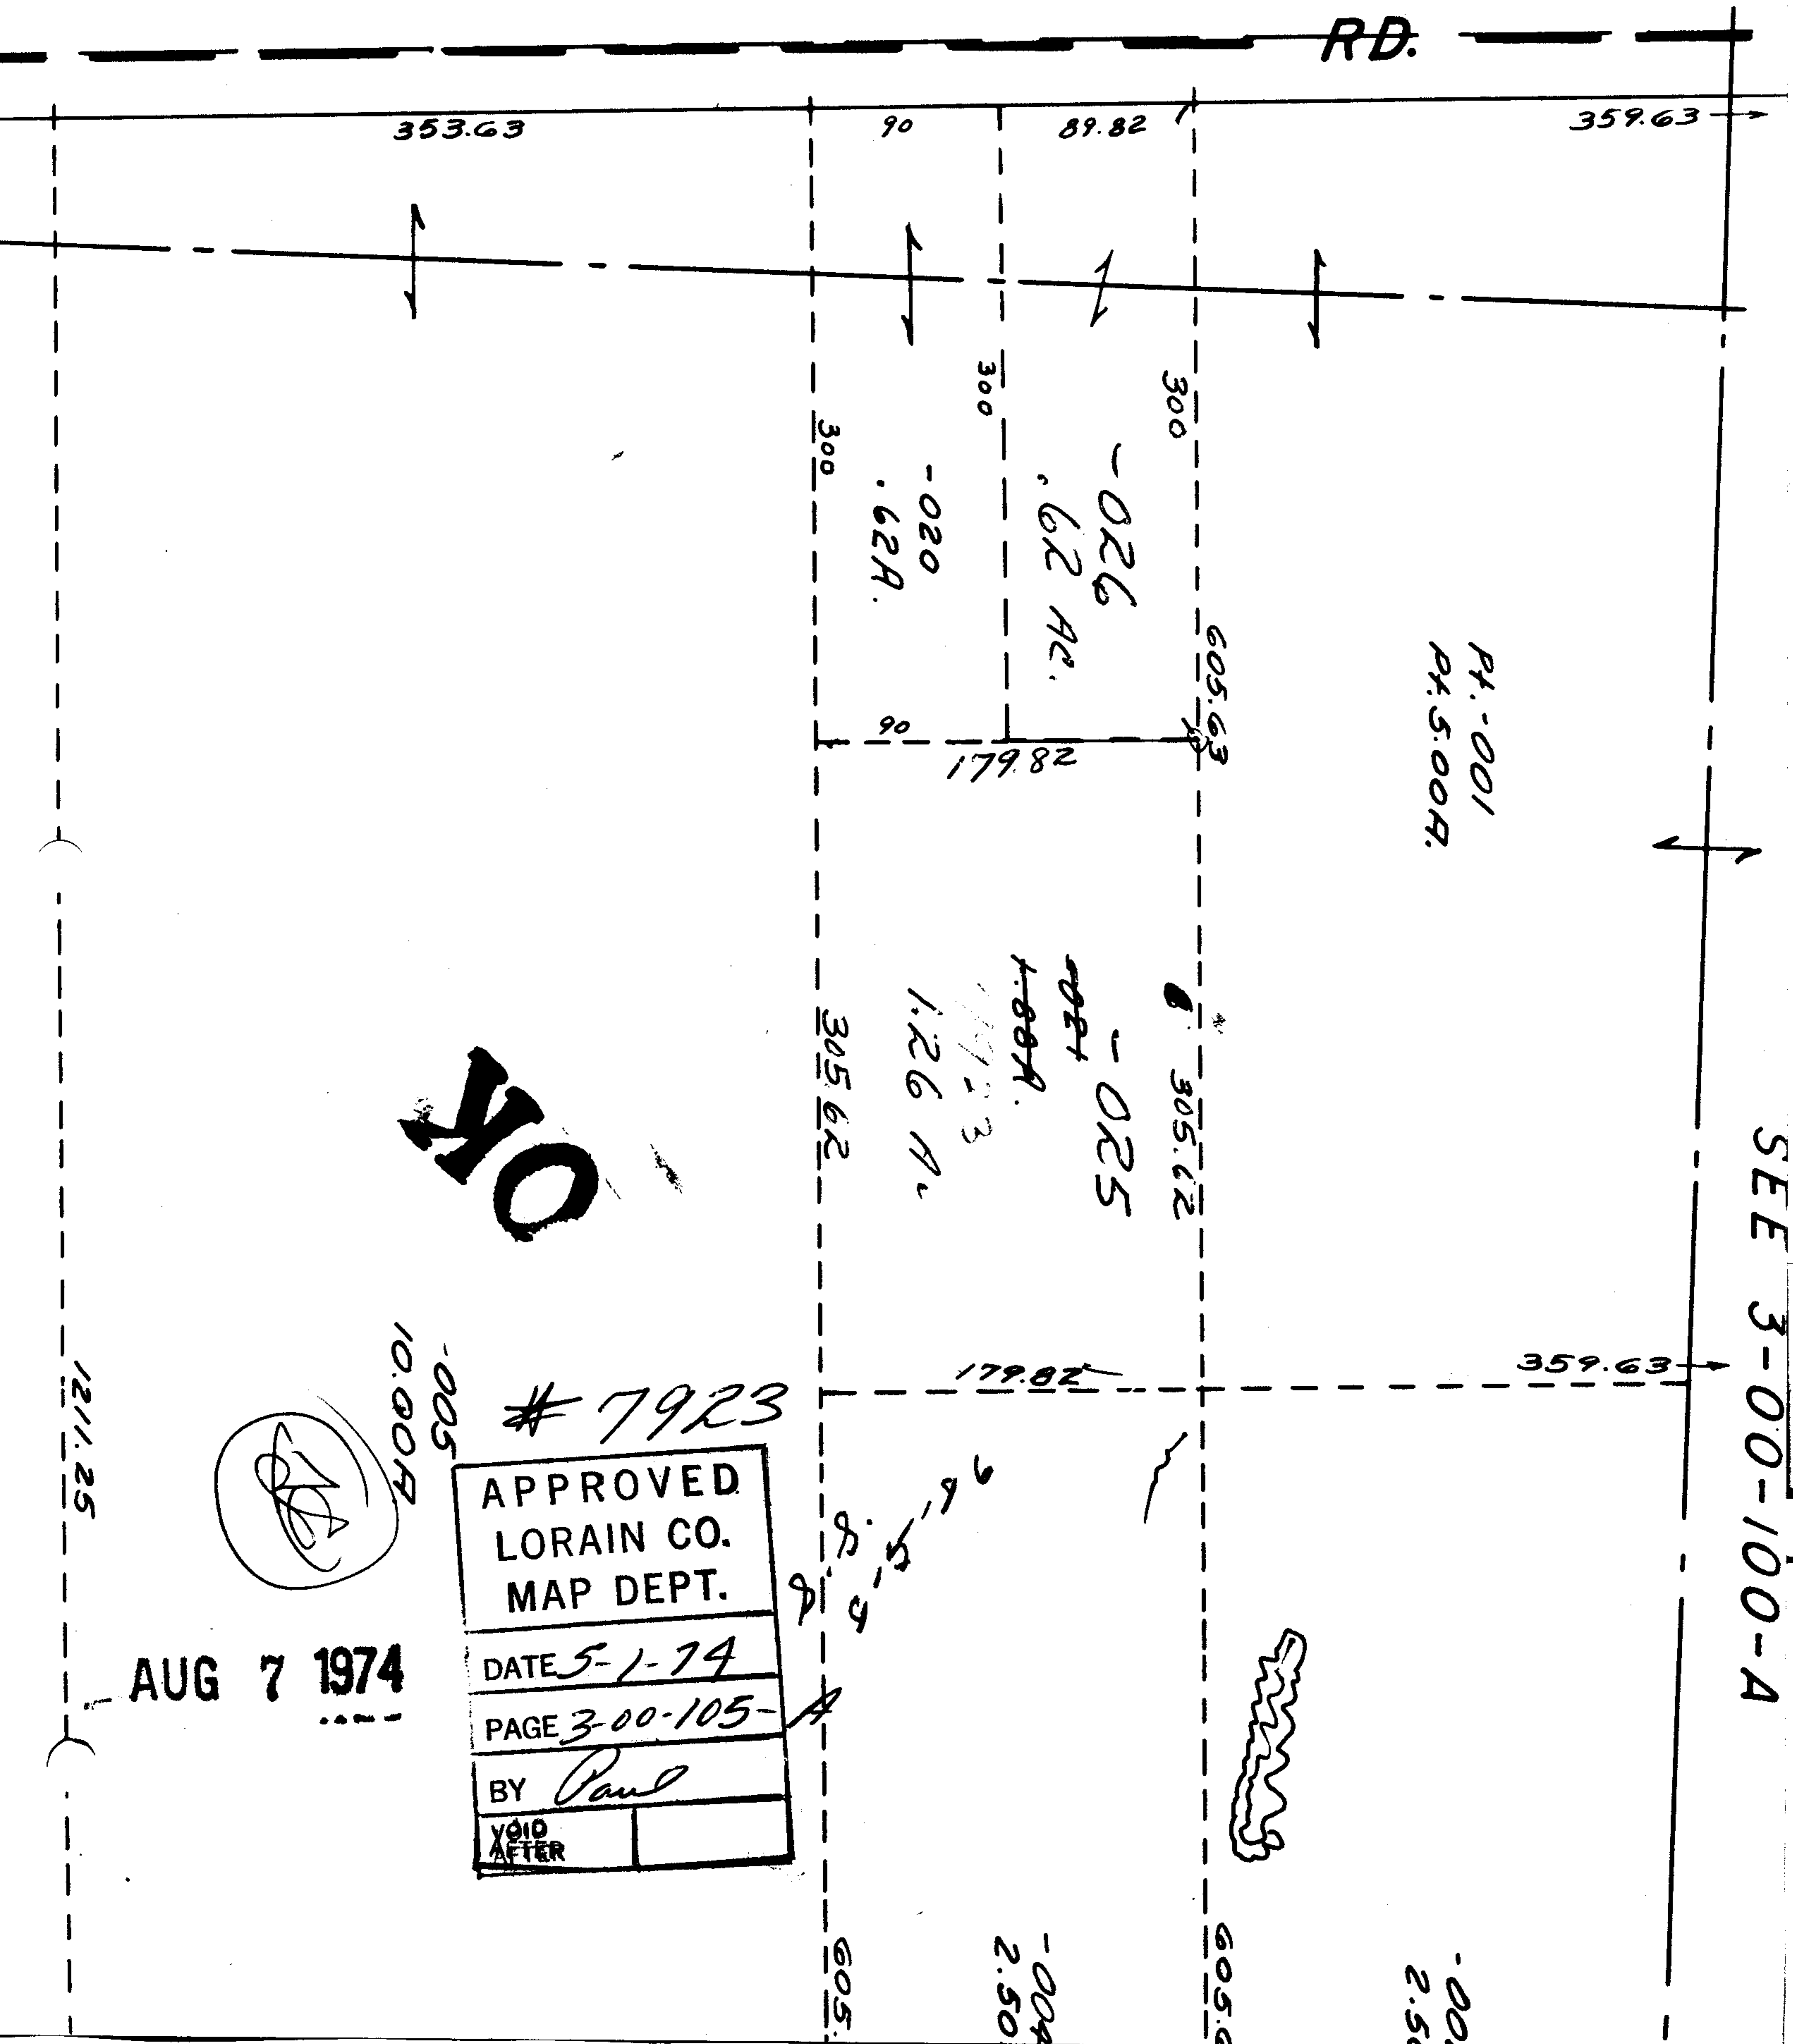

NO

7923

| | |
|-------------------------------------|--|
| APPROVED LORAIN CO. MAP DEPT. | |
| DATE 5-1-74 | |
| PAGE 3-00-105-A | |
| BY Paul | |
| VOID AFTER | |

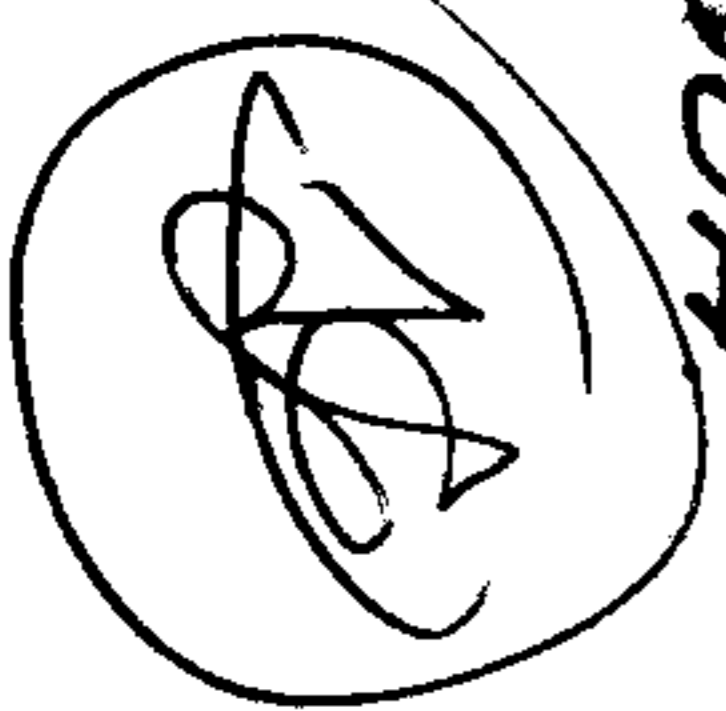

AUG 7 1974

12/1/25

-005
10.00A

SEE 3-00-100-A

Pt. -001
Pt. 5.00A.

-025

~~1.88A.~~
1.26 Ac.

-020
.62A.

-004
2.50

-002
2.50

605.

605.6

359.63

179.82

305.62

305.62

605.63

179.82

90

300

300

300

89.82

90

353.63

359.63