

2923.14 D.
2933.14

-005
18.80 A.

200x300
DU668-Pg 492
7-17-56

Pt.
Pt.

SEE 17-01

7927

1782.0

17

-017
35.50 A.

4760
4704
56

AUG 7 1974

PS

860.64

028
44A

029
46A

7927
APPROVED
LORAIN CO.
MAP DEPT.

DATE 5-2-74


PAGE 17F

BY L.W. Hall

VOID
AFTER

-026 030
47.04 A.

47.04 46.58A

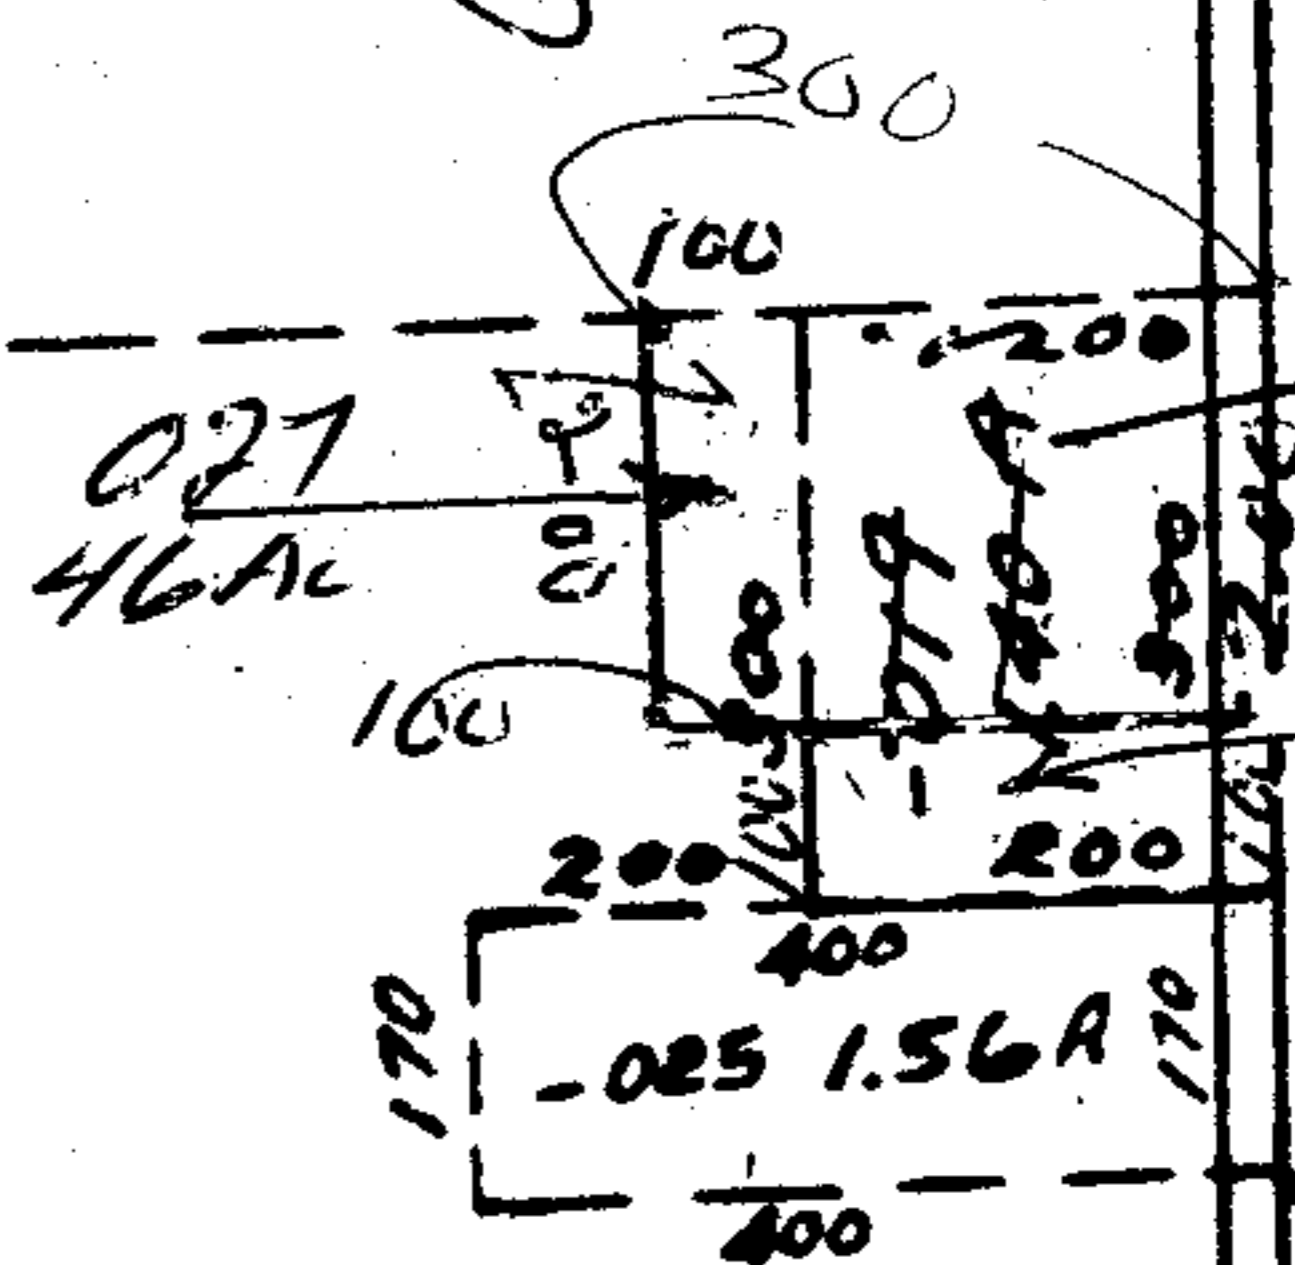

A

-006
60.00 A.

4704
46
46.58

4760
46
47.14

3186 L.L.

441.38 D.
427.0

-020
10.00 A.

48.60
1.56
47.04

2

-002
80.00 A.