


7983

SEE 15-00-045-B

303

MAIN

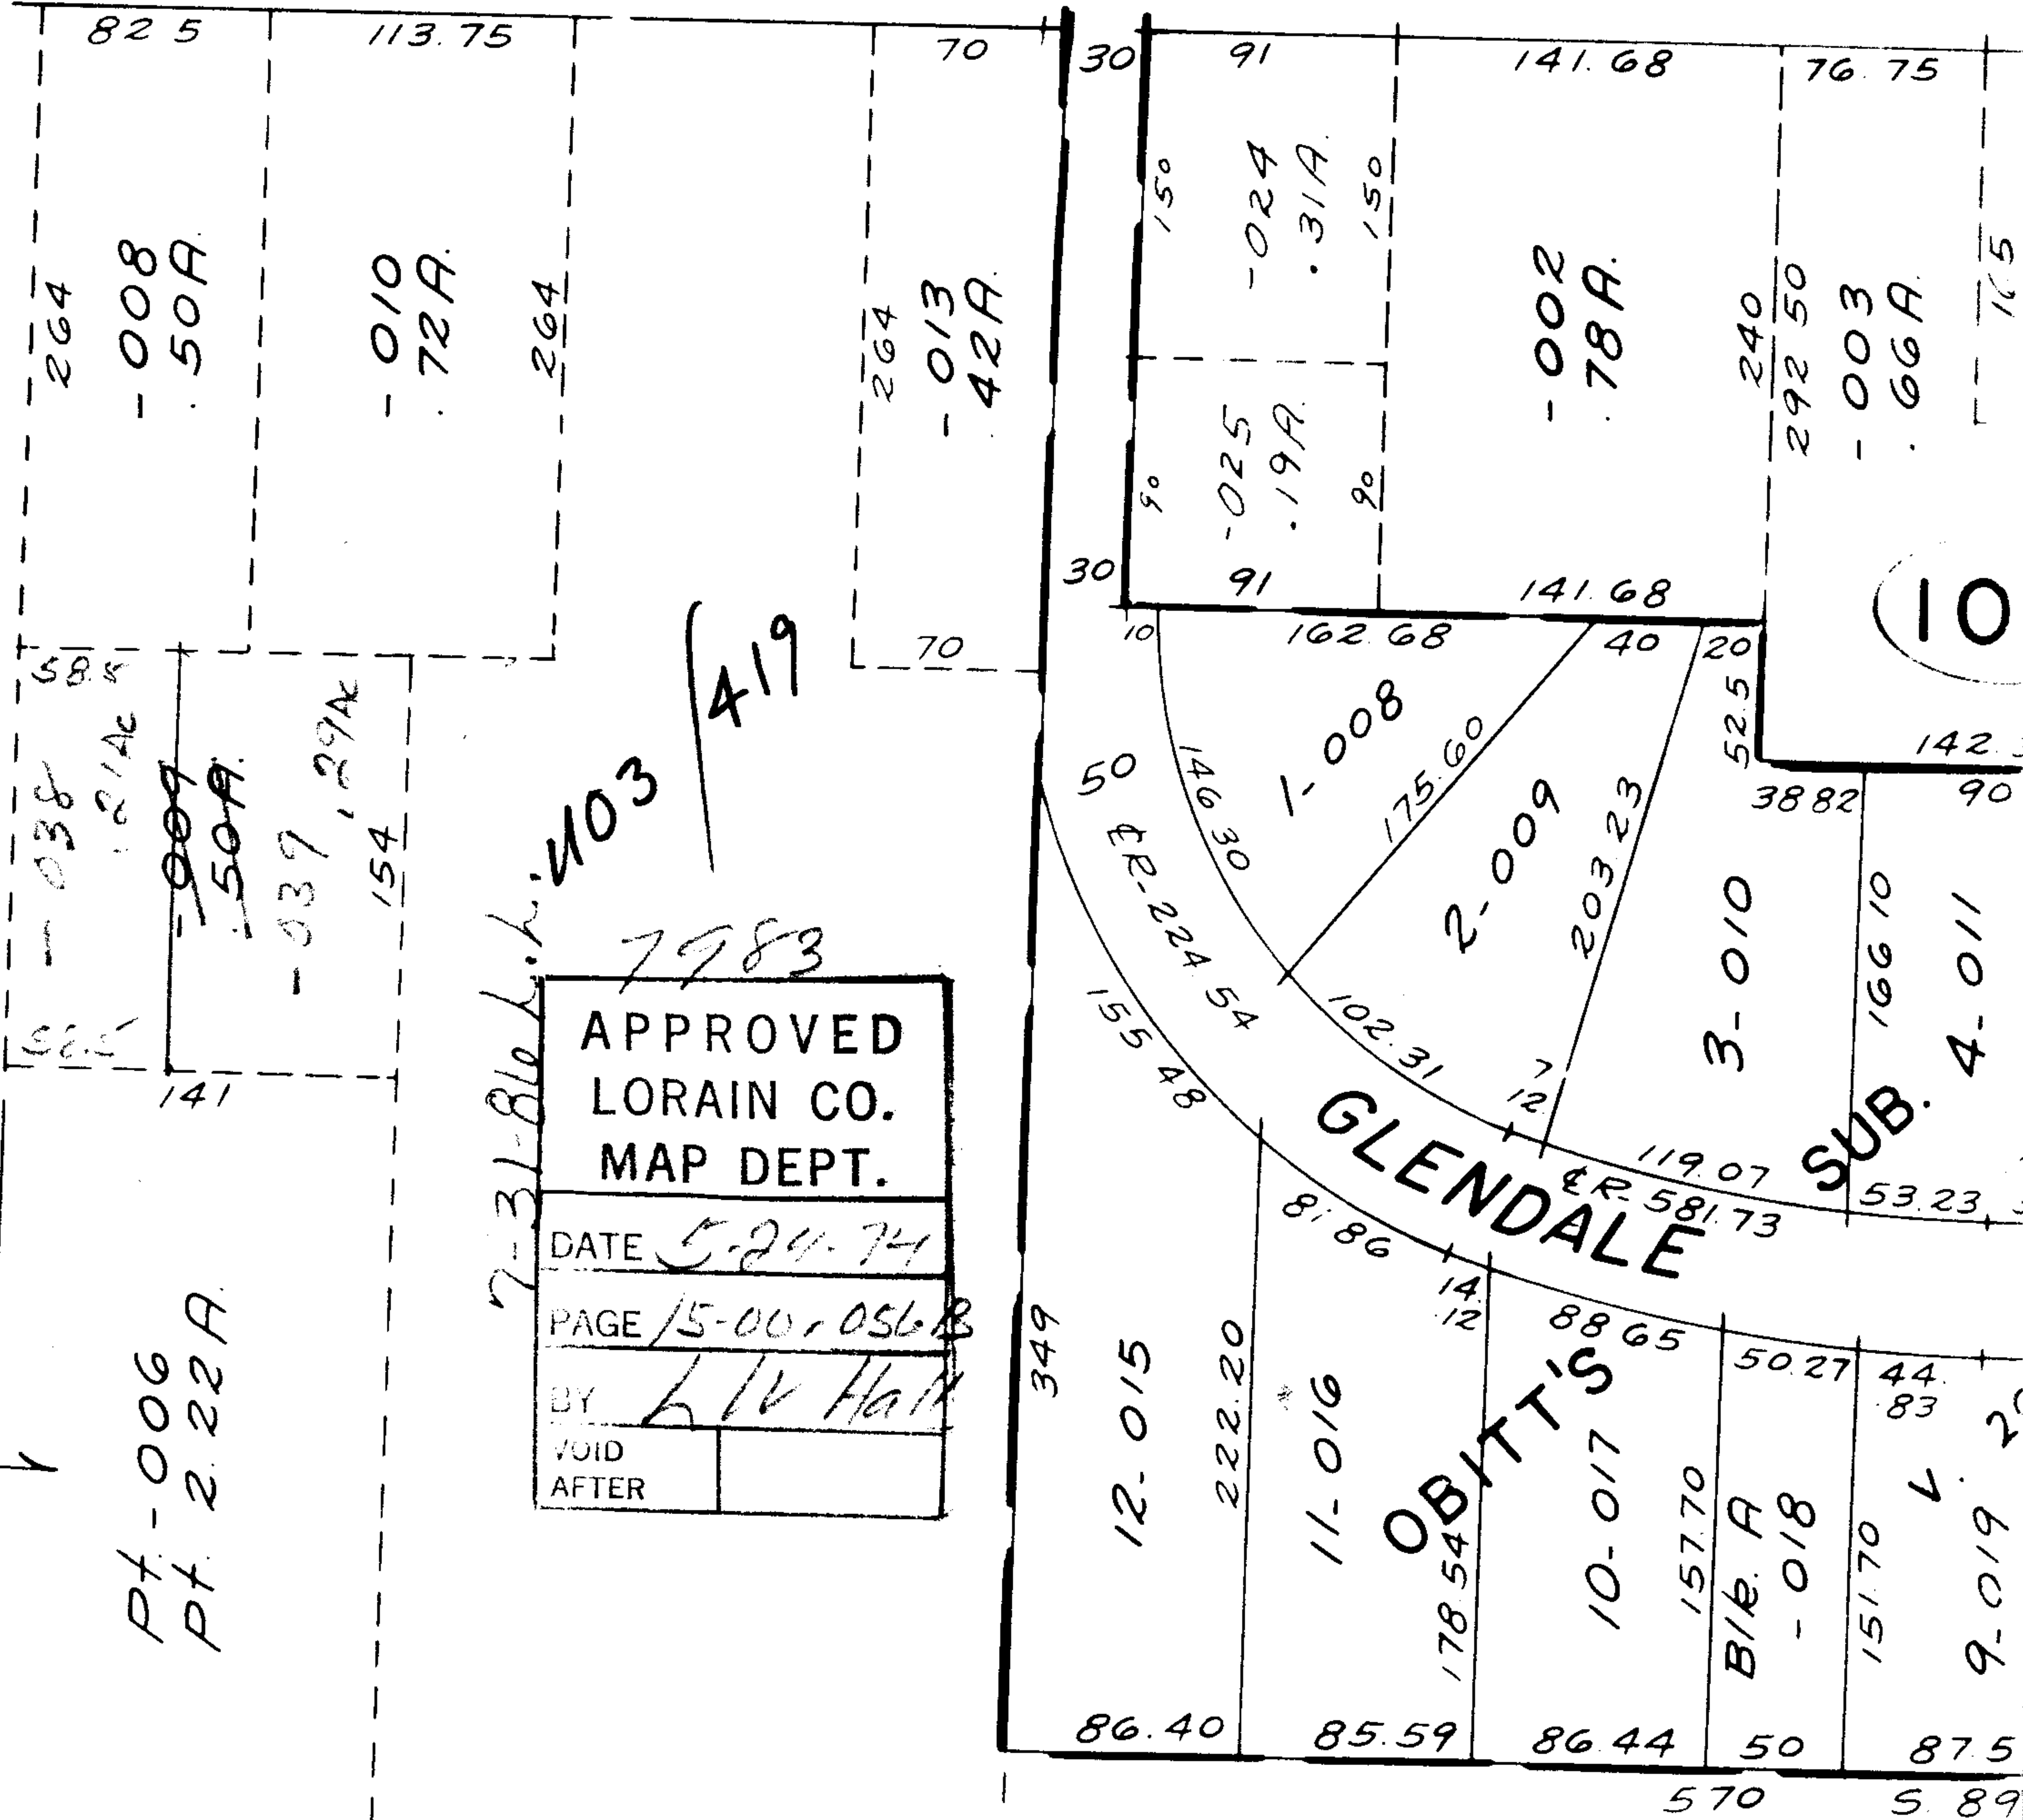

PT-006
PT 2.22A

588
1.21Ac
509
50A
537, 29A
154

7-31-816 L.H. 403
7983
419

APPROVED	
LORAIN CO.	
MAP DEPT.	
DATE	5-24-74
PAGE	15-00, 056B
BY	L.V. Hall
VOID	
AFTER	

- 032
915A

OK

101

10

SUB. 4-011

GLENDALE

OBITT'S