

# 7985

-034  
25.93 AC.

~~A20~~  
~~2-24-A~~




AUG 7 1974

# 7985

APPROVED LORAIN CO. MAP DEPT.
DATE 5-24-74
PAGE 1-00-006-A
BY Paul
VOID AFTER

PRJ




-033  
03 AC.

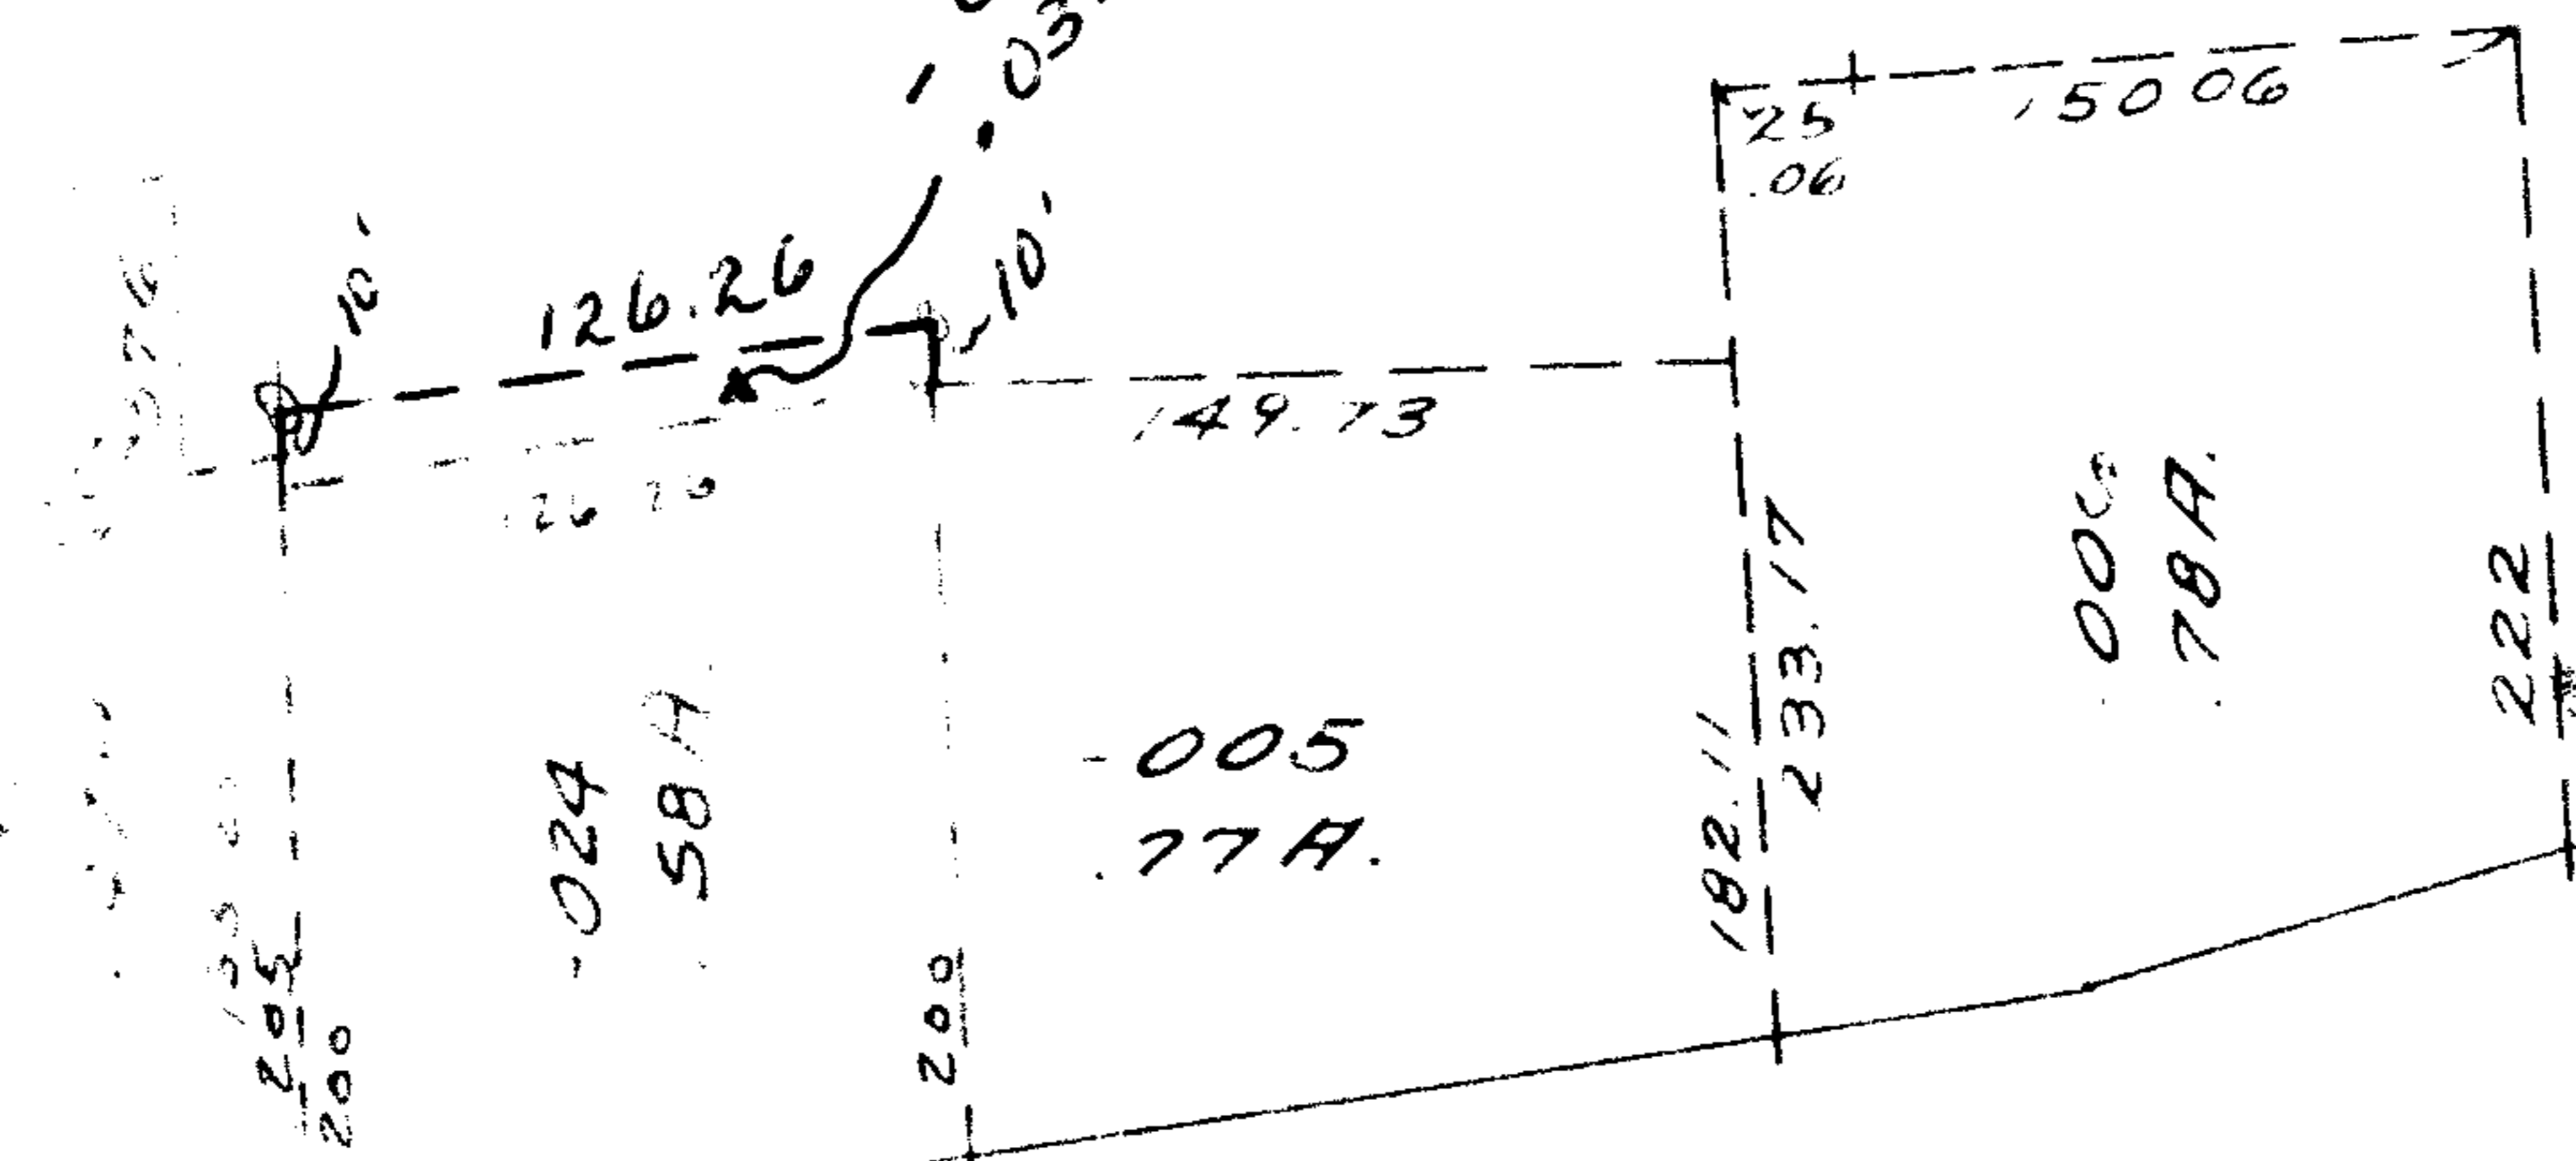

CLEVELAND SANDUSKY 151.27



AVE.

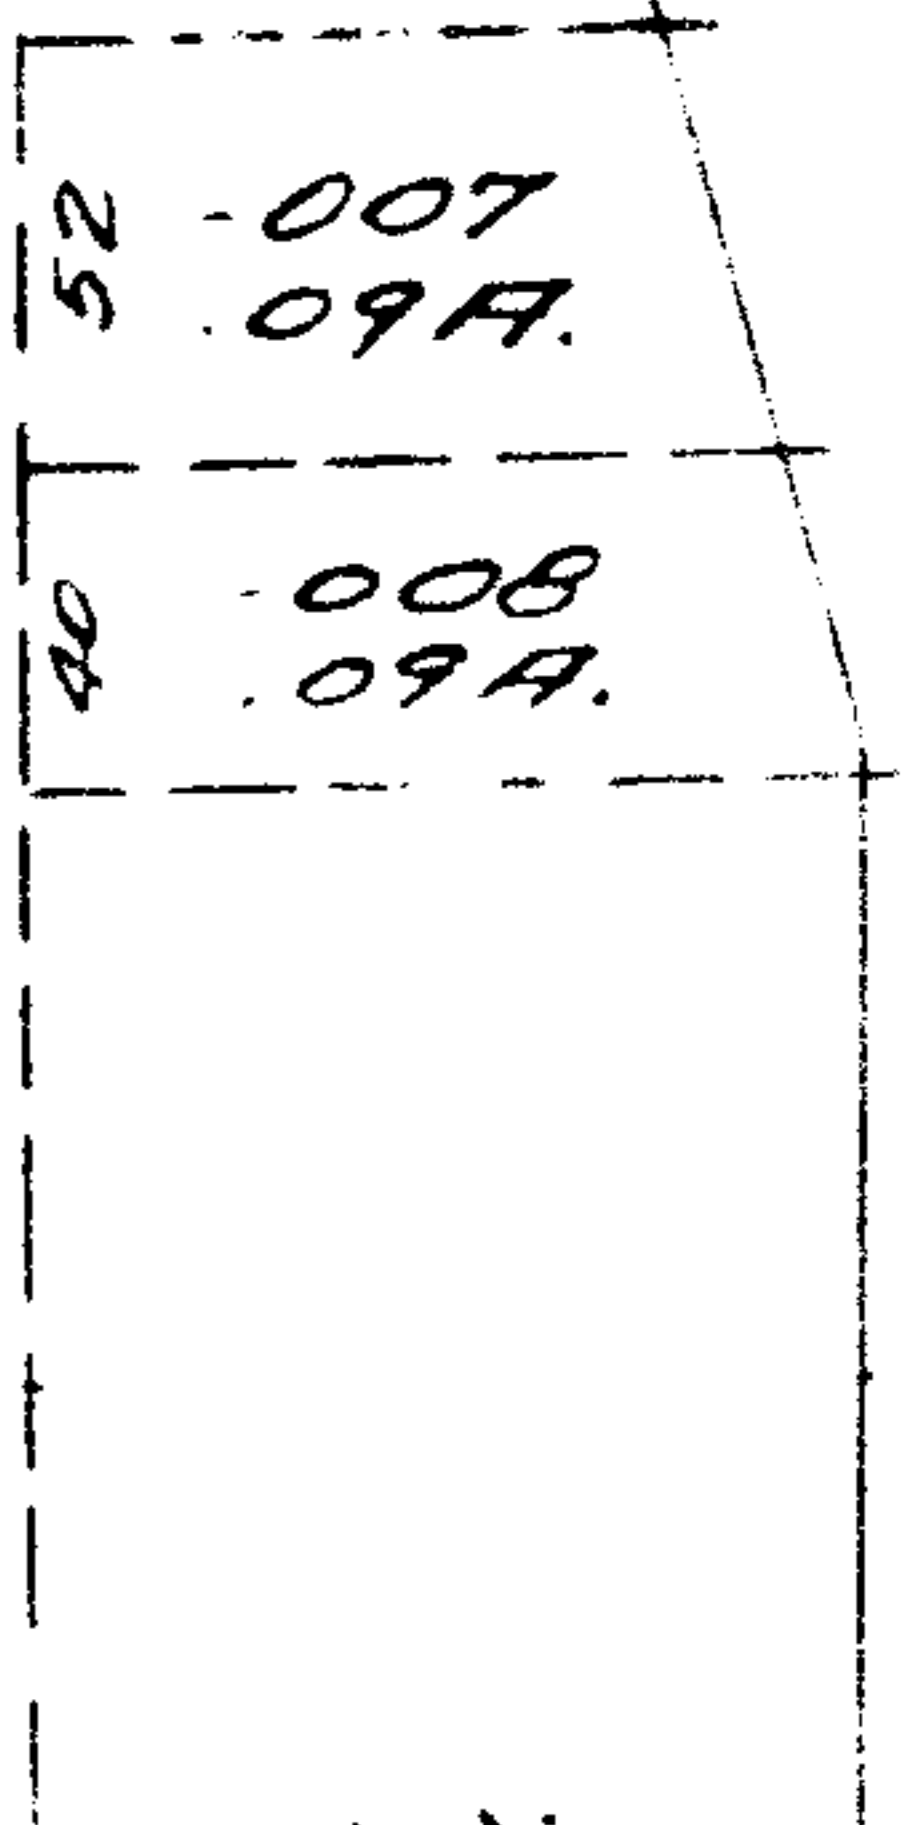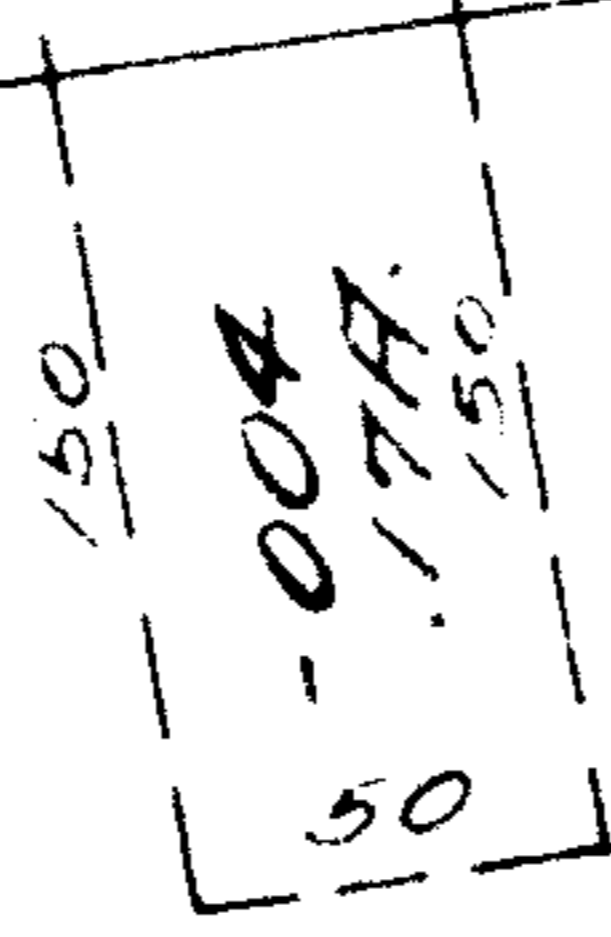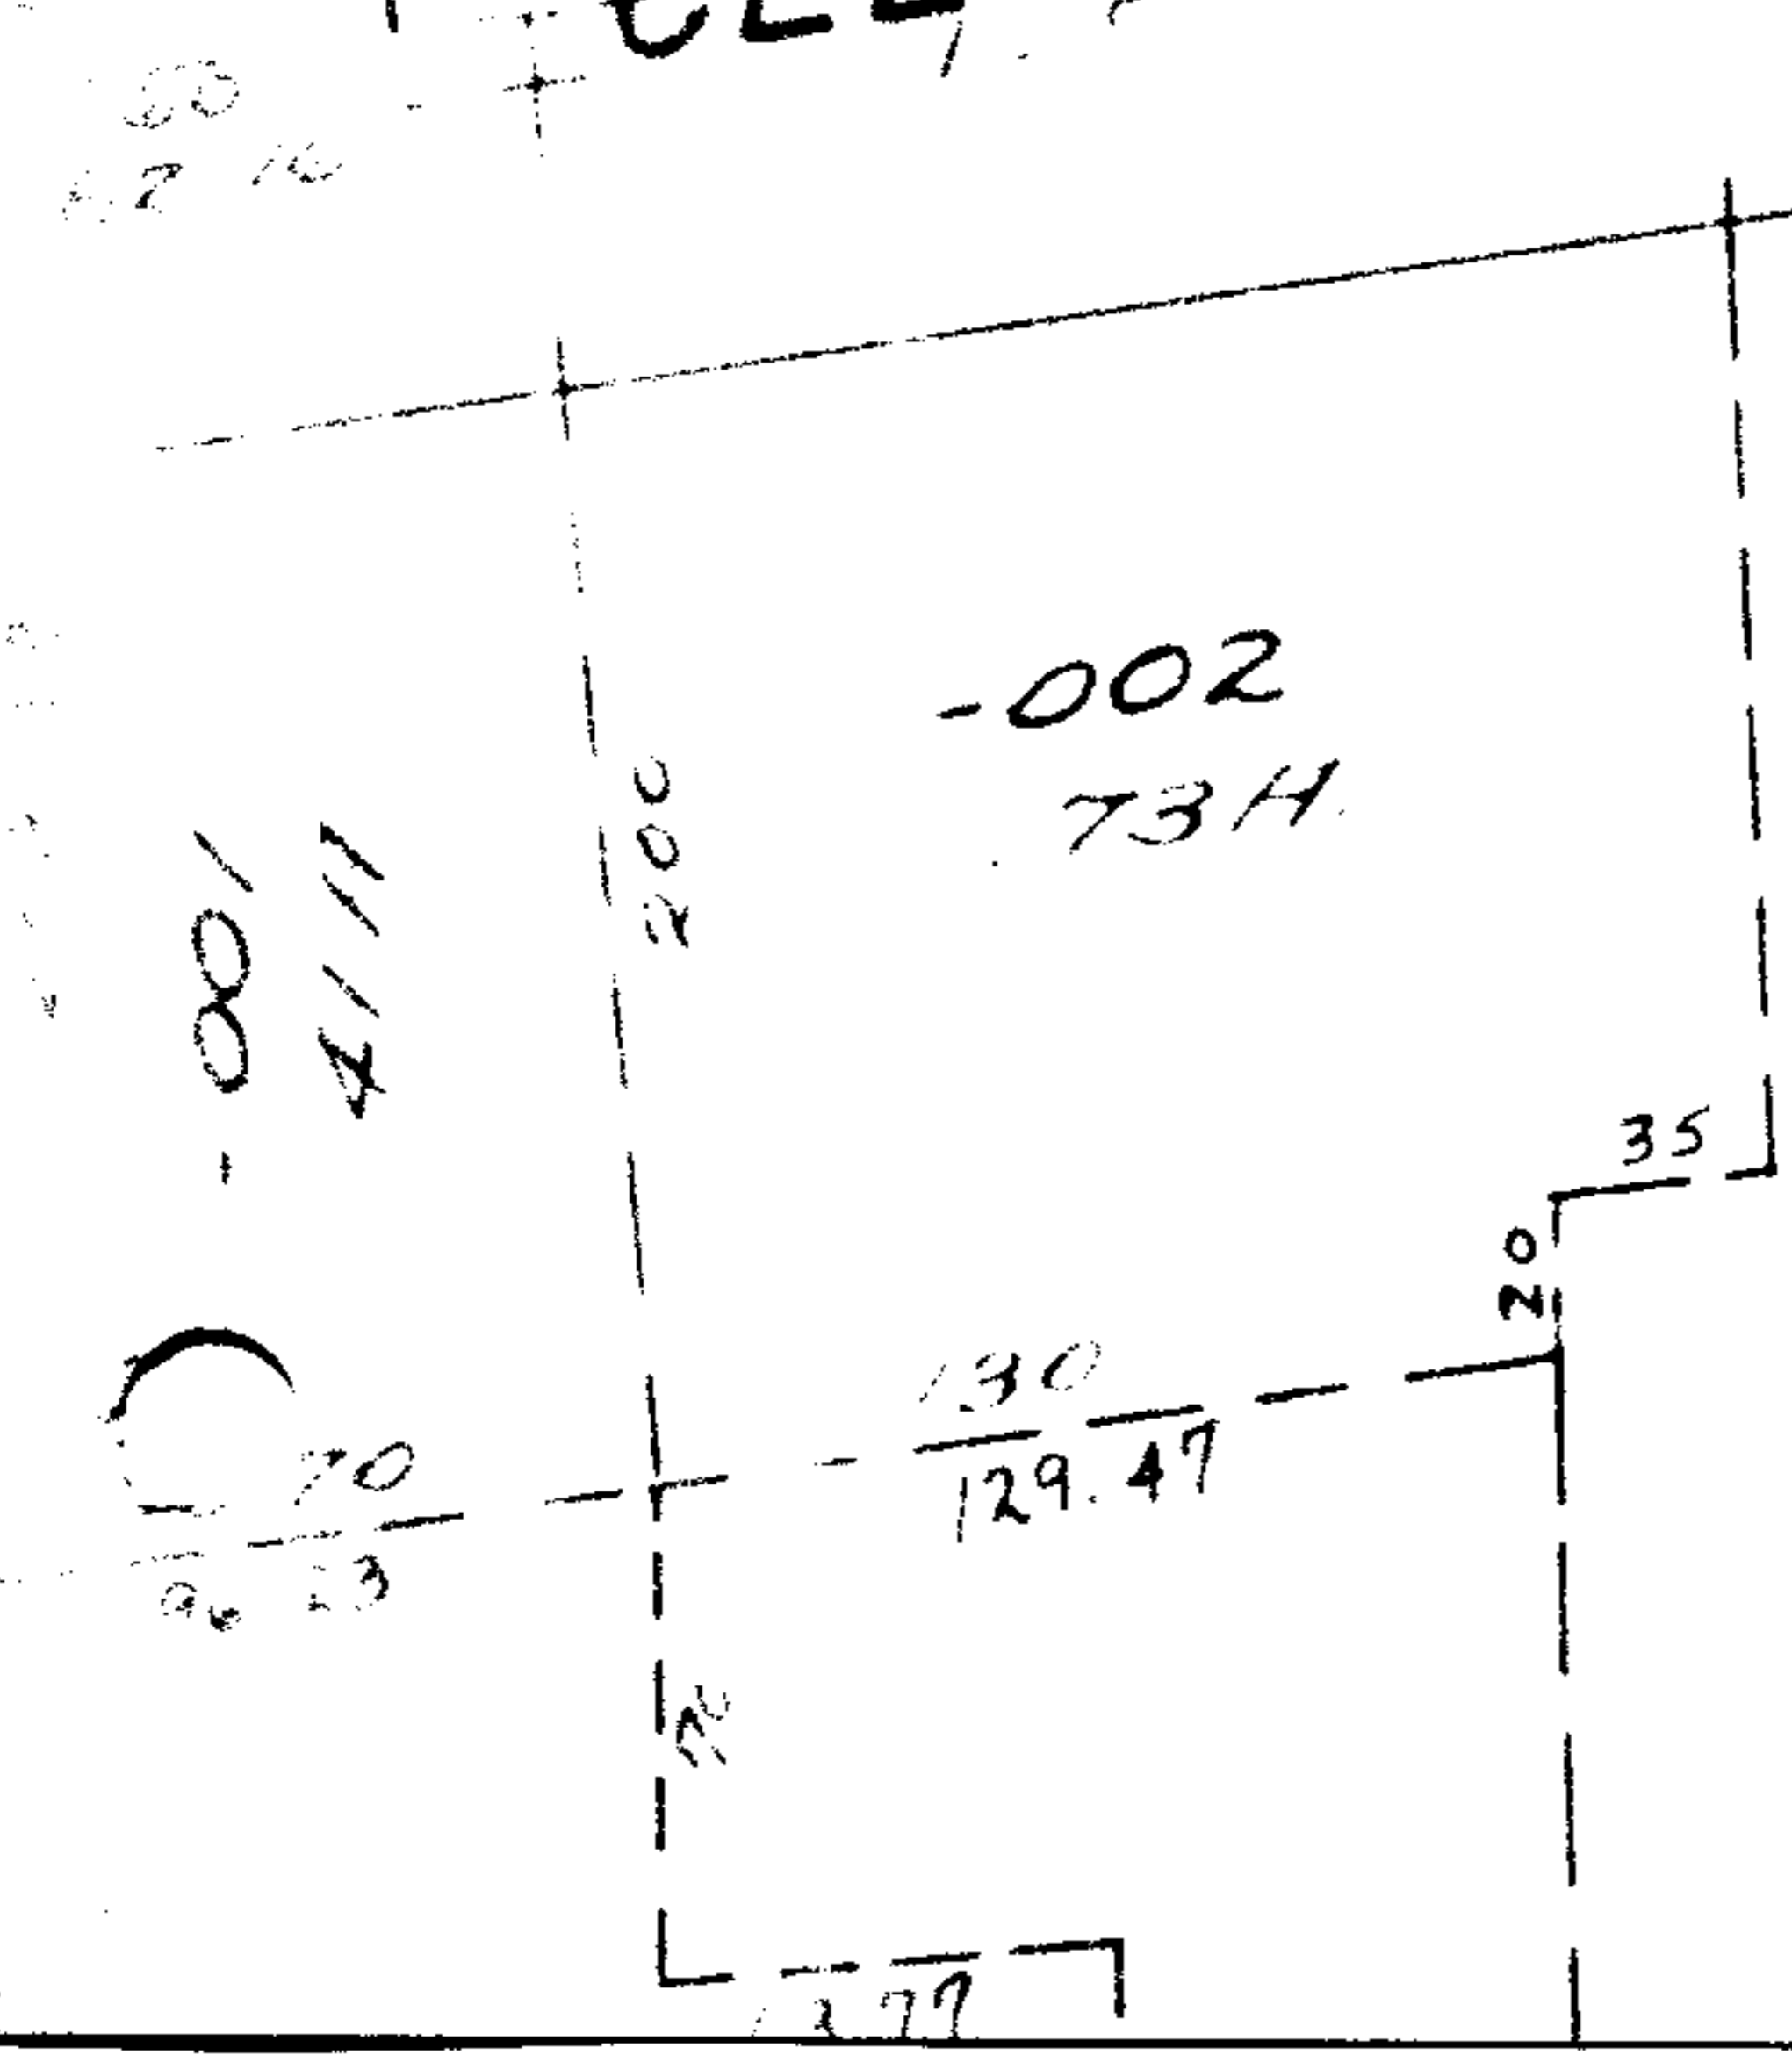

see survey