


7989

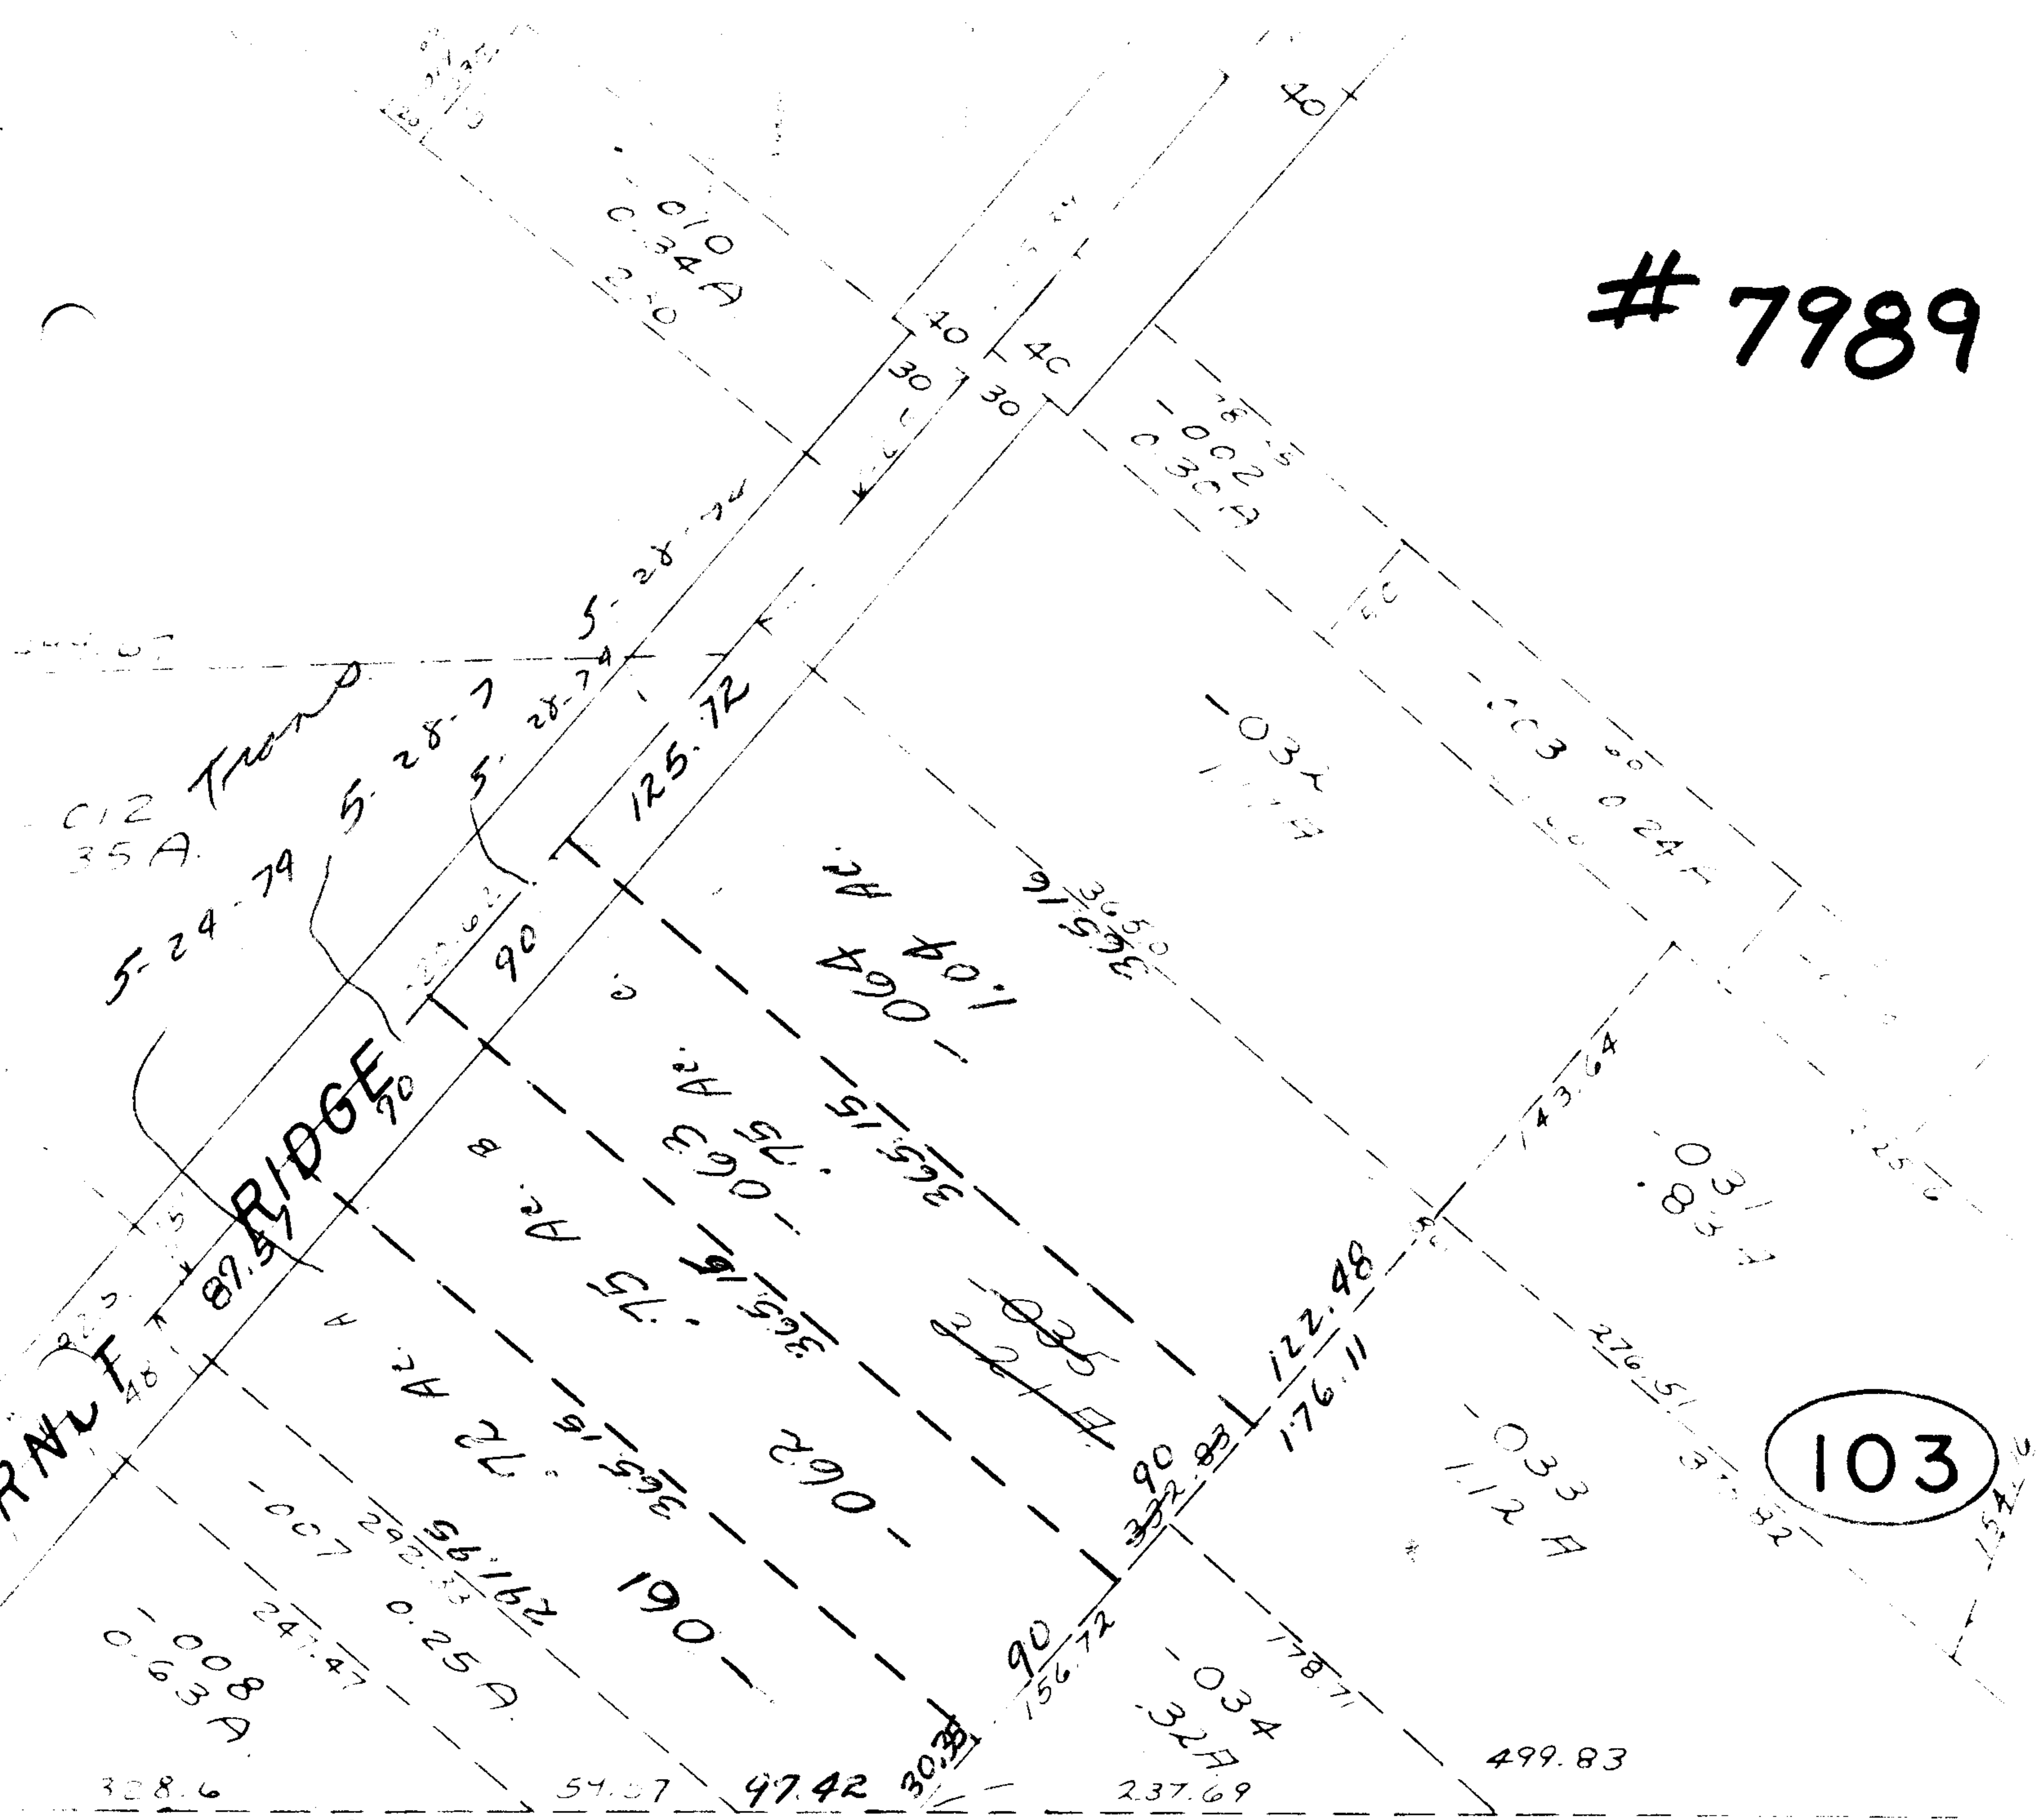

103

See Survey

AUG 9 1974



PR

7989

APPROVED LORAIN CO. MAP DEPT.	
DATE 5-24-74	
PAGE 7-00-011-A	
BY Paul	
VOID AFTER	

036
8.45A