

SEE 6-142

8003


1089

110
160
170
180
190
200
210

See 766's
1-9-74

Linden
June 550
1094-550

060
~~022~~
~~18.07 A.~~
17.61 AC

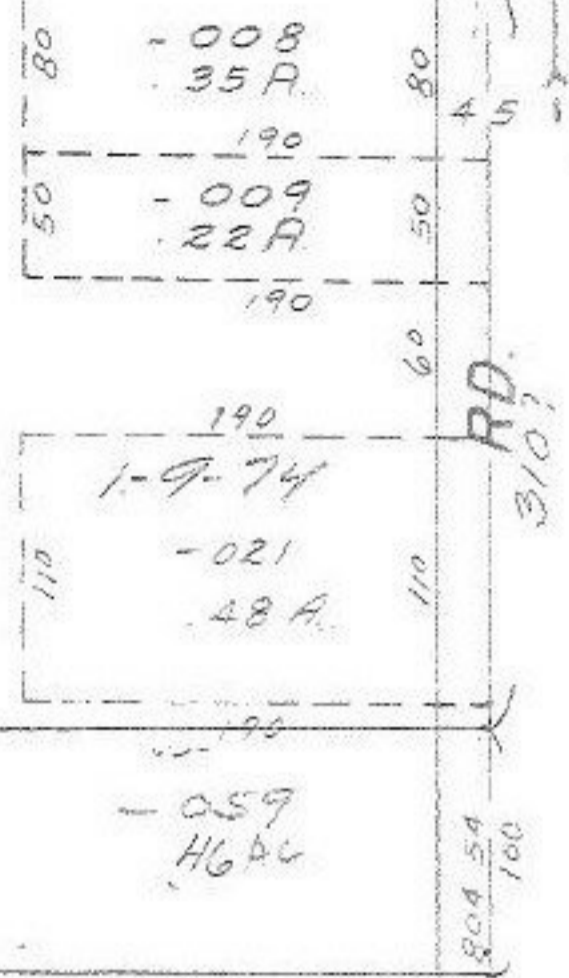

8003

APPROVED	
LORAIN CO.	
MAP DEPT.	
DATE 5-28-74	
PAGE 10-00-005 B	
BY L. W. Hark	
VOID	
AFTER	

D. S.
A. 6-86

RL

