

8013

AUG 7 1974



8013

APPROVED
LORAIN CO.
MAP DEPT.

DATE 5-30-74


PAGE 5-00-018A

BY L.W. Hall

VOID
AFTER

17-31-84

N. LAKE

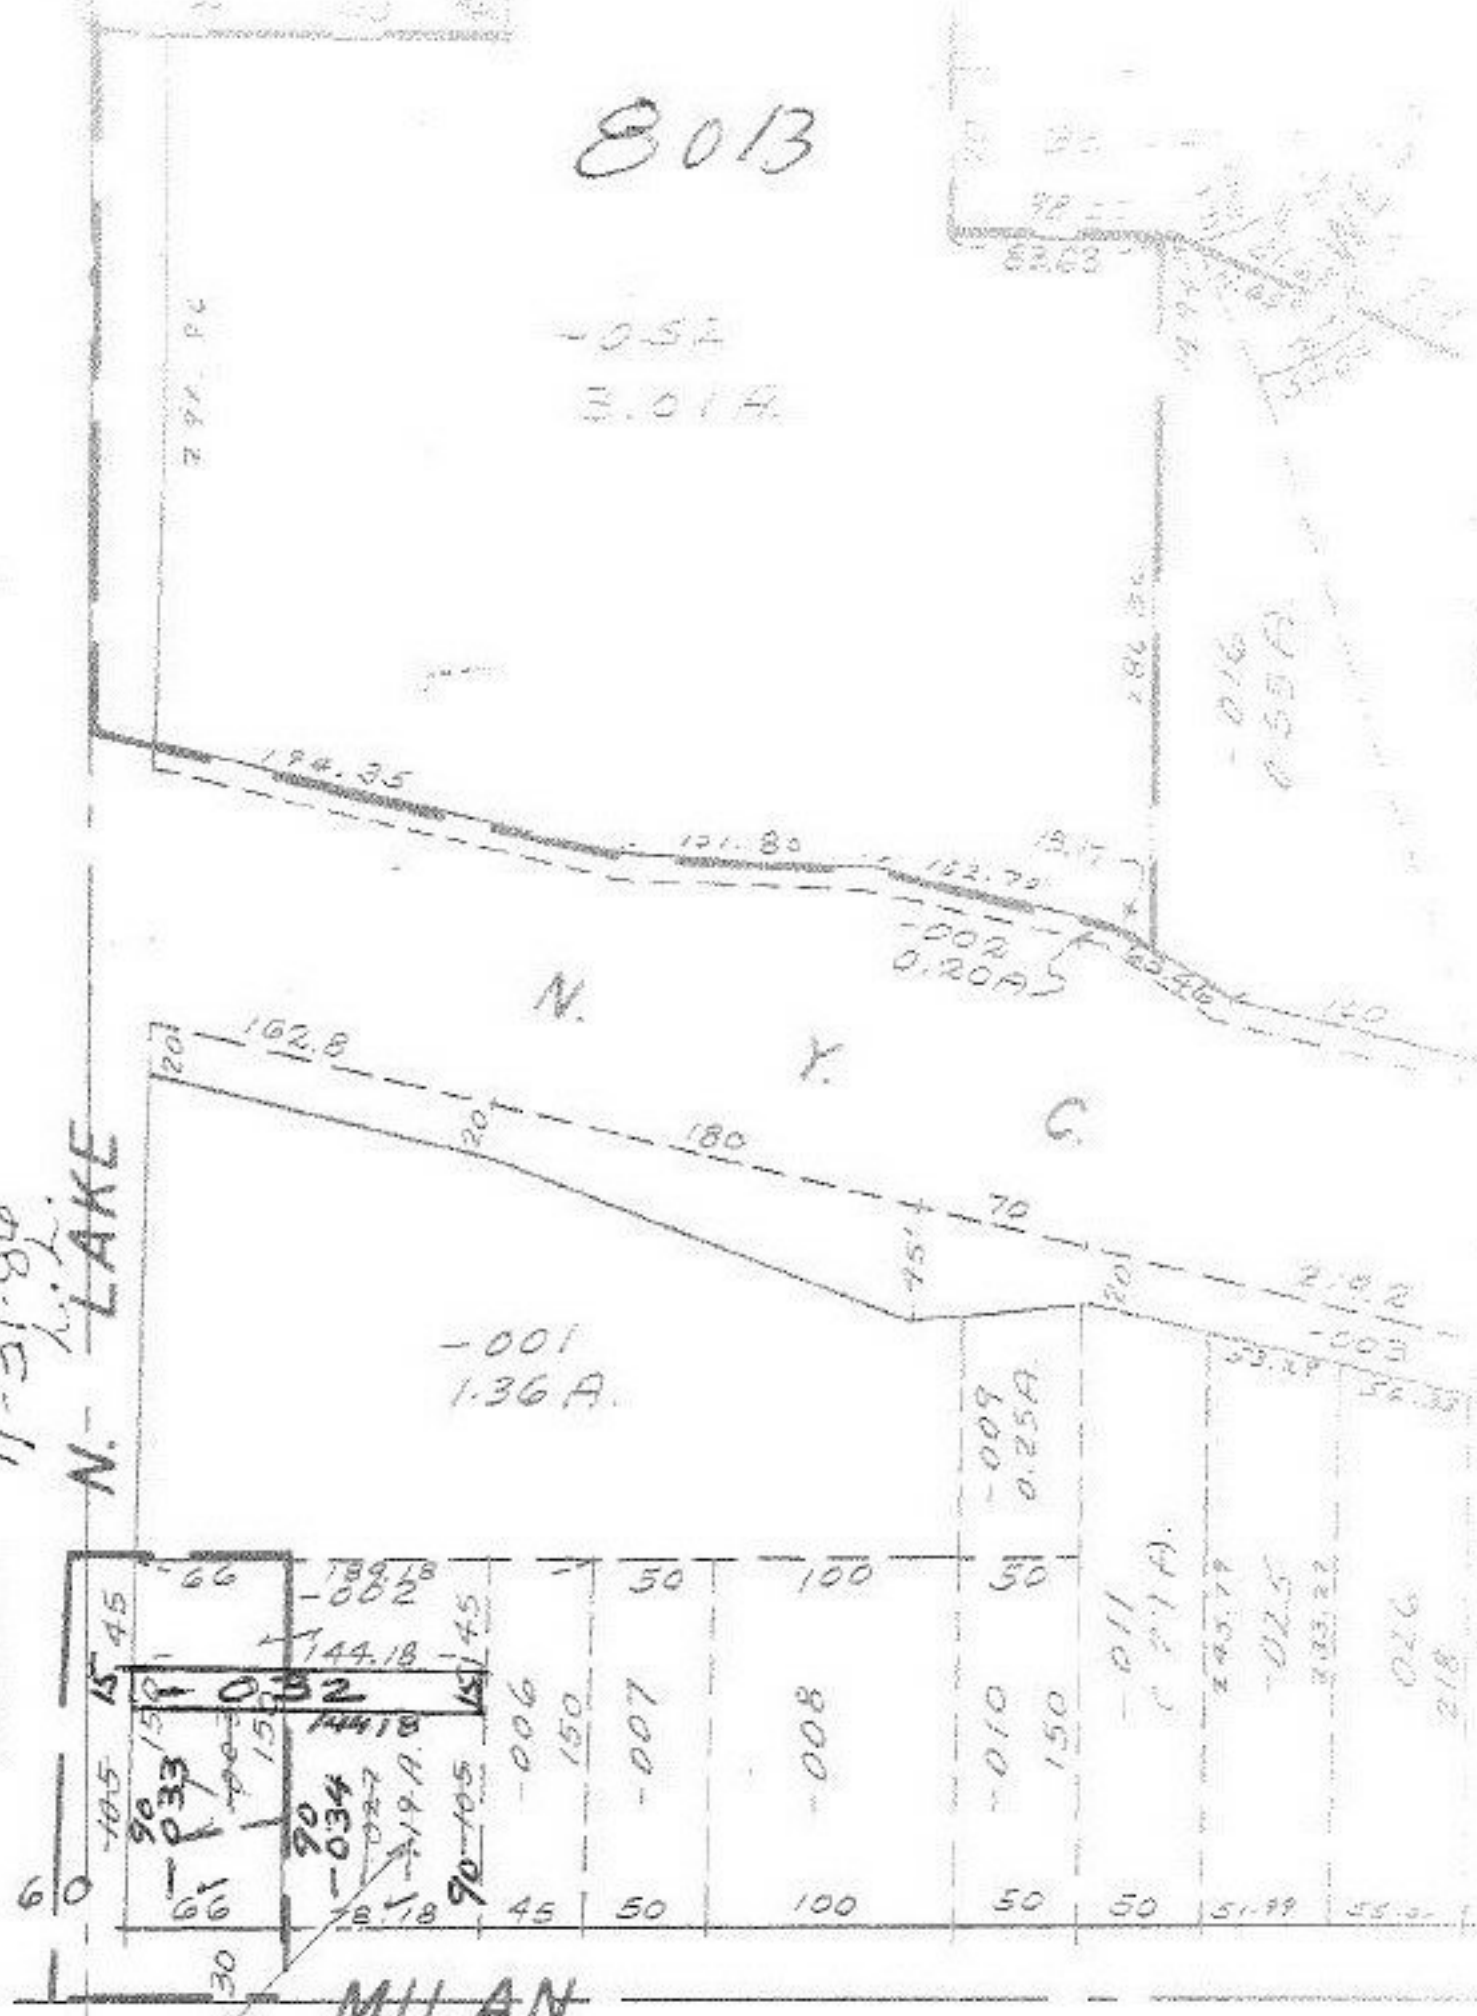

105
15
90

Equal to
78.18 x 105

144.18
66
78.18

PH

Copyright 1963
Revised 3-3-69

5-00-018-A

AMHERST
SCALE: 1" = 100'