
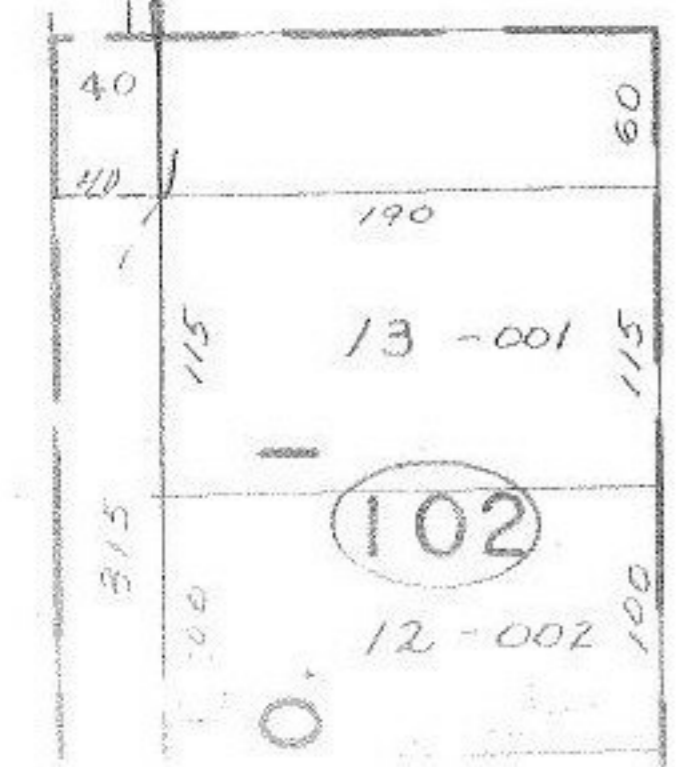


SEE 4-00-007-E

8040

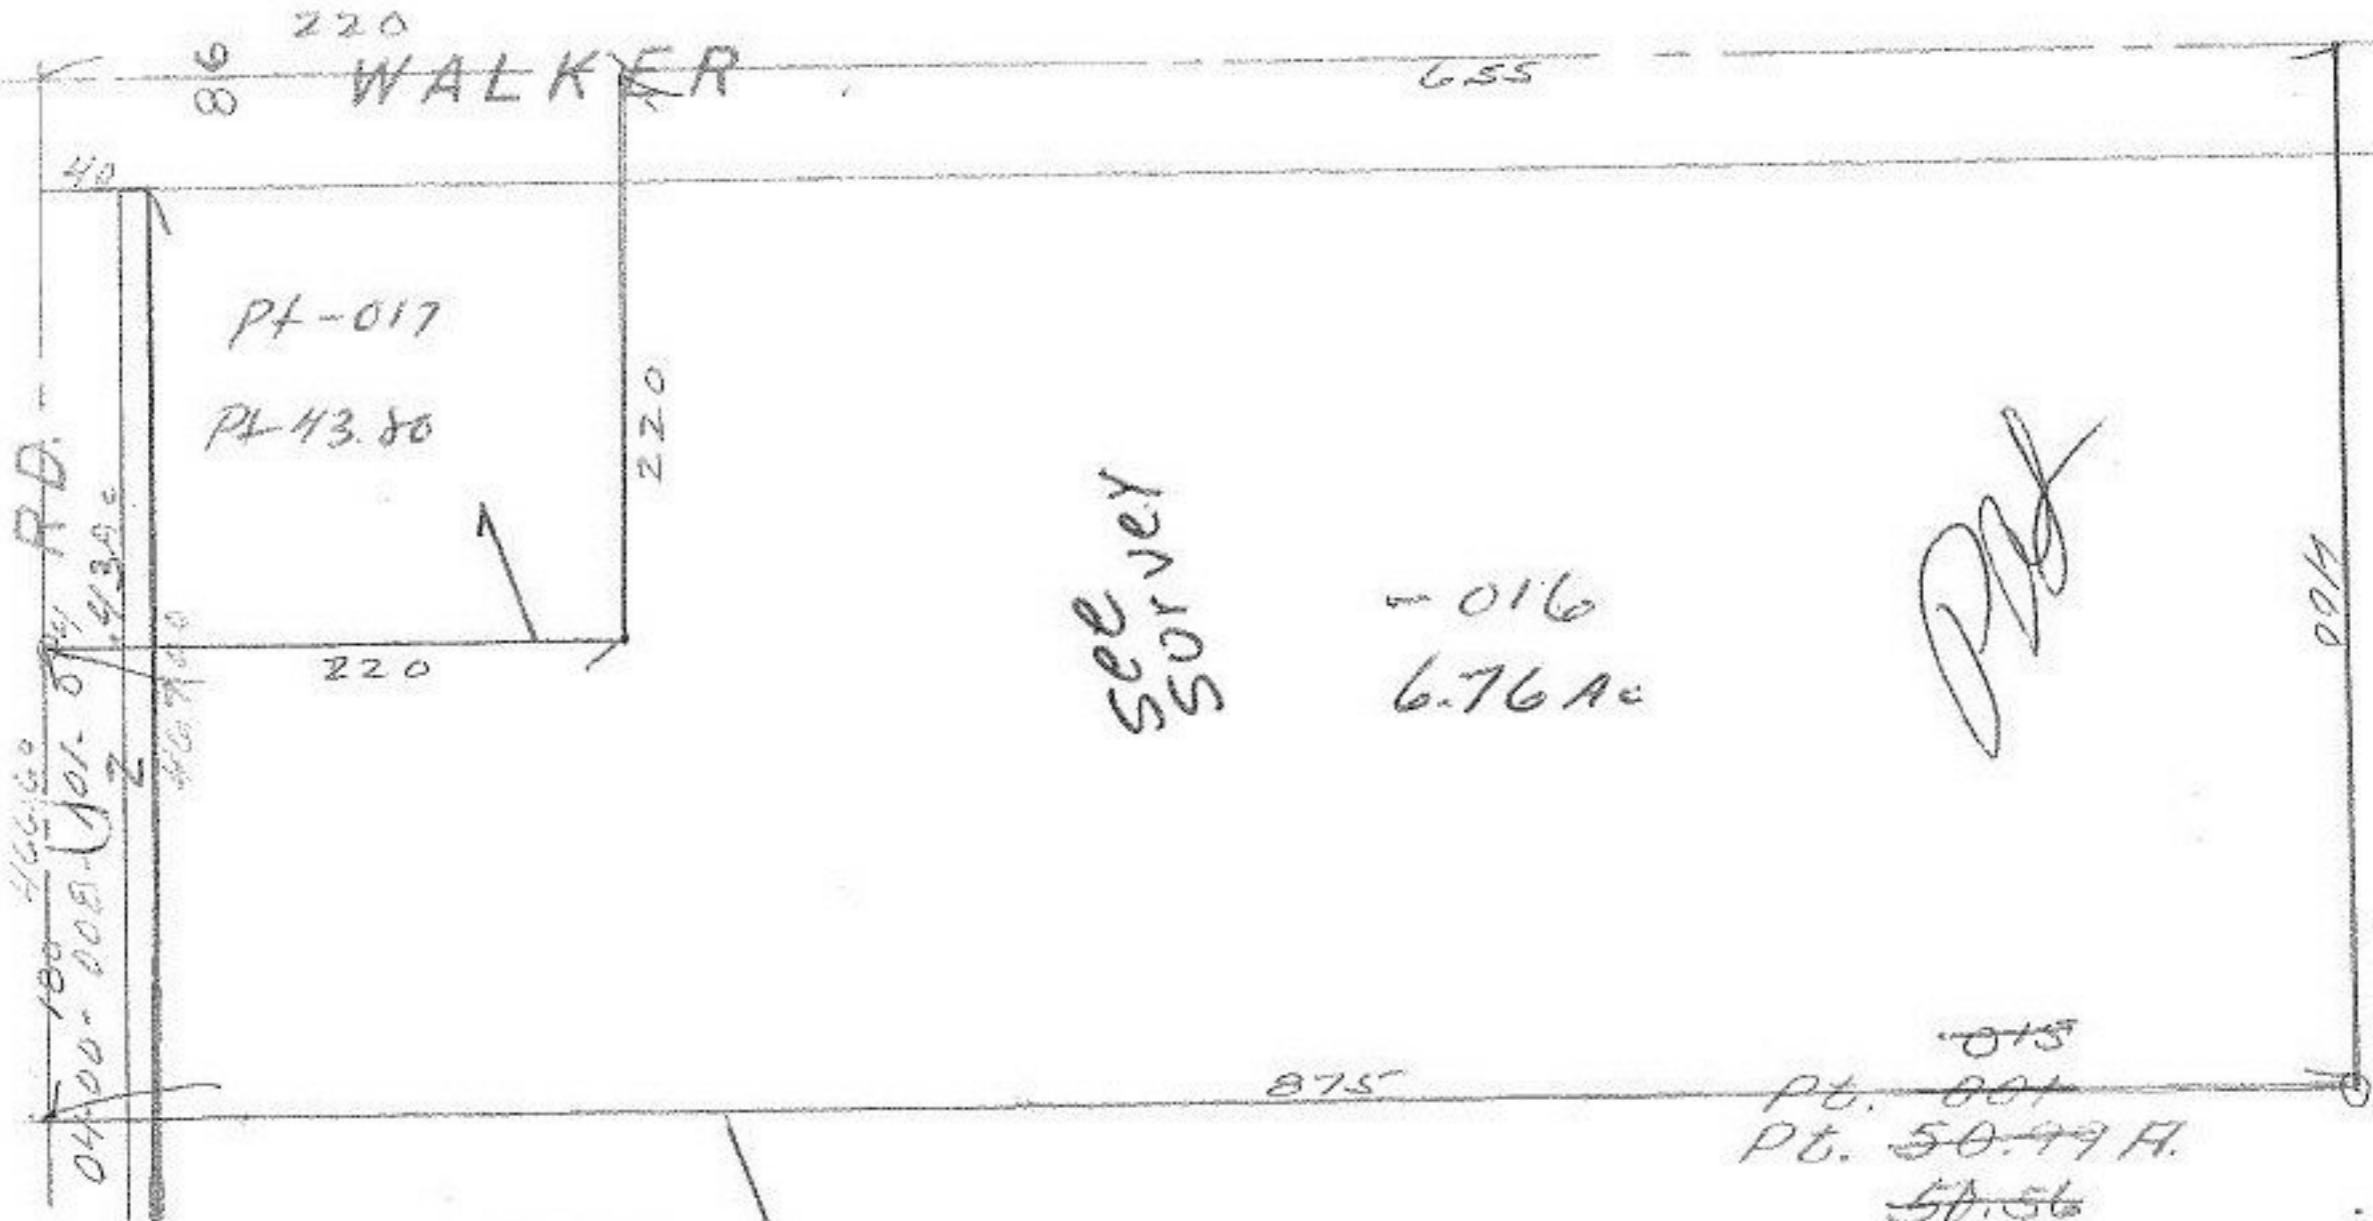

see survey

-016  
6.76 Ac

Pt. 001  
Pt. 50.99 A.  
50.56

Pt 017  
Pt. 43.80

AUG 8 1974

50.13.0

8040

|                   |            |
|-------------------|------------|
| APPROVED          |            |
| LORAIN CO.        |            |
| MAP DEPT.         |            |
| DATE 6-12-74      |            |
| PAGE 4-00-008 A+B |            |
| BY                | L. W. Hall |
| VOID              |            |
| AFTER             |            |

See Also Pg 4-00-008 B ↓