


8040

SEE 4-00

WALKER

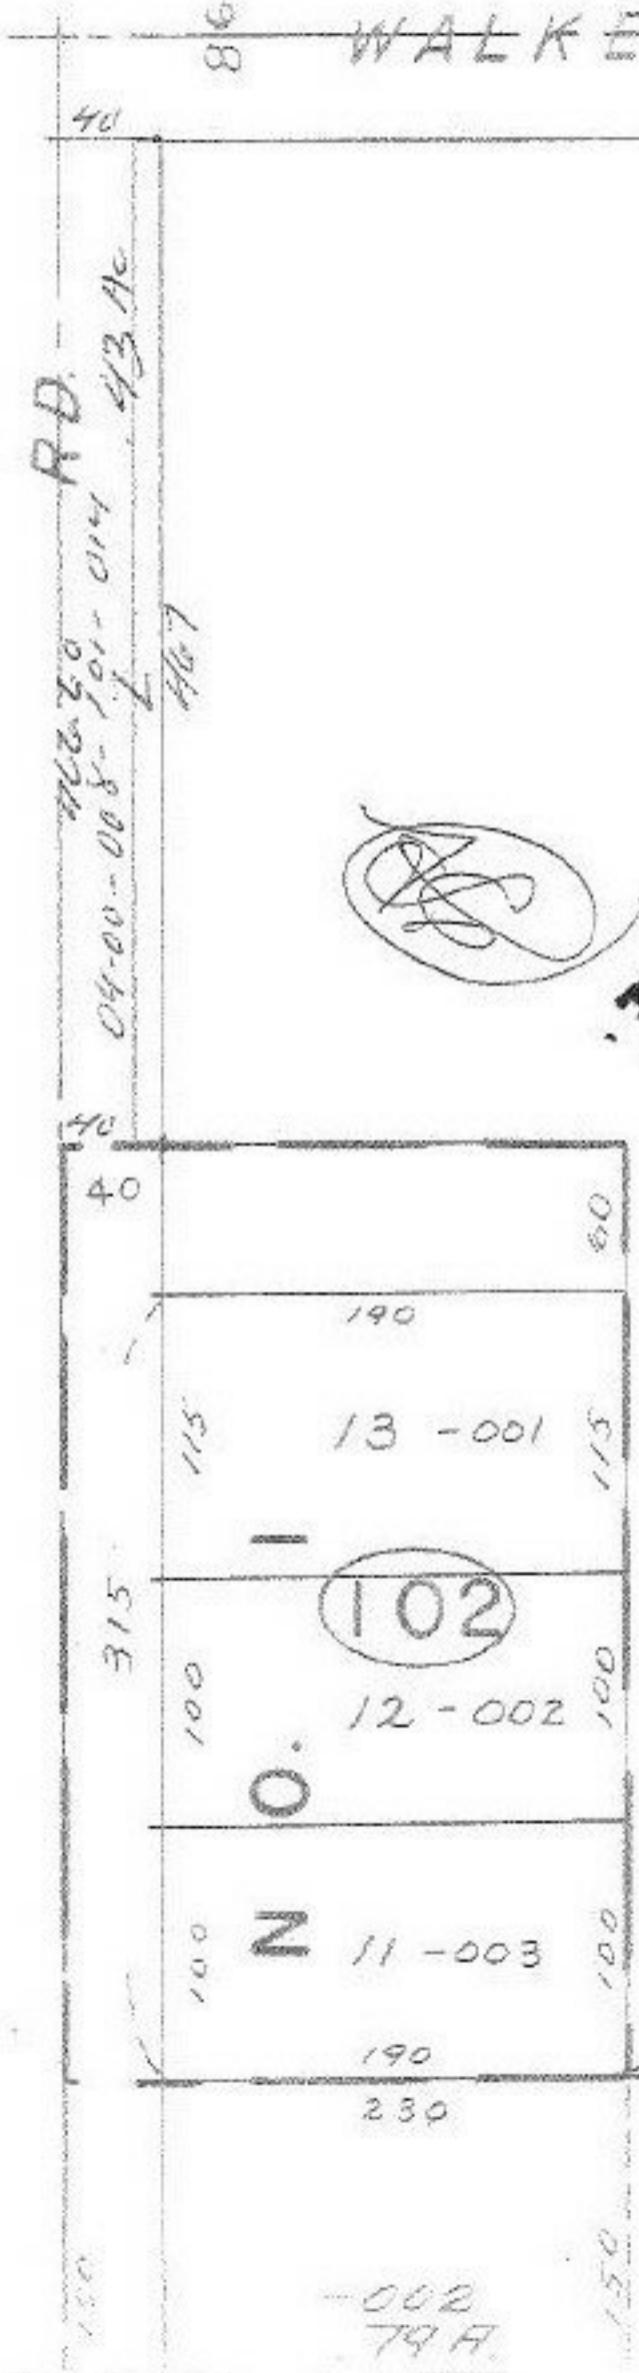

Ans

AUG 8 1974

E040

APPROVED LORAIN CO. MAP DEPT.
DATE 6-11-74
PAGE 4-00-008
BY L.H. Hall
VOID
AFTER

Pf 015 PT.  
~~Pf 001~~  
~~Pf 50.99A~~

50,56 Ac