

8060

8060


APPROVED	
LORAIN CO.	
MAP DEPT.	
DATE 6-18-74	
PAGE 2 of 2-006 B	
BY <i>[Signature]</i>	
VOID AFTER	8060

-043  
1.21 A.  
-047  
1.21 A.

-047  
1.21 A. **AUG 7 1974**

PRS

~~-012~~ -075  
~~1.00 A.~~ 0.93 A.

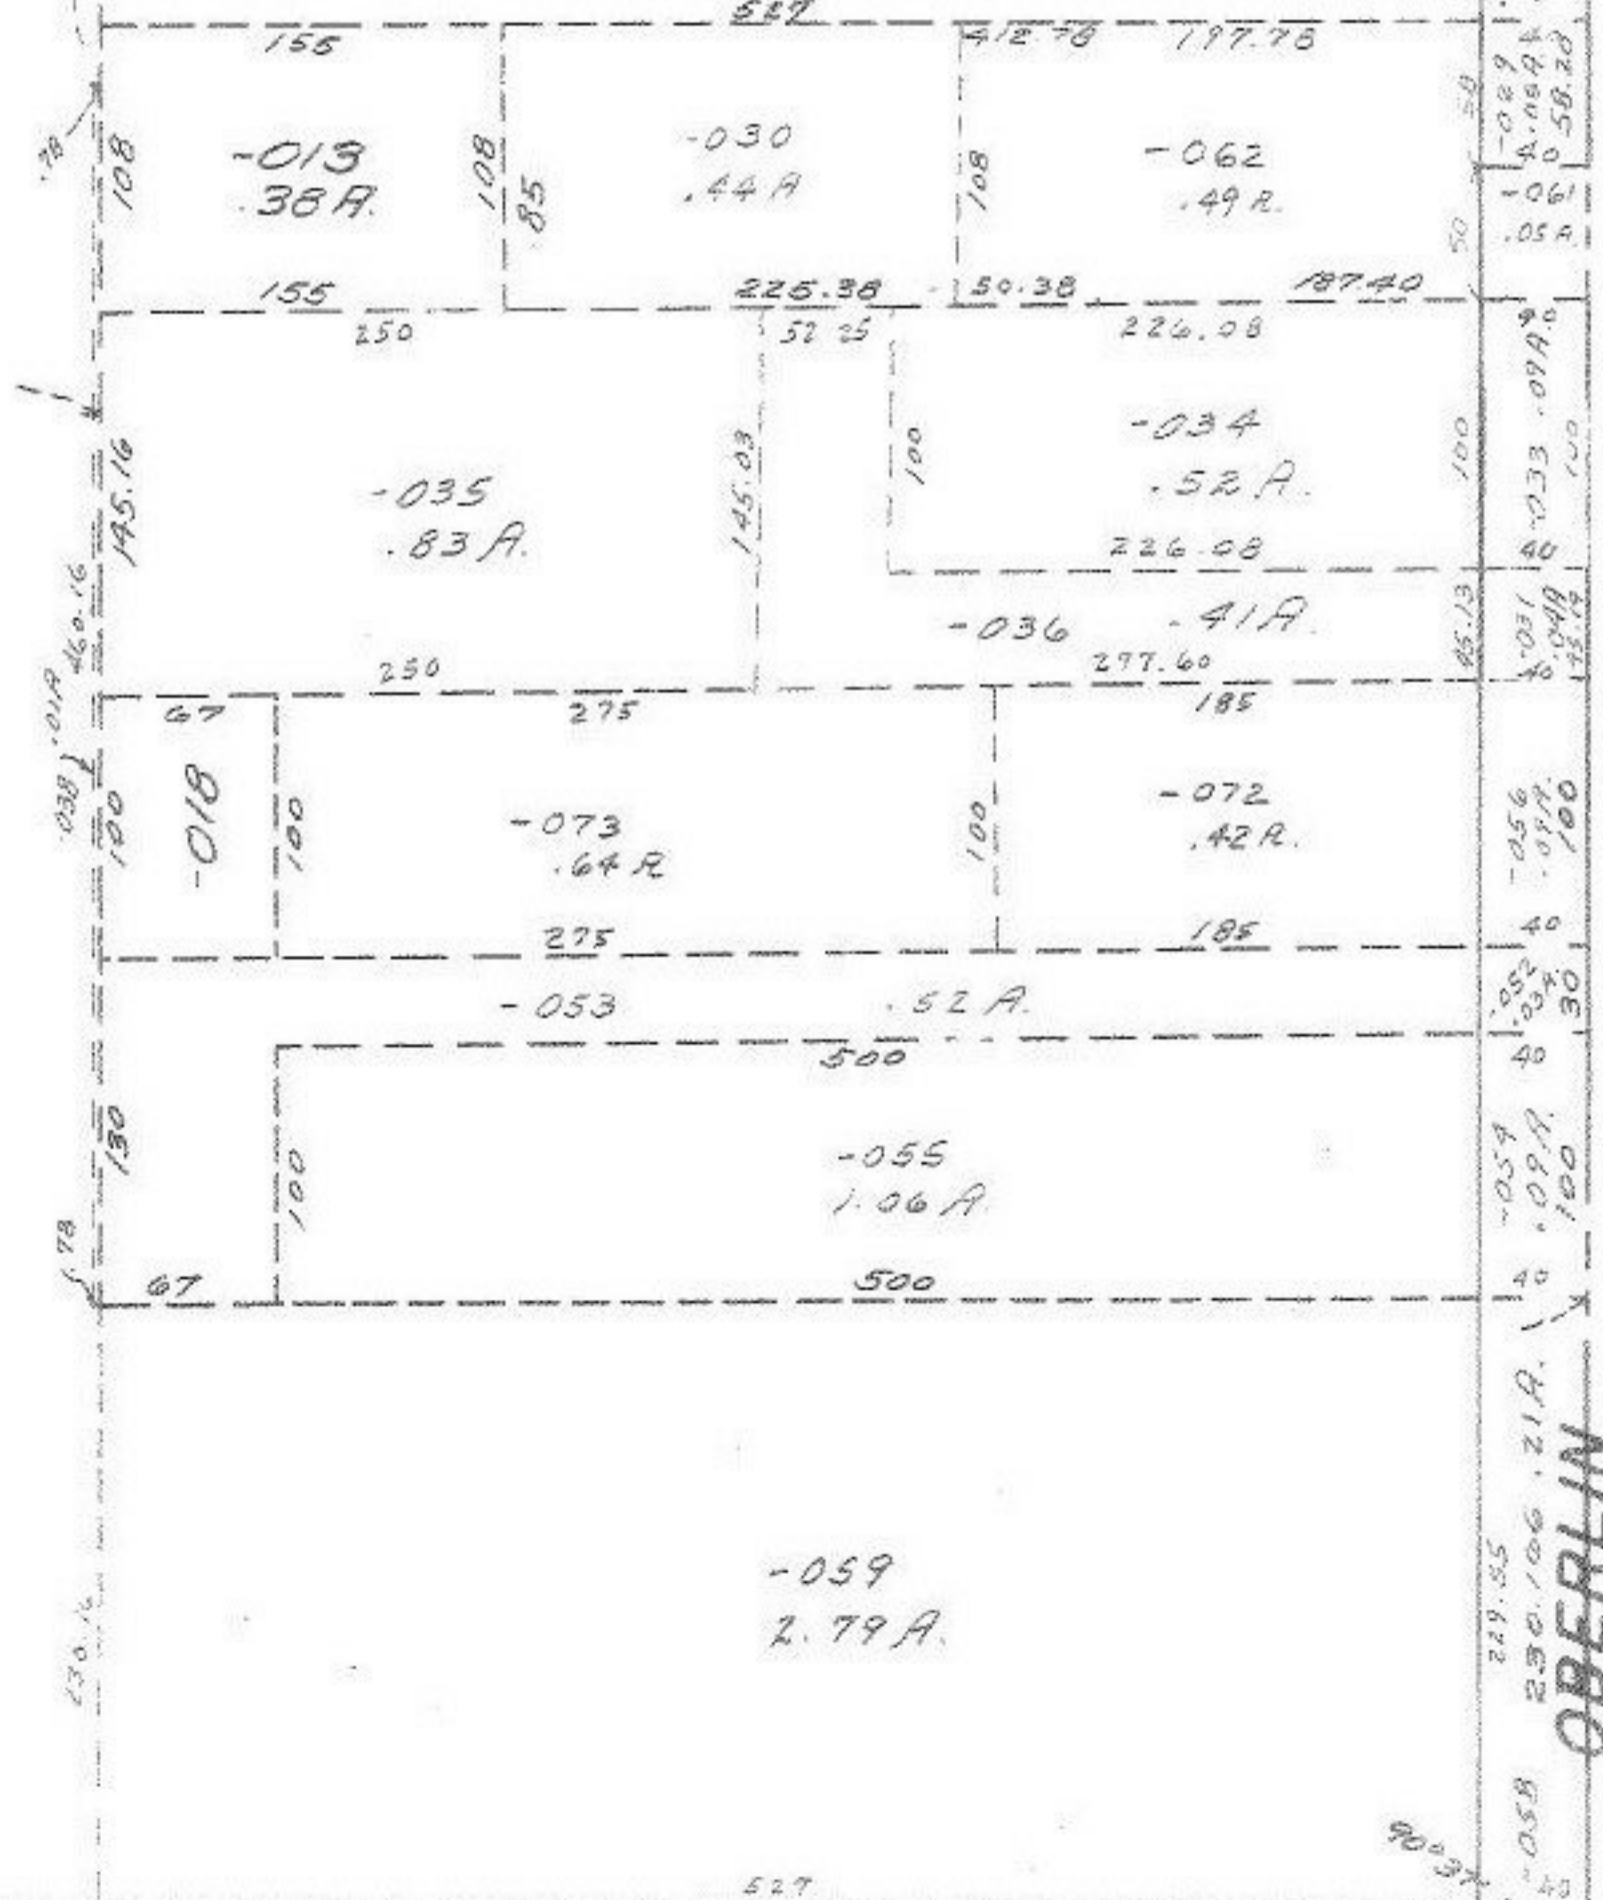

OBERLIN

527