

8061


AUG 7 1974

(Handwritten initials) *(PR)*

8061

APPROVED
LORAIN CO.
MAP DEPT.
DATE 6-18-74
PAGE 02-02-015B
BY L.W. Hall
VOID
AFTER

S. 8-6-86

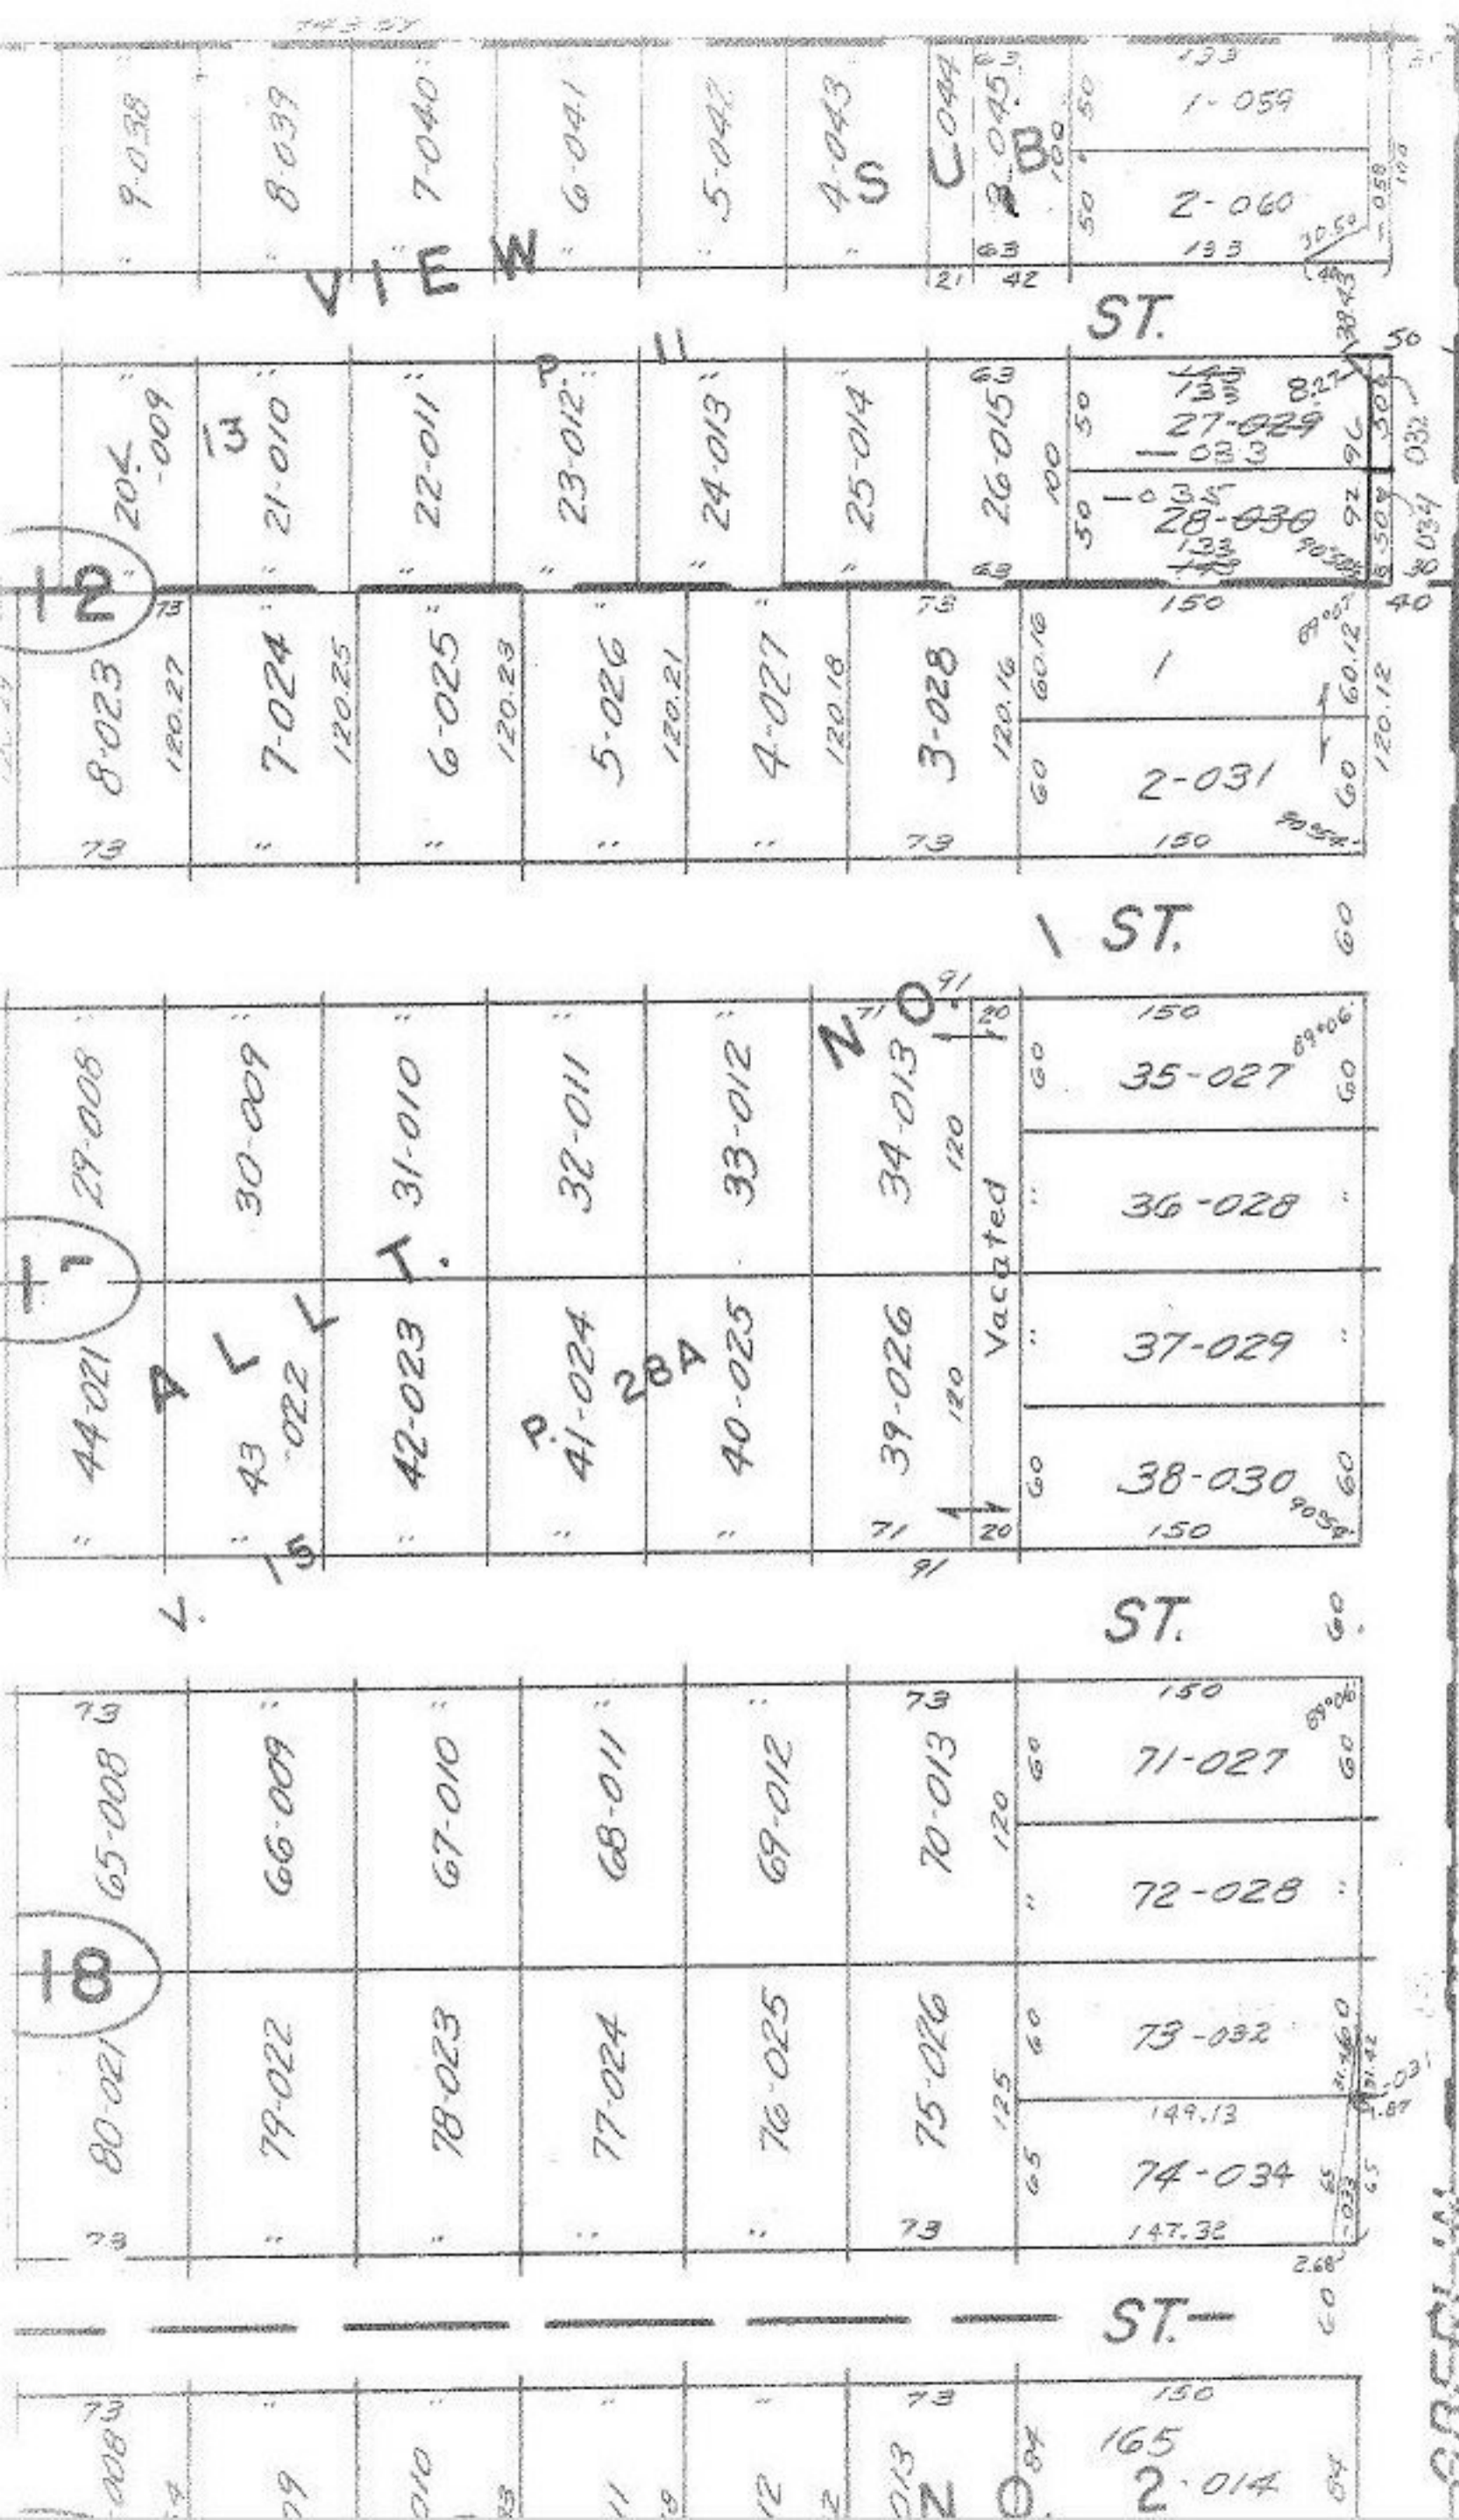

BERLIN