

8067

APPROVED
LORAIN CO.
MAP DEPT.


DATE 6-18-74

PAGE 4-B

BY *[Signature]*

VOID AFTER 8067

MOORE

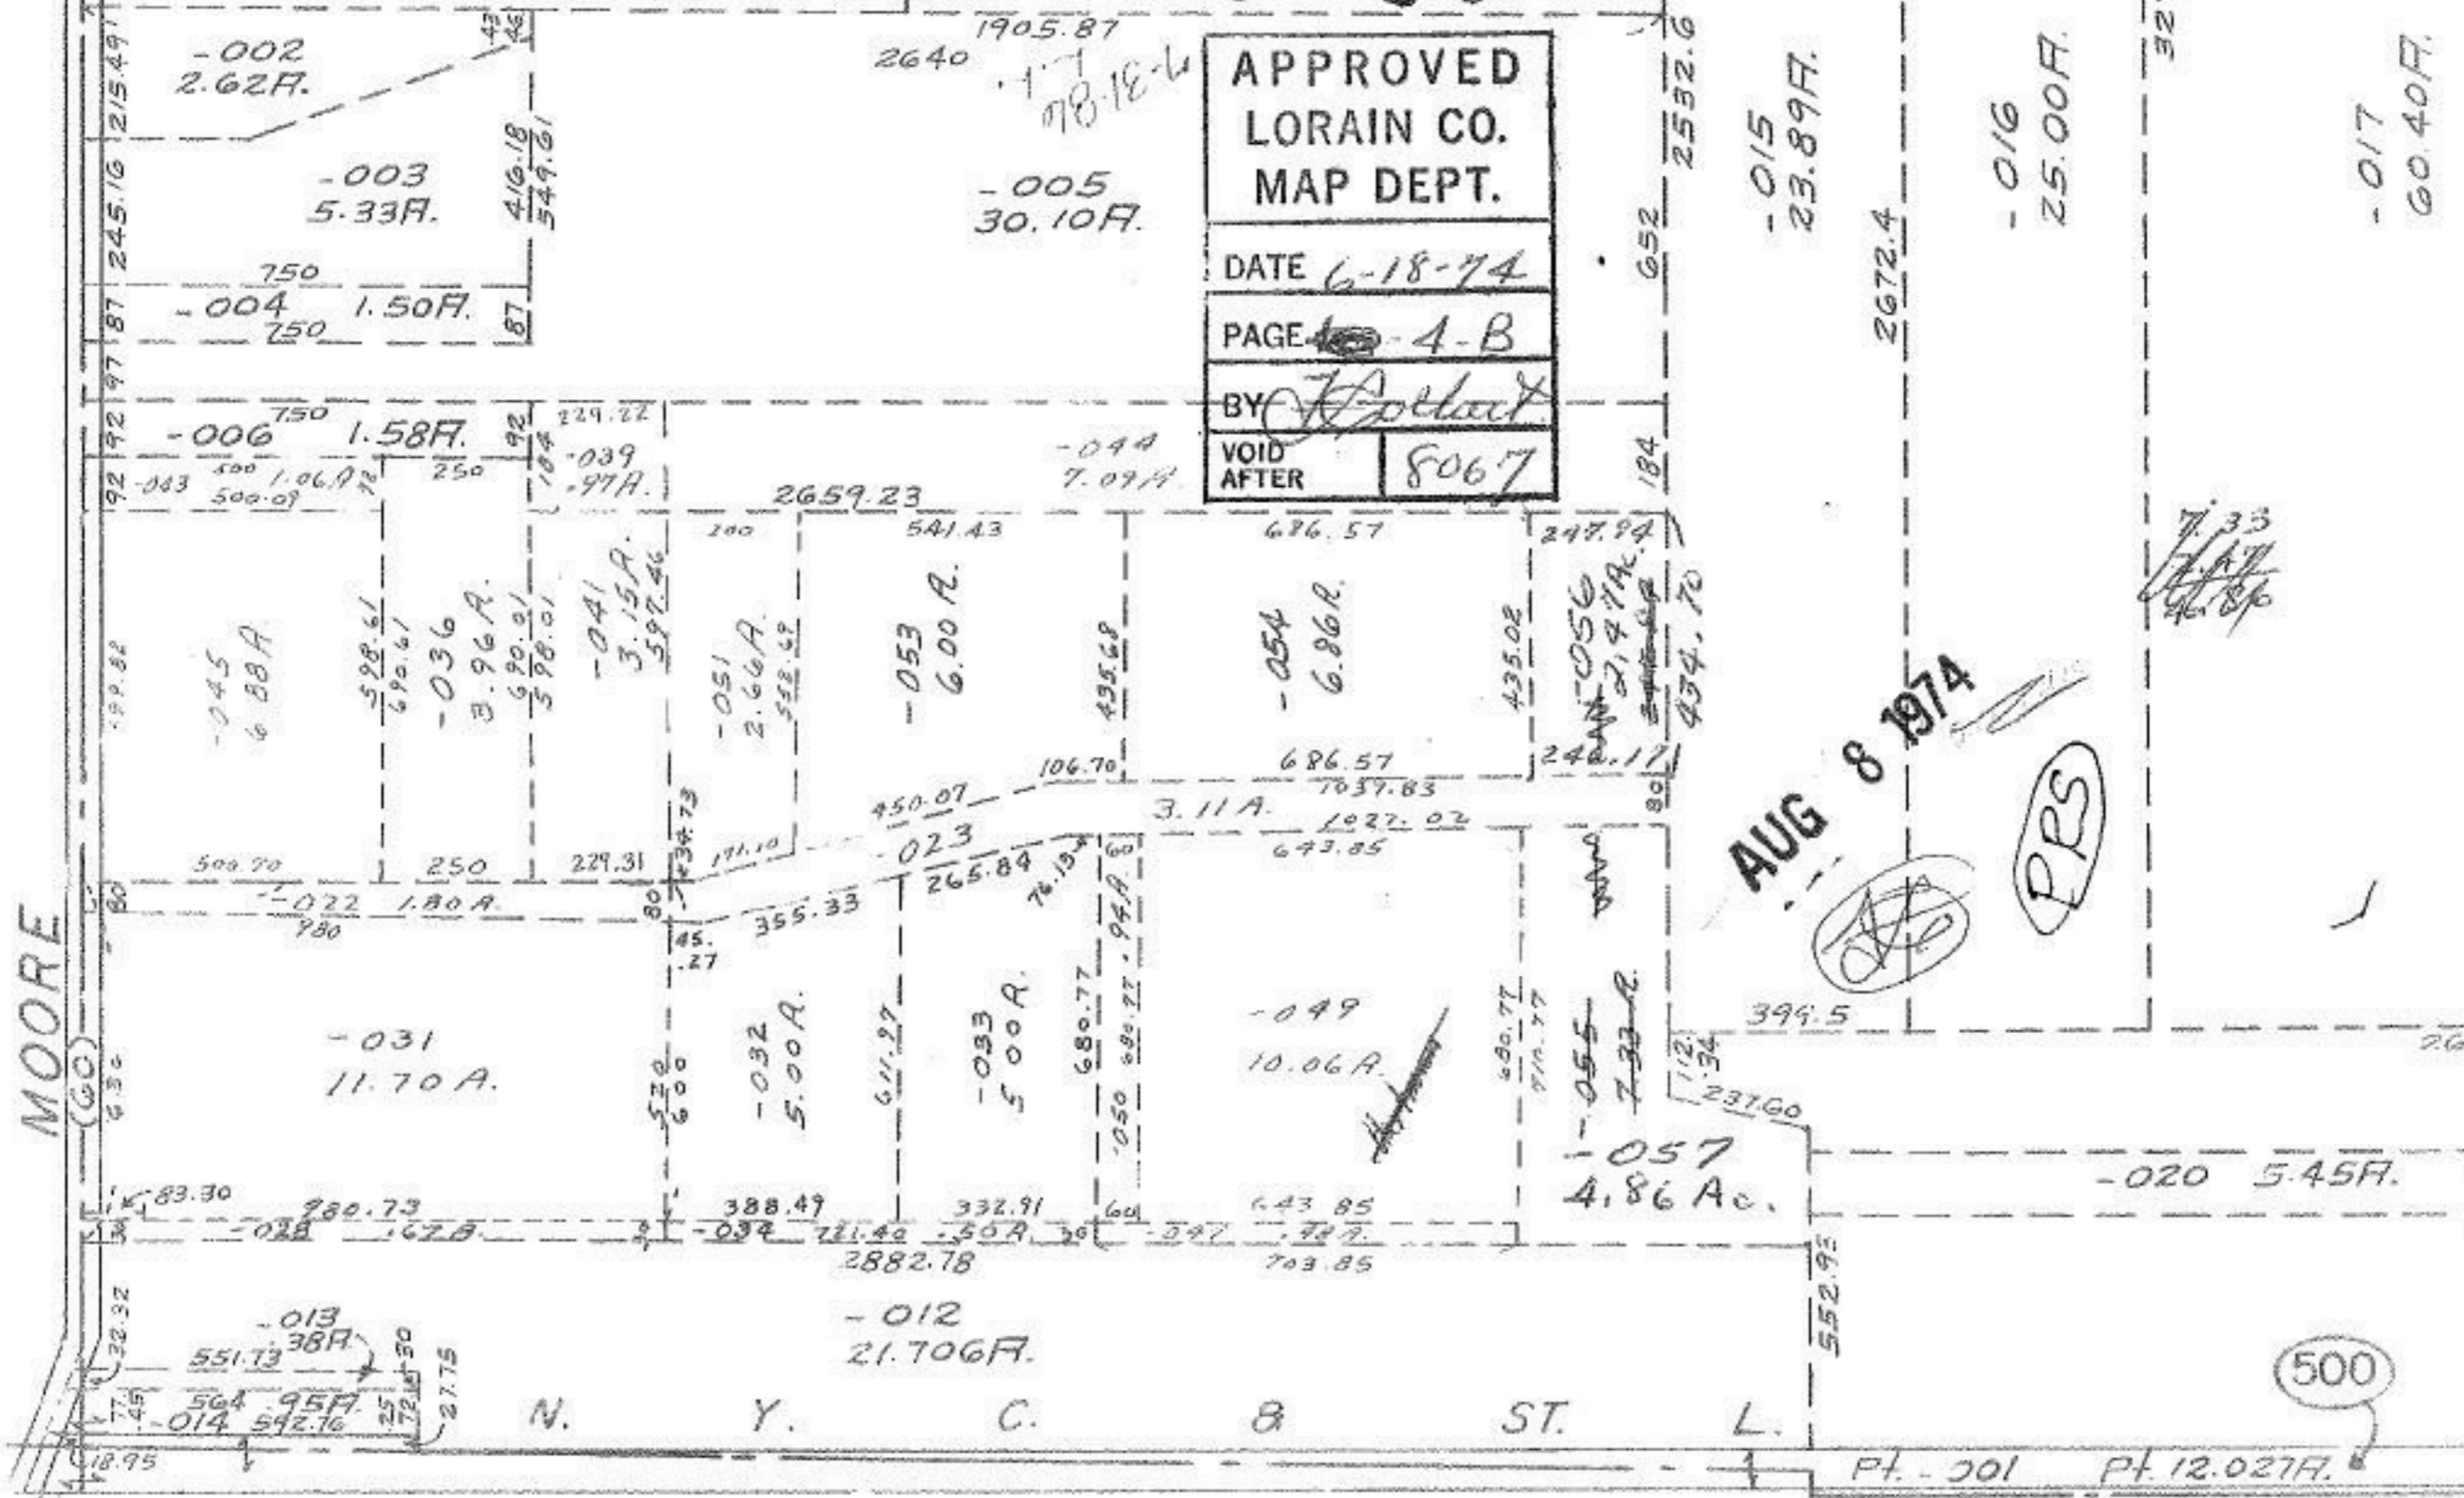

AUG 8 1974

PRS

500