


RAMELER

AVE

8074

37

103

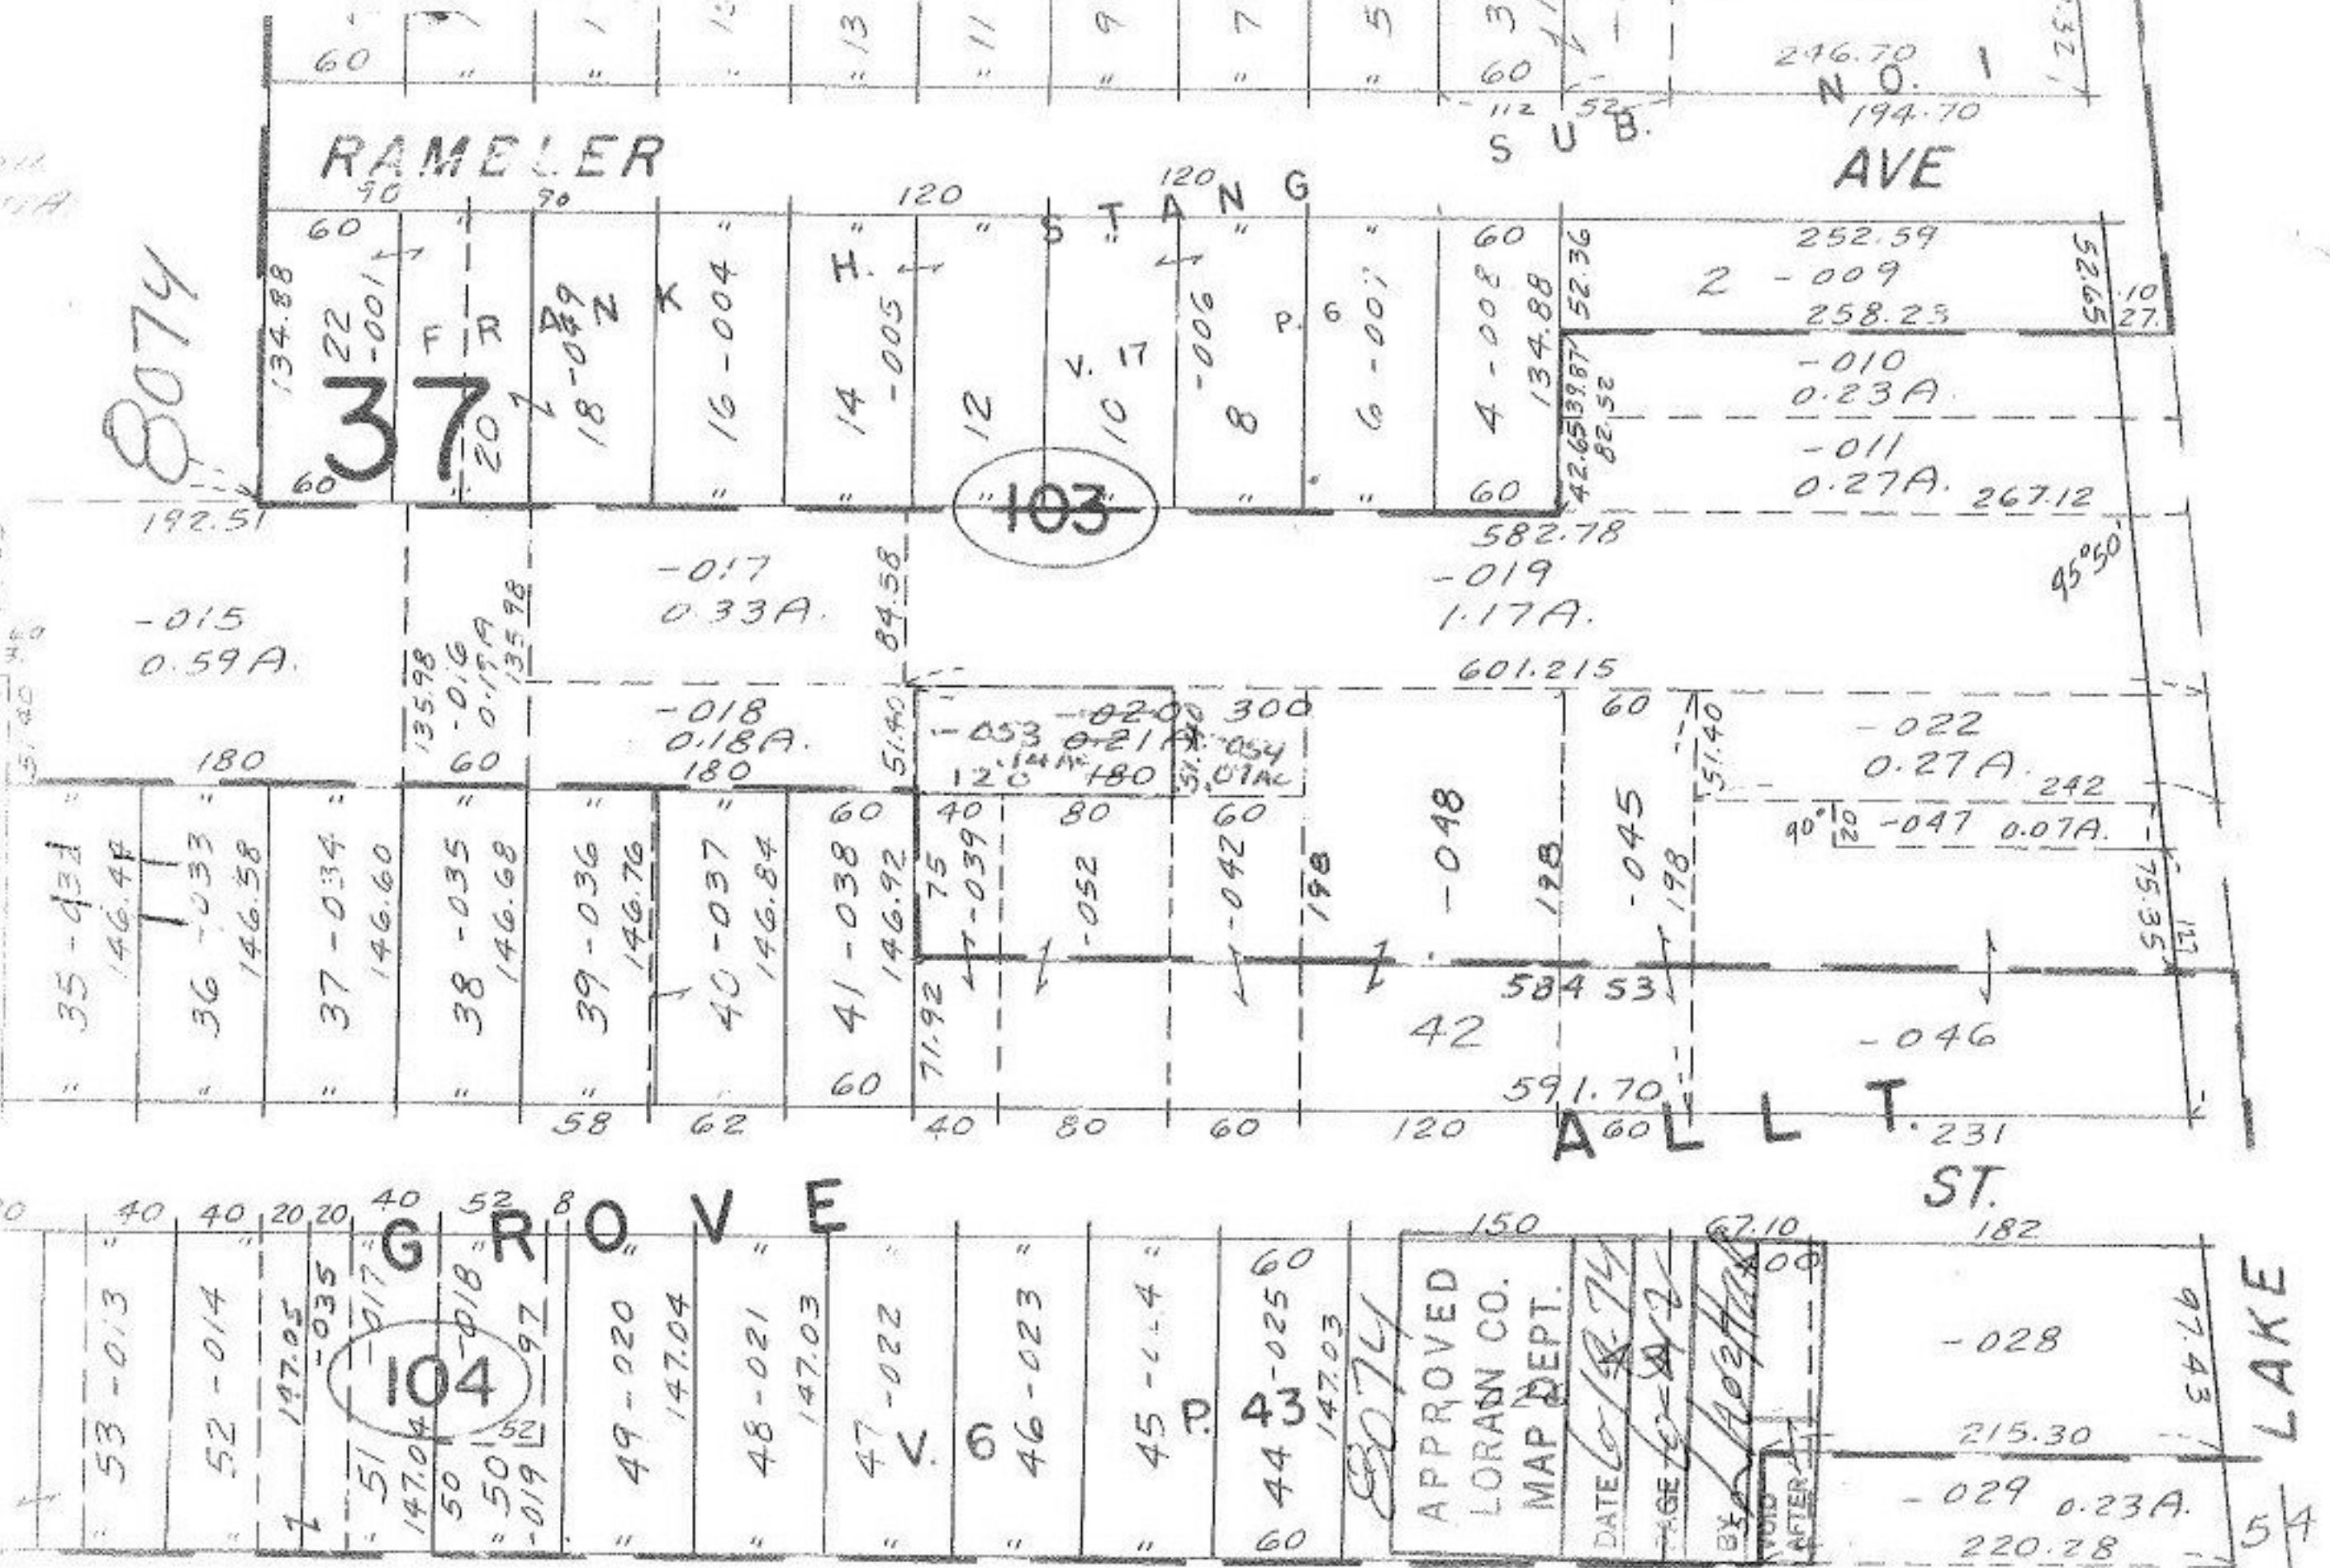

SEE 6-61

PRS



AUG 9 1974

LAKE

5A