

AUG 7 1974

PR5


8075

APPROVED
LORAIN CO.
MAP DEPT.
DATE 6-21-74
PAGE 12-02-0218
BY L W Hall
VOID AFTER

See Correct logs for This Comb
 on 8145-7-17-74 Changed from 90ft
 to 80ft L W Hall

ACK

1" = 100'

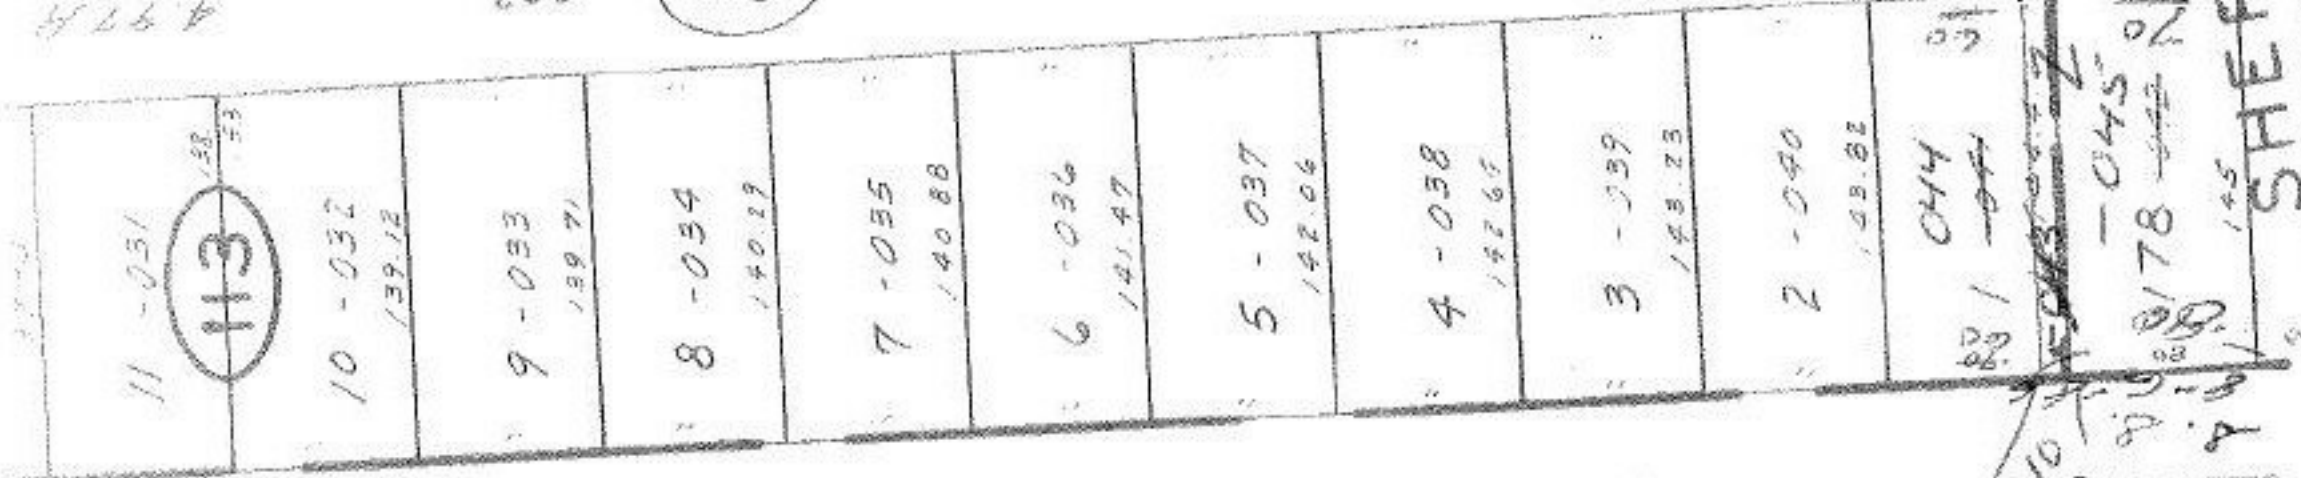

IVANHOE

FOREST

SHERWOOD VOL. 02-02-021-900-0

MEISTER

SEE 2-

RIVER TWP.