


-005
61.95 A.

8078

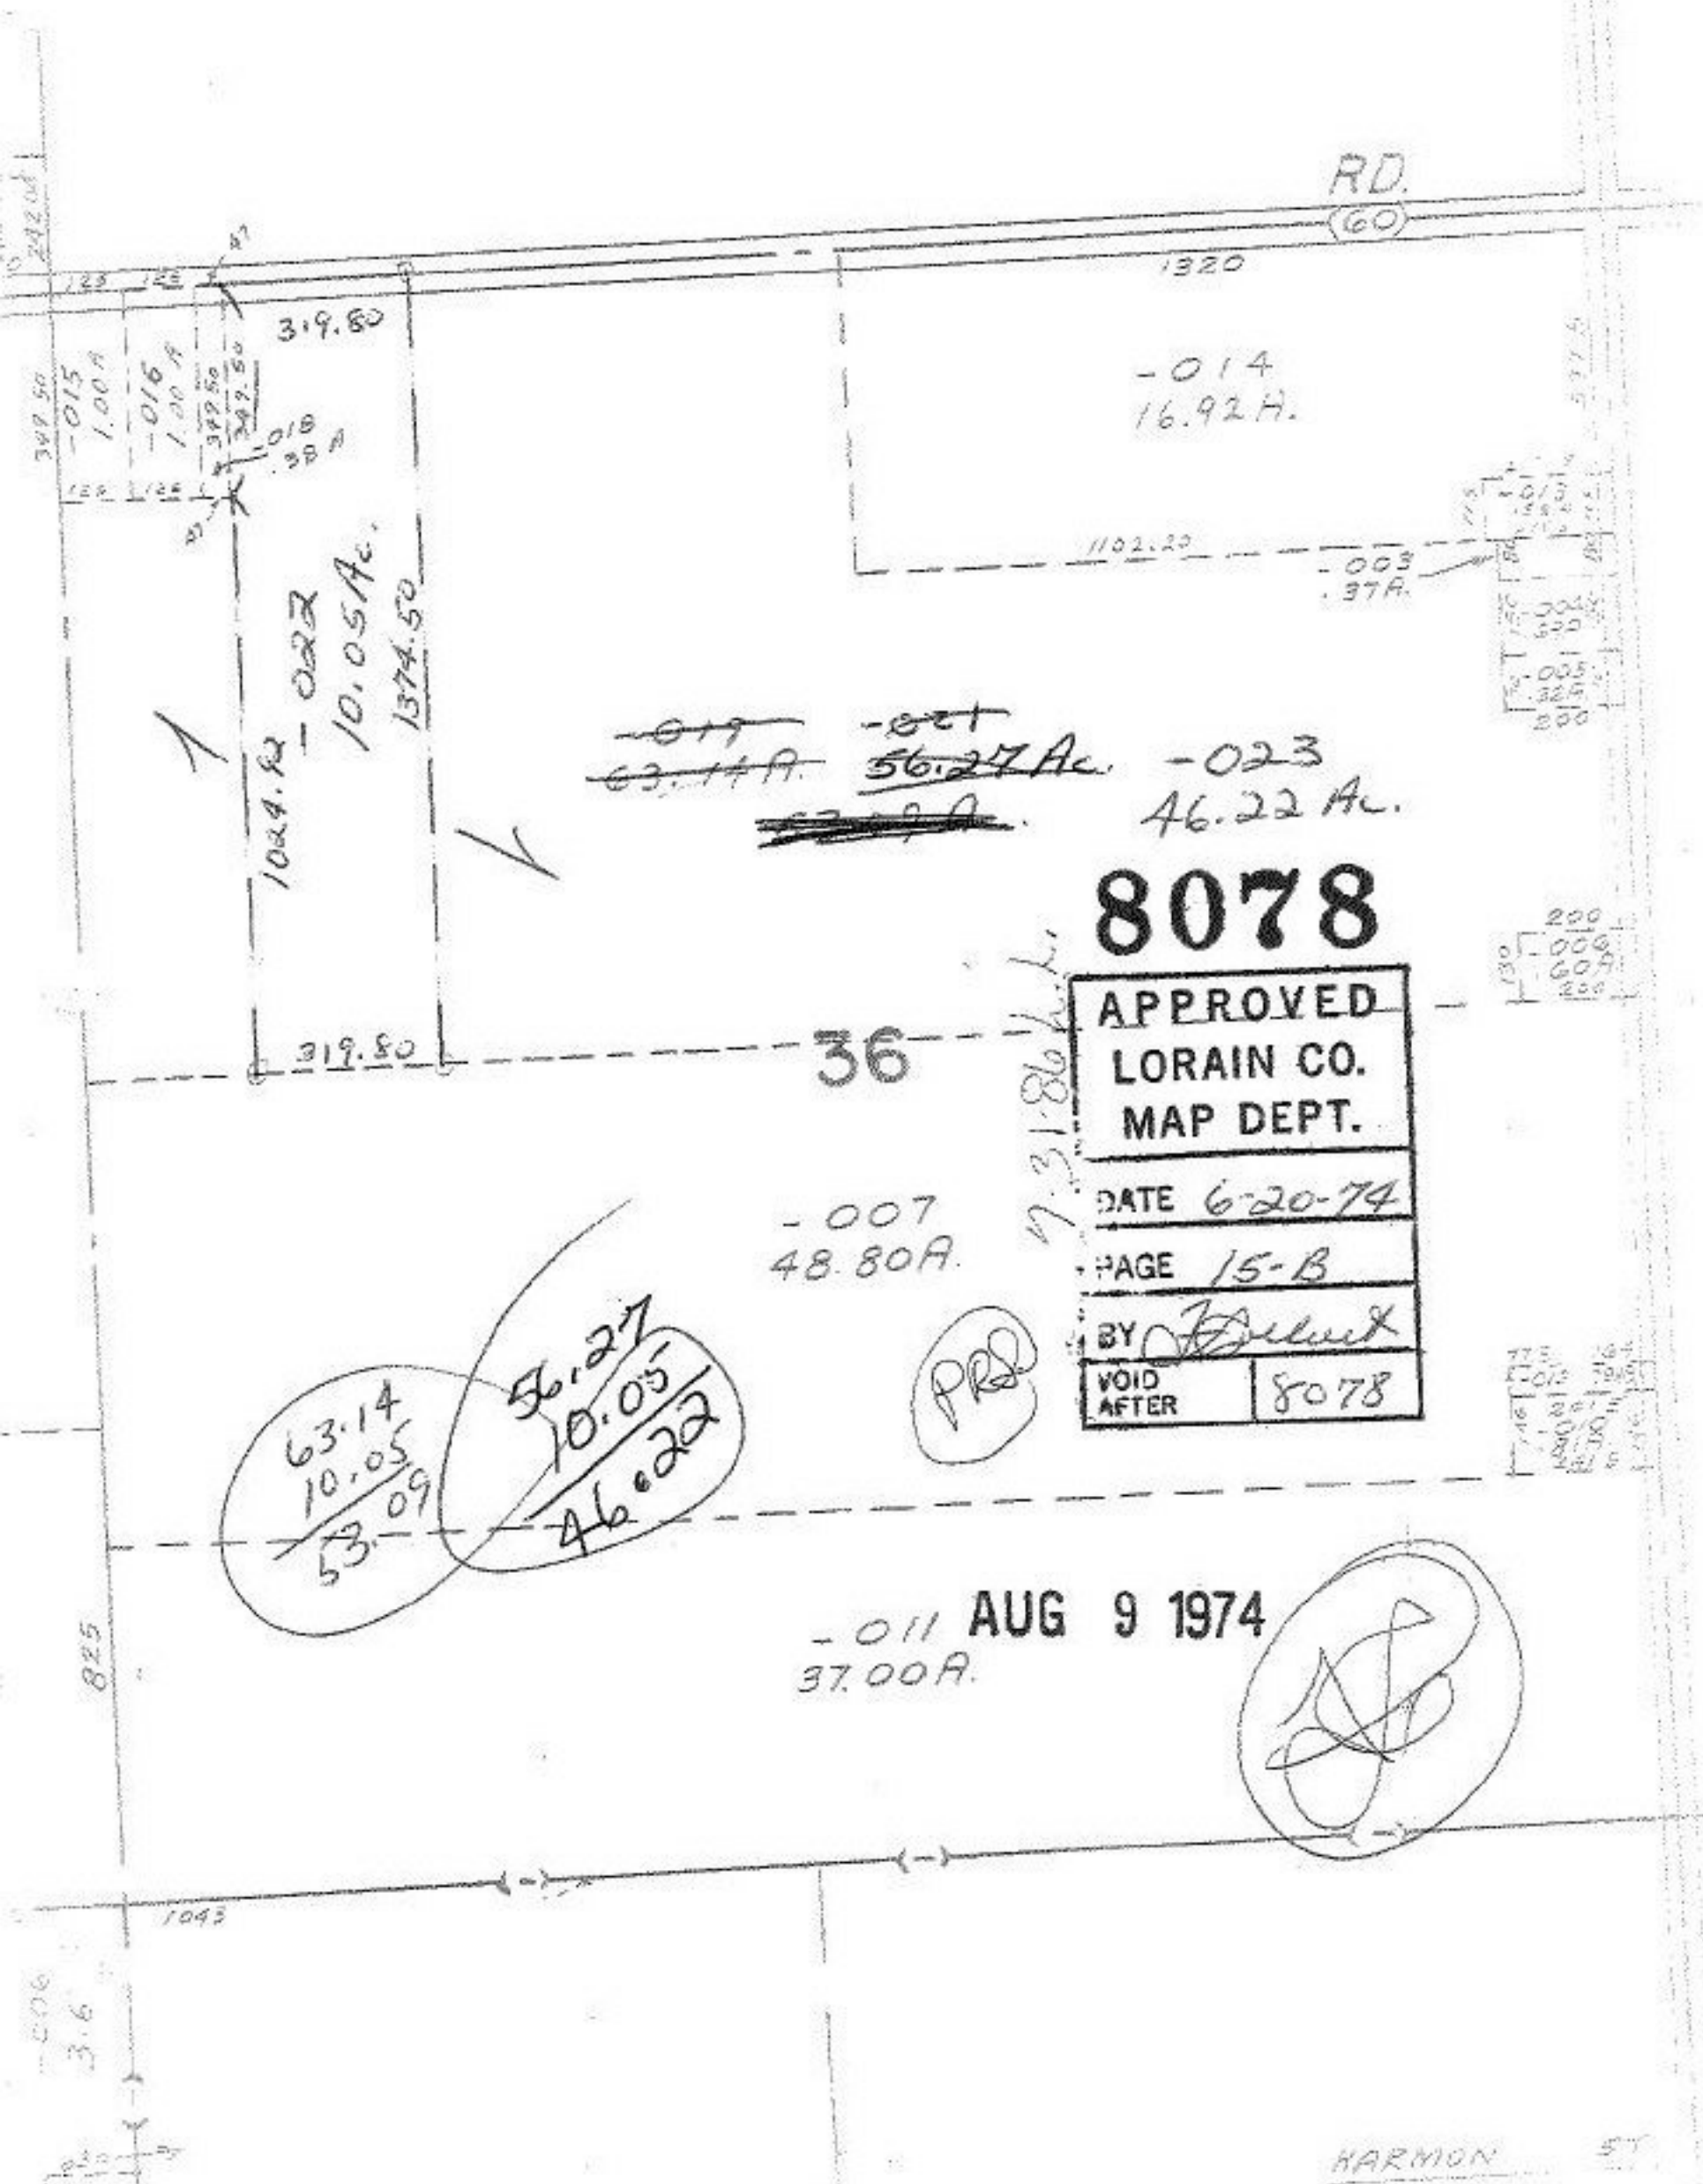

242.00

349.50

129

125

125

RD.

(60)

1320

-014
16.92 H.

1102.20

-003
37 A.

319.80

1024.92 - 022
10.05 Ac.
1374.50

319.80

36

8078

APPROVED
LORAIN CO.
MAP DEPT.

DATE 6-20-74

PAGE 15-B

BY *[Signature]*

VOID AFTER 8078

-007
48.80 A.

63.14
10.05
53.09

56.27
10.05
46.22

PRD

-011 AUG 9 1974
37.00 A.

[Handwritten signature]

HARMON ST