


SEE 7

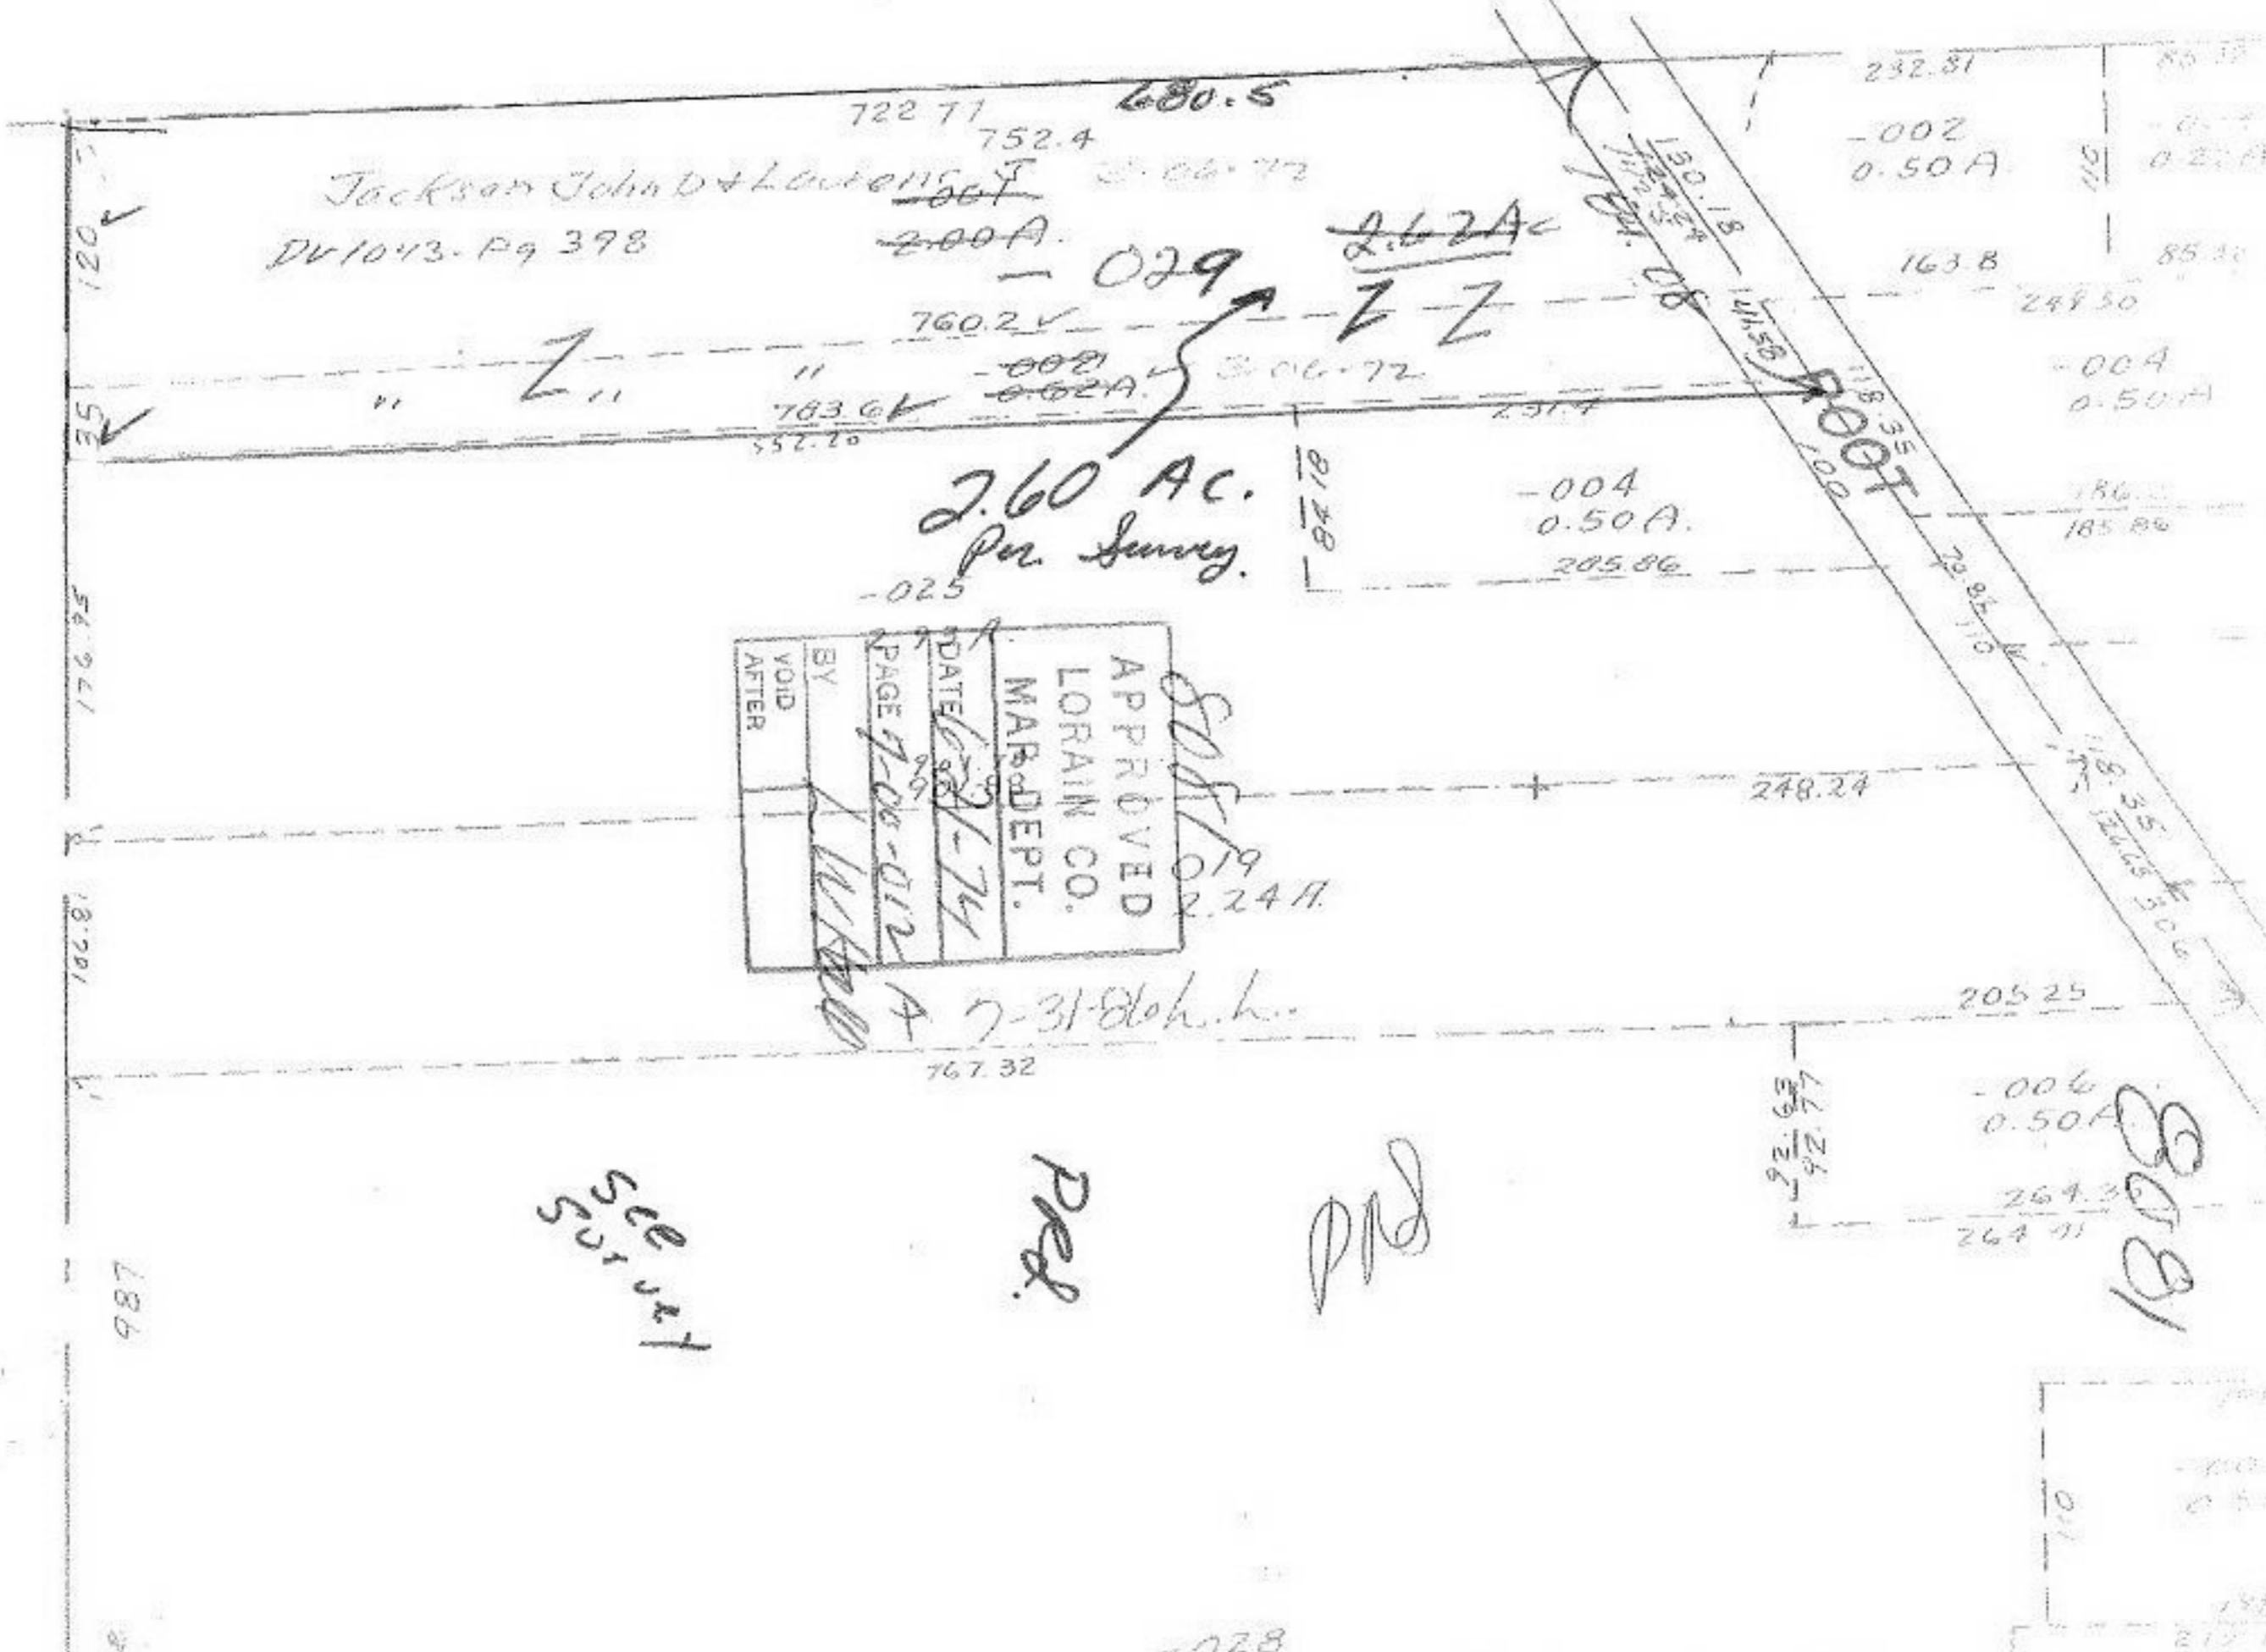

Jackson John D & Lantieri
 DV 1043-Pg 398

2.60 AC.
 Per Survey.

| | |
|------------|-------------|
| DATE | 7-1-74 |
| PAGE | 7-06-012 |
| BY | [Signature] |
| VOID AFTER | |

PREP.

SECRET

8081

-028