


4
7
11 12
15 16

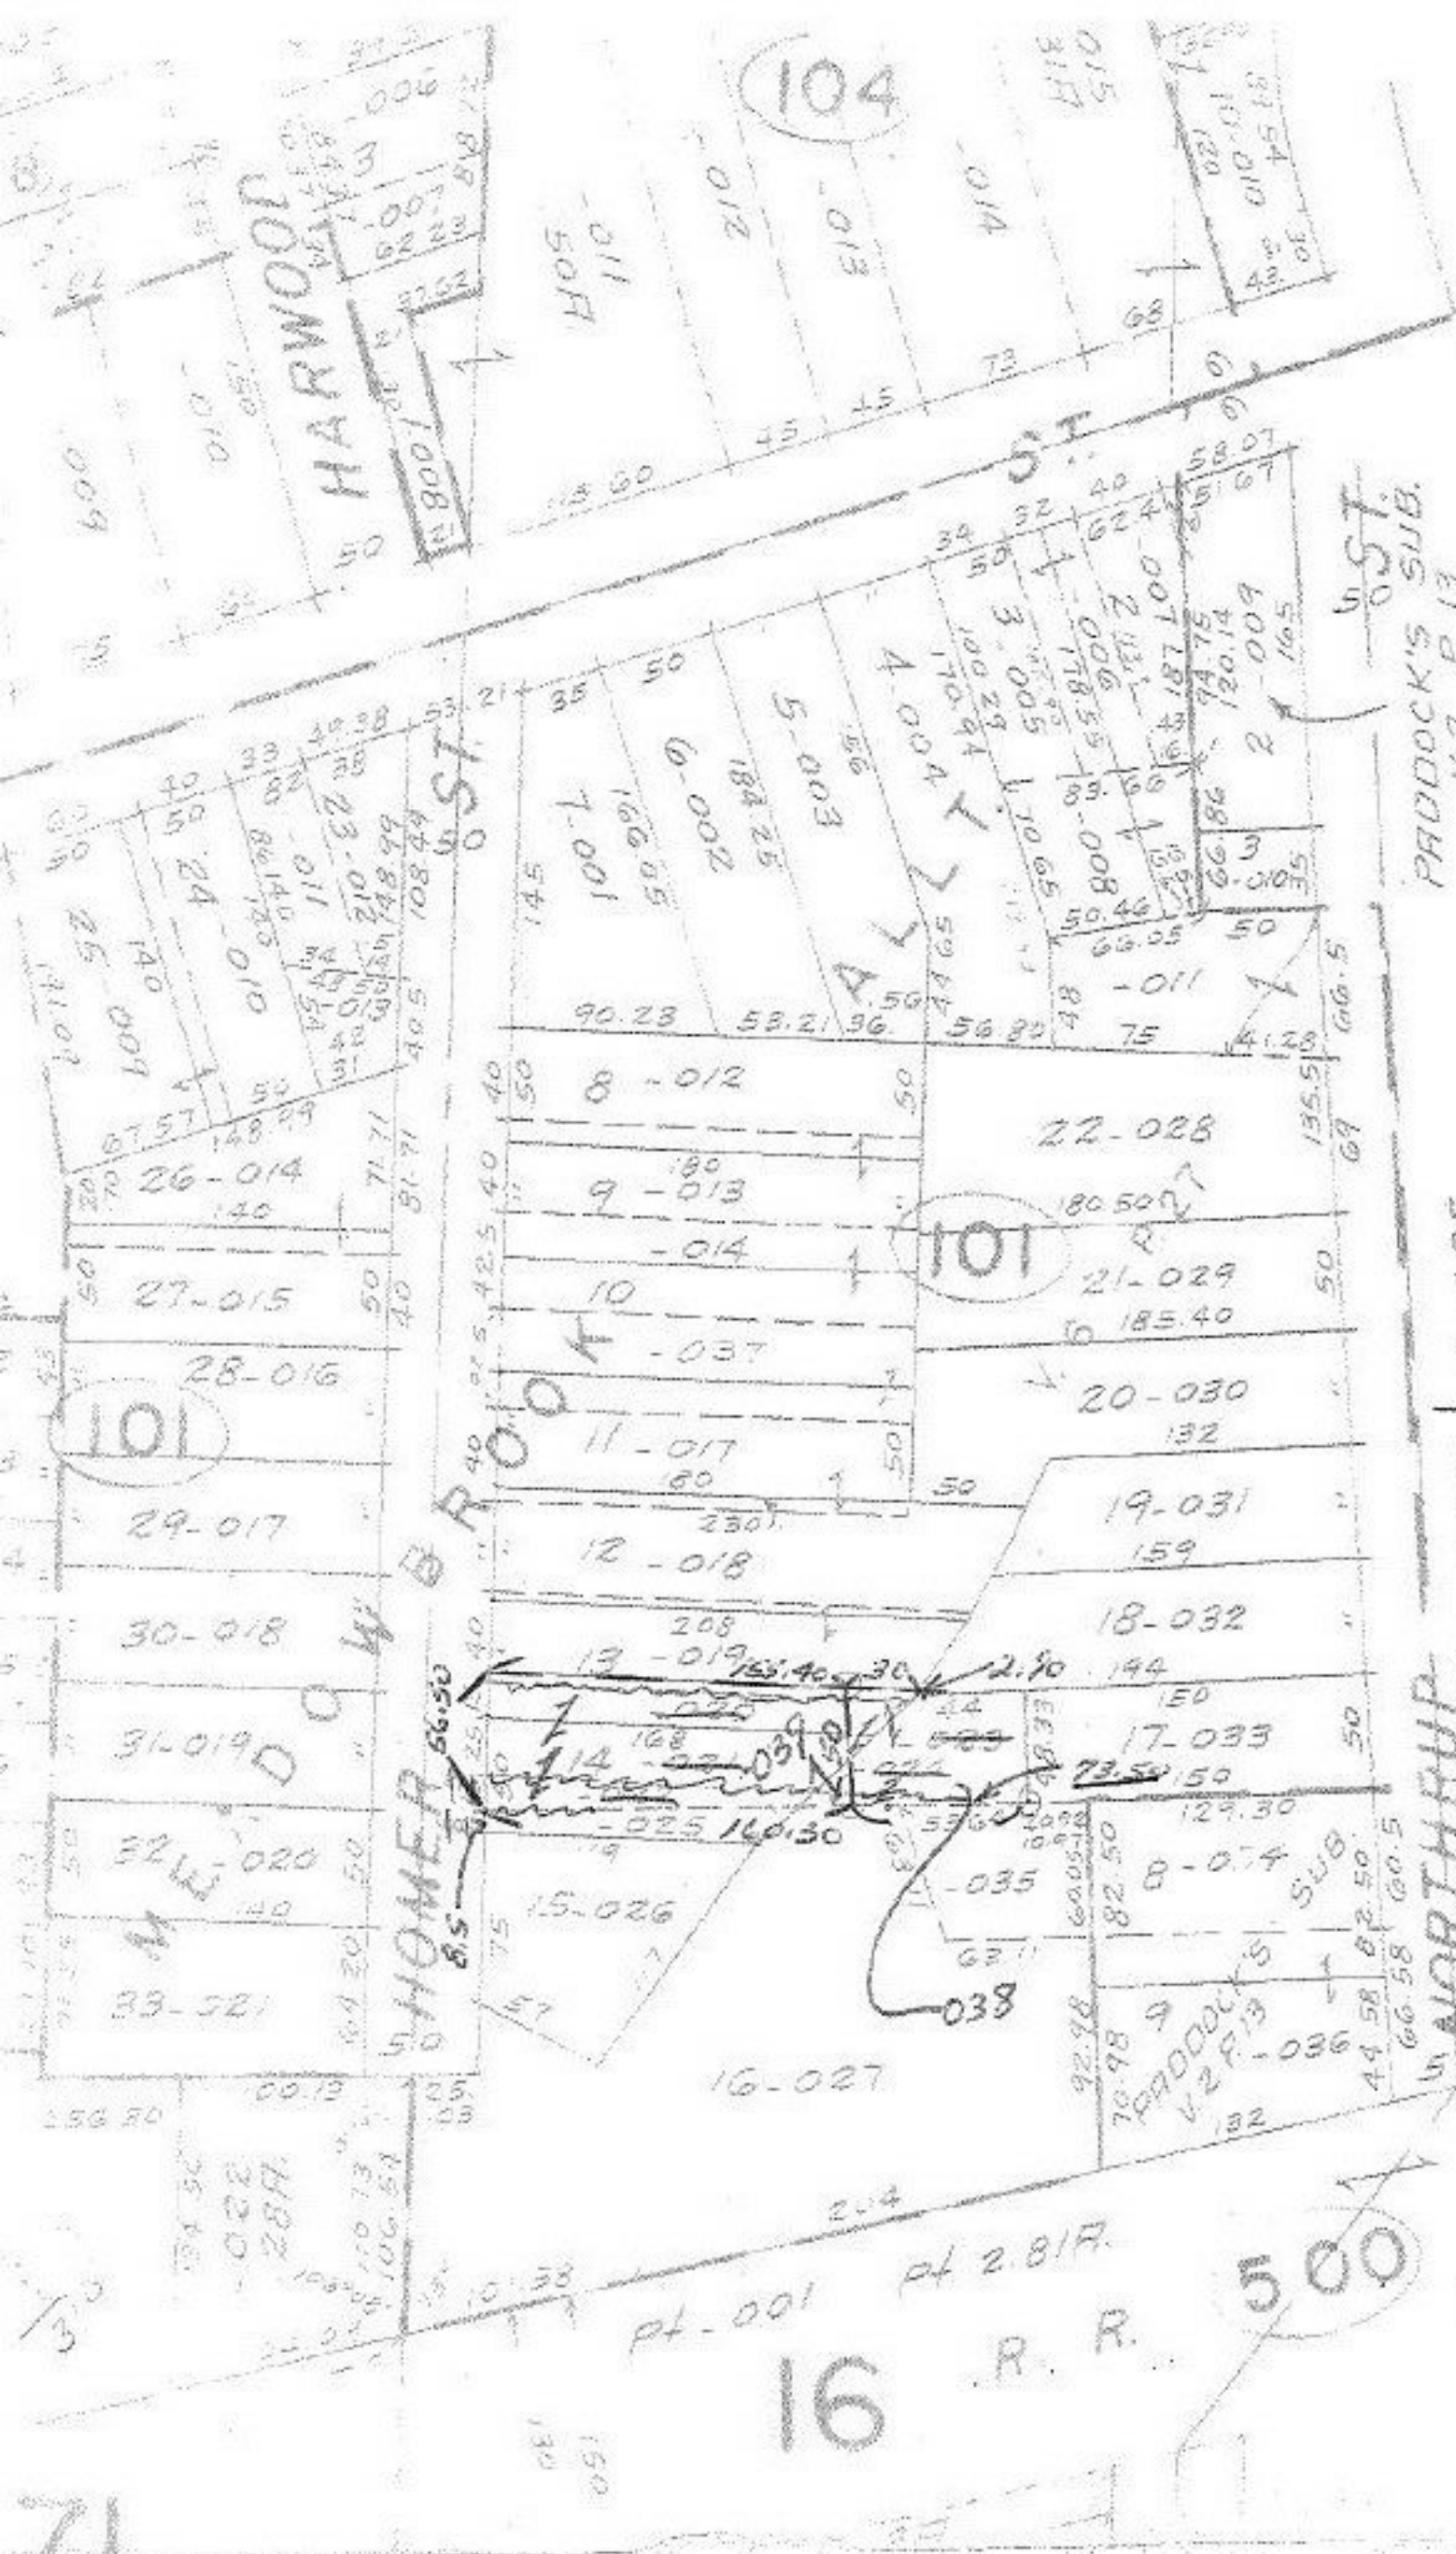

SEE SURVEY

AUG 9 1974

SEE 6-105



8100

APPROVED LORAIN CO. MAP DEPT.	
DATE 7-9-74	
PAGE 6-104	
BY <i>[Signature]</i>	
VOID AFTER	8100

PRS

28

16 R.R.

500

71