


CUR

578

~~578~~

~~578~~

578.15

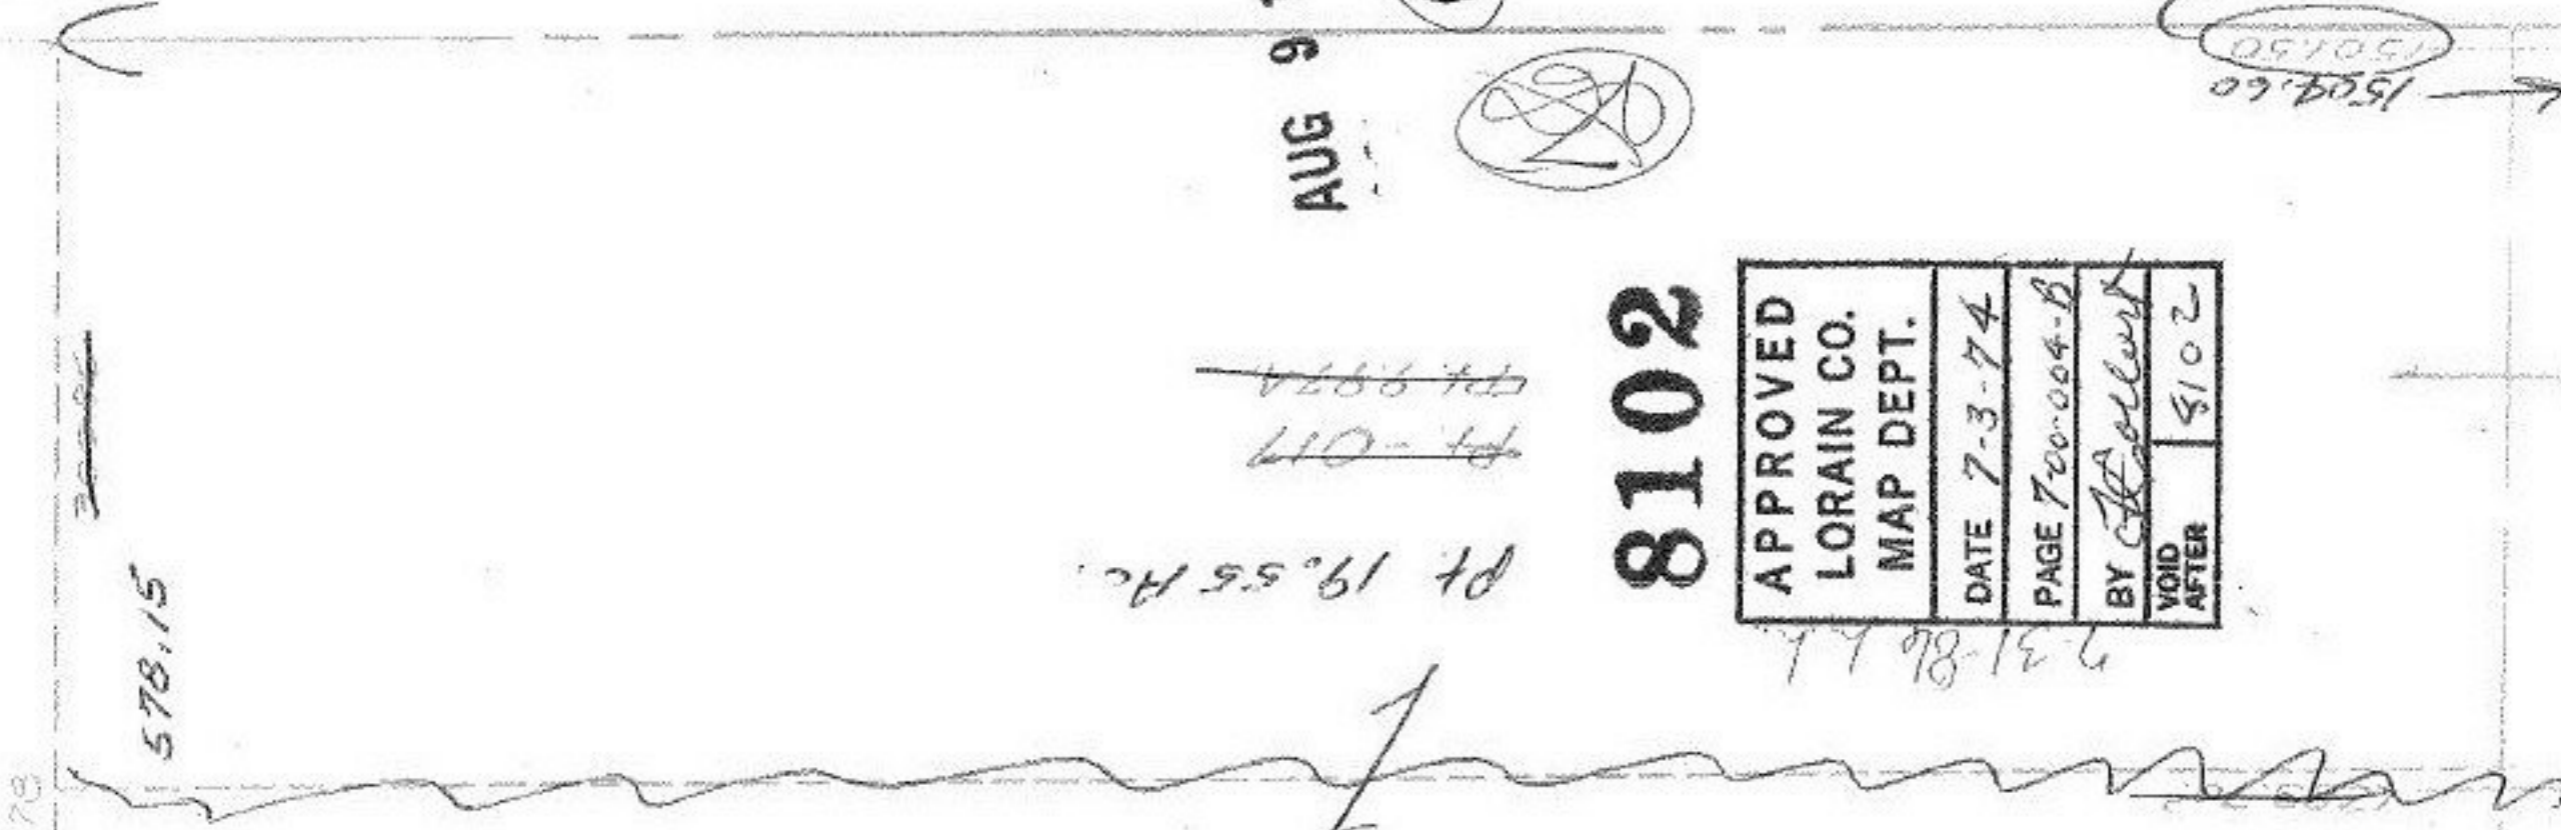

Pt 19.55 Ac.

Pt - 049

~~Pt 016~~  
~~Pt 99A~~

~~Pt - 017~~  
~~Pt 99A~~

AUG 9 1974

PRS

108

8102

APPROVED	
LORAIN CO.	
MAP DEPT.	
DATE	7-3-74
PAGE	700-004-B
BY	<i>W. J. ...</i>
VOID AFTER	\$102

7-31-86 L.L.

1509.60  
1504.50

1295.46

1292