
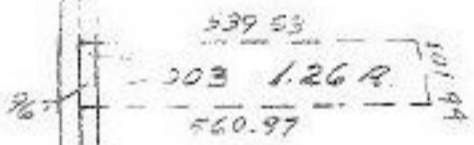


-004
43.00 F.

8132

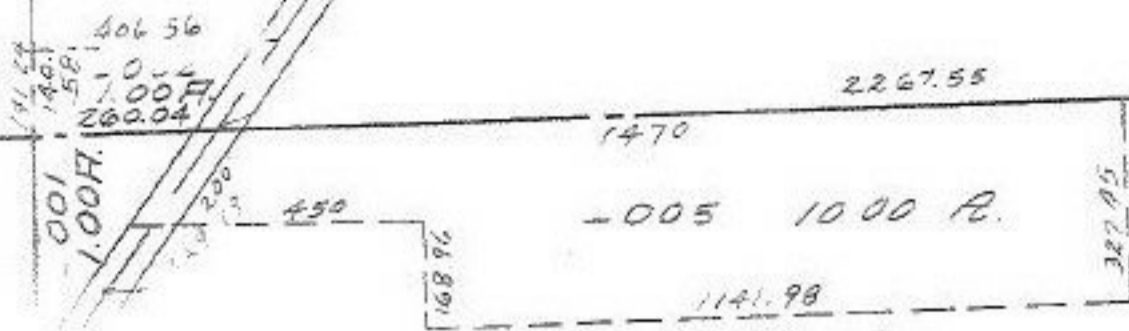

8132

37

See Survey


-010
~~-006~~
~~93.58 F.~~
~~1.35~~
~~92.20 Ac.~~
 90.82 Ac.

PRD

2592

APPROVED LORAIN CO. MAP DEPT.	
DATE 7-16-74	
PAGE 14-C	
BY <i>[Signature]</i>	
VOID AFTER	8132

AUG 9 1974

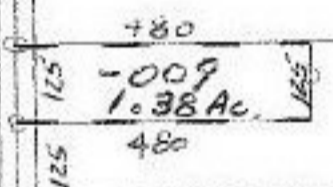

003
10 F.
500

-001
13.33 F.

-002
6.67 F.

-003
30.00 F.

44




-007
26.00 A

-004
23.00 F.

2440.80

-001 7.00 F.

-002
3.00 F.

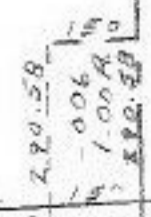

290.62