

8/47

-008
73.67A

2069.52
1469.52

600.00

8

-005
1.33

525
944.52

1469.52

2069.21

-02

031

~~026~~
43.96 R.
42.96 AC

1063

350 015 -004 350	350 -021 -80 R 350	350 017 -80 R	350 023 80 R	350 025 80 R 350	350 030 80 R 350
---------------------------	-----------------------------	---------------------	--------------------	---------------------------	---------------------------

219
204 R

144.52

(60)

8/47


APPROVED
LORAIN CO.
MAP DEPT.

DATE 7-22-74

PAGE 11 D

BY L. W. Hall

VOID AFTER

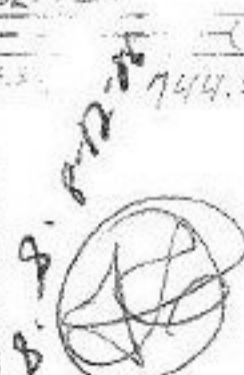

AUG 9 1974

00-007-B

7

-001
40.00 A.

029
11.50 R.

1042.23

435.5

326.70
023 R
020 R
326.70

030
-005
1.07 A
360

-0.4
38 0.2

-011
2.67 A

-0.2
580.02
42.00

365
1.00 A
365

