


Note Take line Out

SEE 4-00-007-E

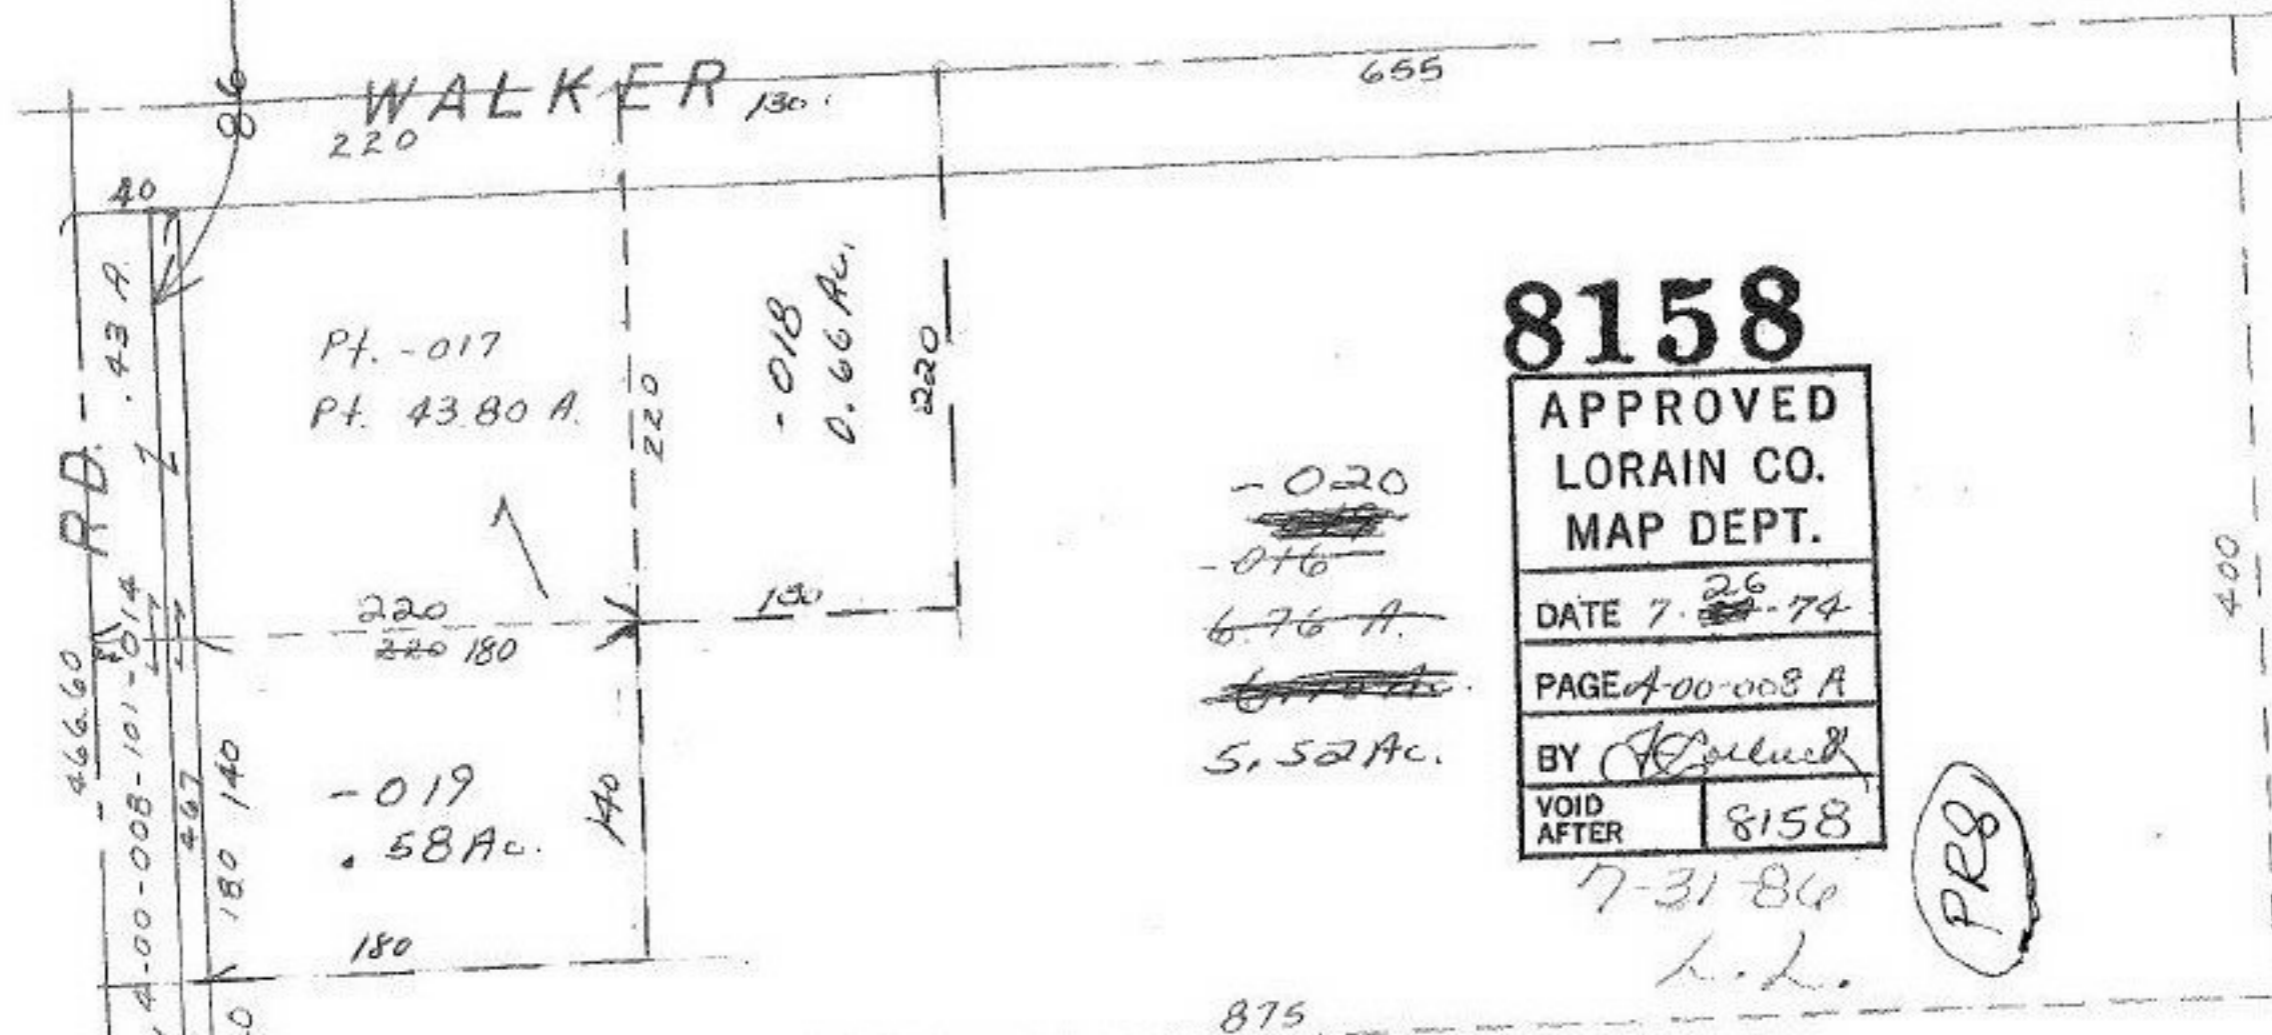

# 8158

APPROVED  
LORAIN CO.  
MAP DEPT.

DATE 7. <sup>26</sup>~~24~~-74

PAGE 4-00-008 A

BY *J. Belluck*

VOID AFTER 8158


7-31-86  
L.L.

PR8



AUG 8 1974

RD. 43 A  
466.60  
4-00-008-101-014  
467  
180 140  
40

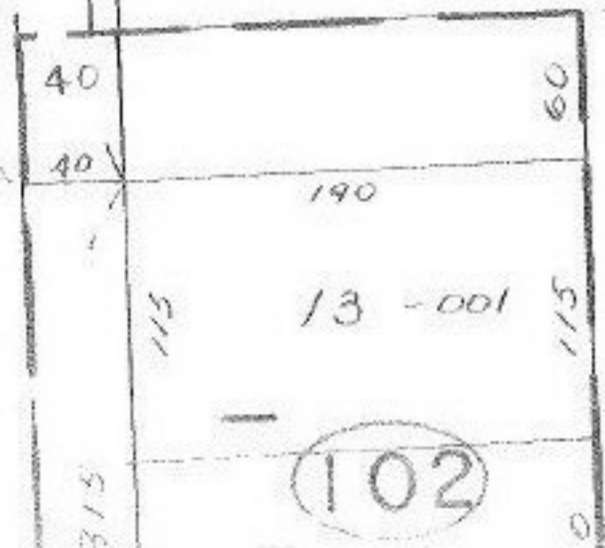

6.76  
+ .66  
-----  
6.10  
+ .58  
-----  
5.52

466.60  
320  
-----  
146.60

220  
43  
-----  
177  
140  
-----  
317

Pt -017  
Pt 43.80 A