

8/61

003  
~~001~~  
+11-00-A Dup  
~~11-00-A~~ Map  
106.00 AC

-001  
101.27 A

3

2

8/61


APPROVED
LORAIN CO.
MAP DEPT.
DATE 7-26-74
PAGE 19 F
BY LWH
VOID AFTER

AUG 13 1974

*(Handwritten signature)*

R  
R

A

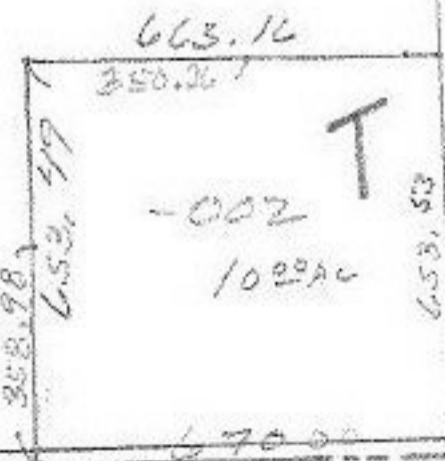

SMITH

# PENFIELD TWP.

SCALE: 1" = 400'