

8177

Sec 10-00-003 F

0-00-003-F

125-017  
3A

037  
.38A  
203

543.45  
219.33  
150  
75  
75

8177

APPROVED  
MORAIN CO.  
MAP DEPT.

DATE 8-2-74

PAGE 10-00-008B + 10-00-003 F

BY L W Hall

VOID AFTER

004  
94 A.


PR

559.23  
10-00-003 F  
005  
95 A.  
552.15  
006  
95 A.

007  
1.72A.

008  
1.69A.

009  
2.87A.

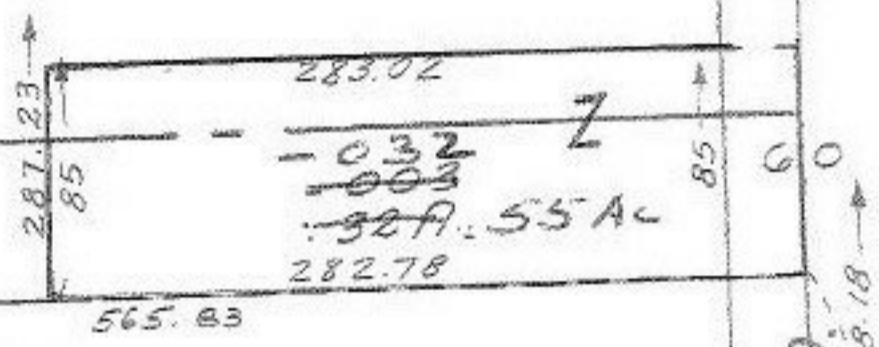


RD. 0  
658.18

150  
300

100  
75

663.75

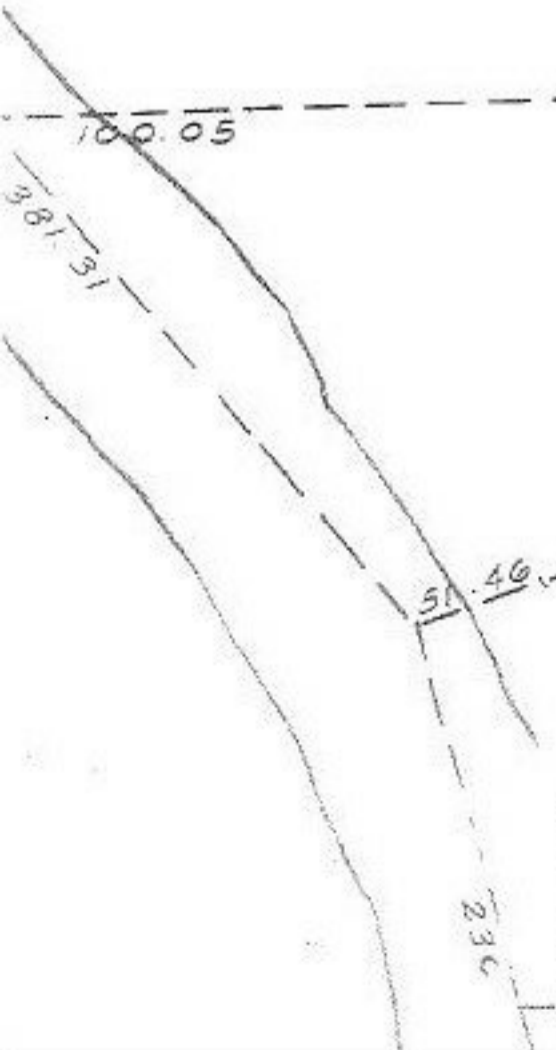

120.77  
396.56