


654.90
218.79
473.11

153.67
31.17
22.50

-006
20.01

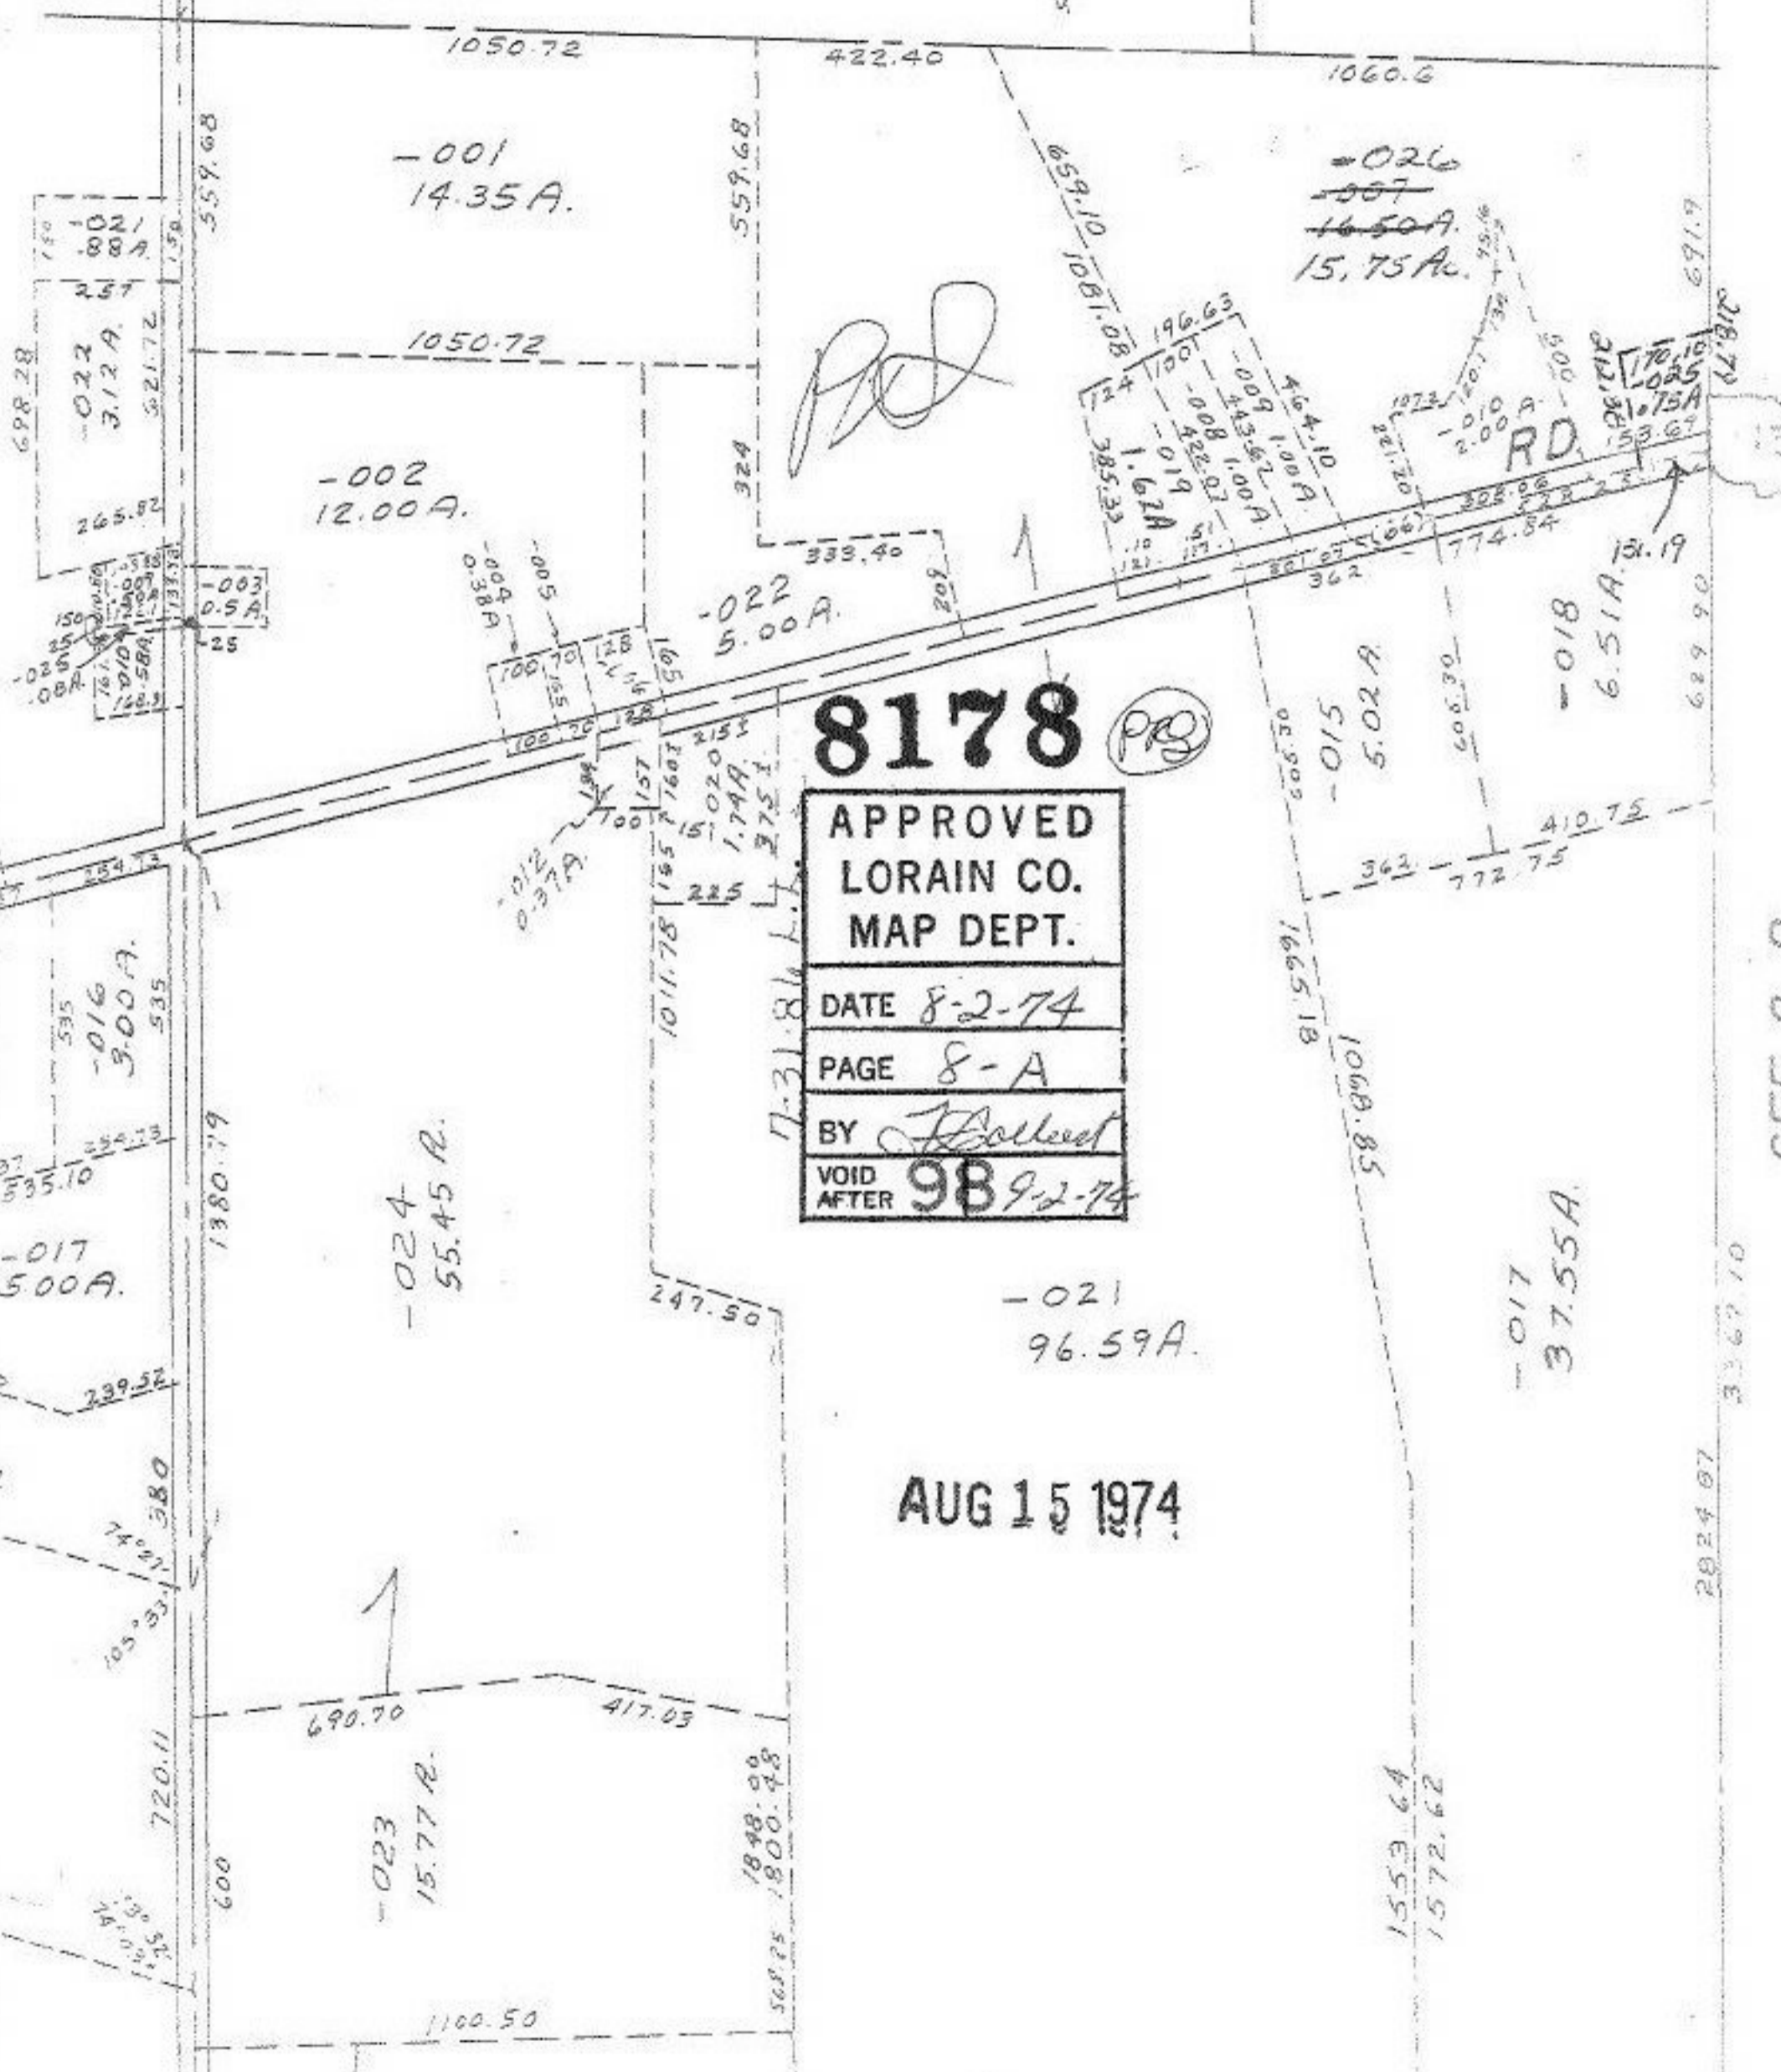

8178

APPROVED
LORAIN CO.
MAP DEPT.
DATE 8-2-74
PAGE 8-A
BY *Holler*
VOID AFTER 989-2-74

AUG 15 1974

SEE 8-B

2824 07
3367.10