


8179

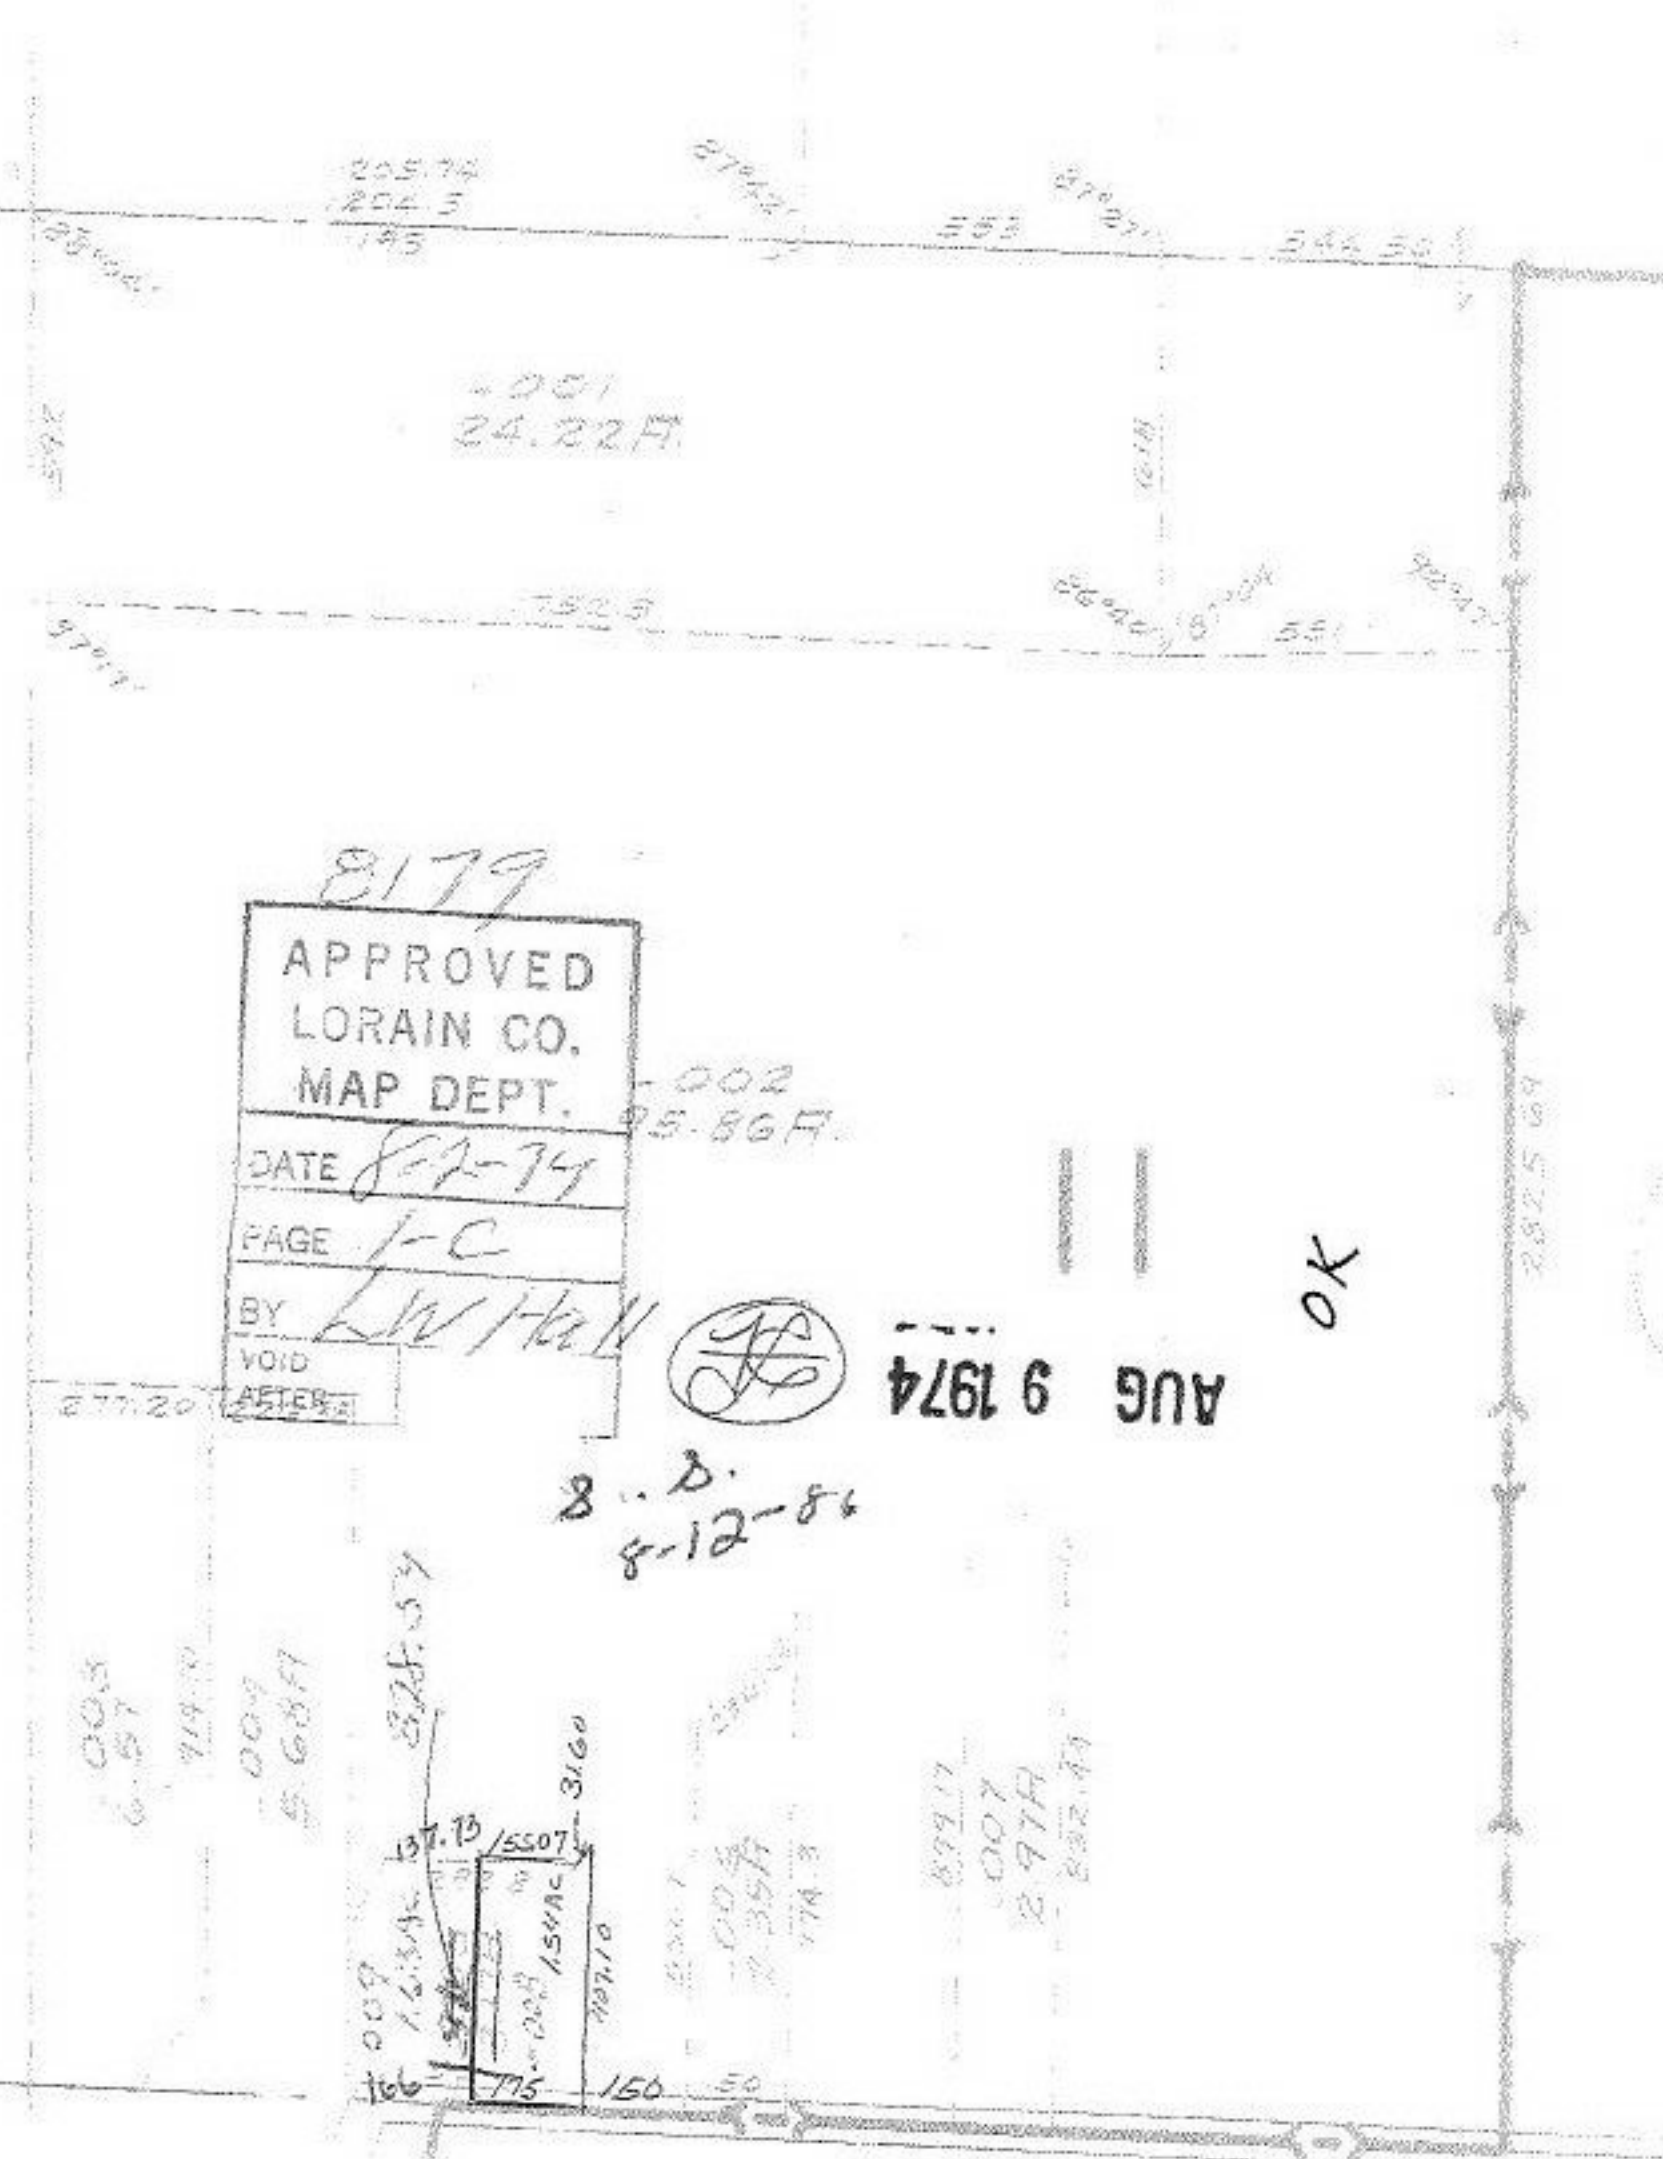

8179

APPROVED
LORAIN CO.
MAP DEPT.

DATE 8-2-74

PAGE 1-C

BY LW Hall

VOID AFTER

002 95.86 FT.

AUG 9 1974

OK

8-12-84

292.80
155.07
137.73

361
175
166

TWD