


8181



AUG 9 1974

APPROVED	
LORAIN CO.	
MAP DEPT.	
DATE 8-5-74	
PAGE 9-00-100-A	
BY <i>J. Gilbert</i>	
VOID AFTER	9-5-74

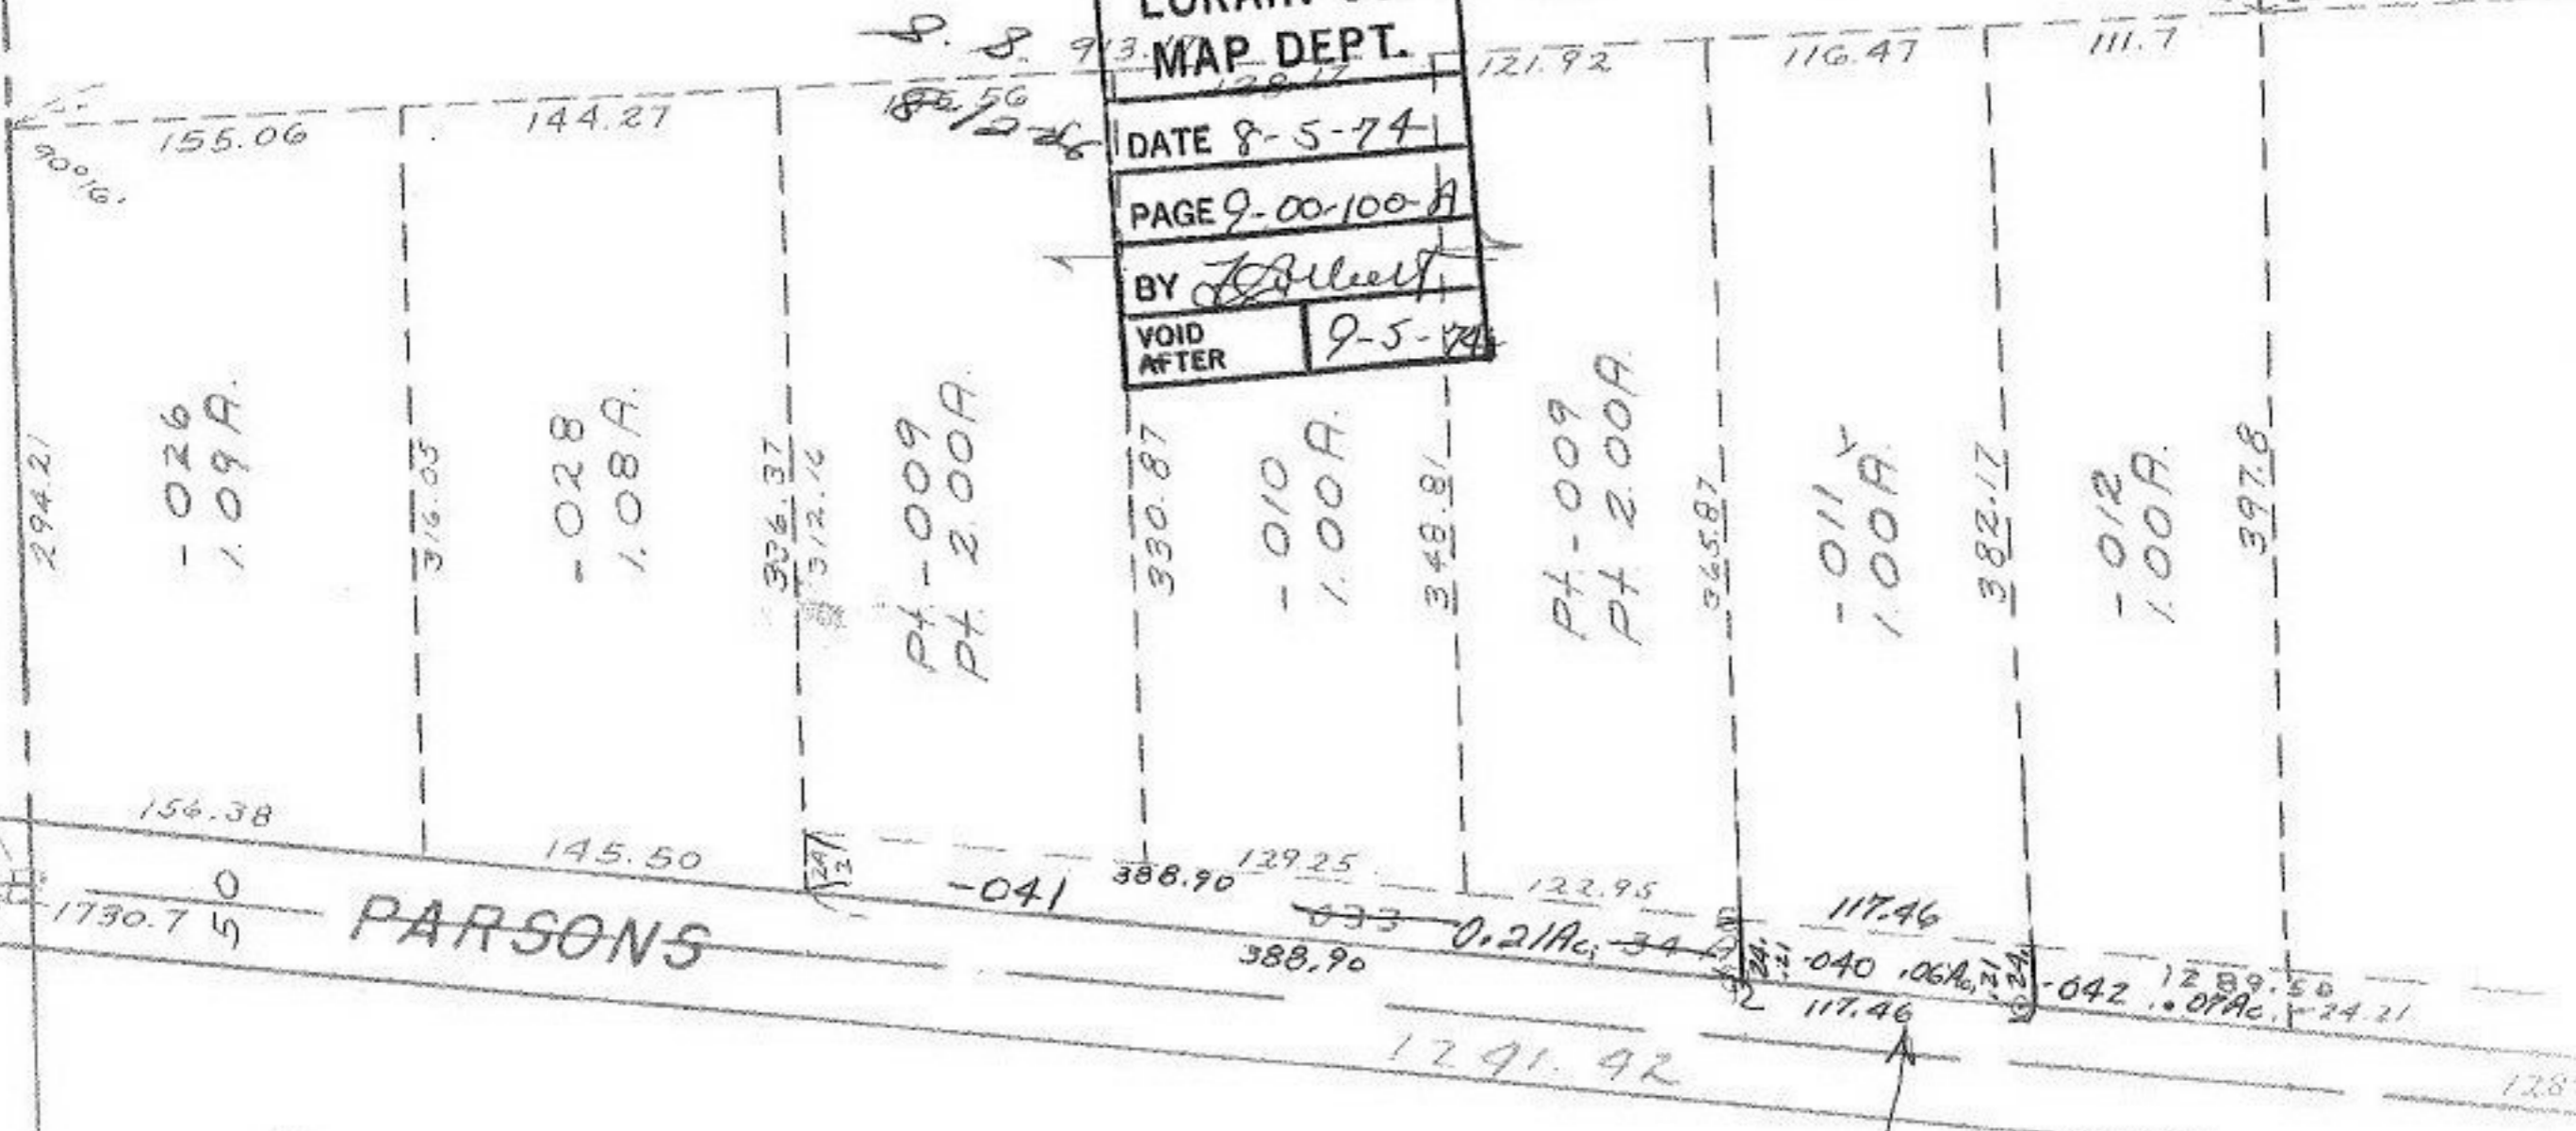

$388.90 \times 24.21 = 0.216$
 $117.46 \times 24.21 = 0.065$
 $112.50 \times 24.21 = 0.063$

PRB
 34
 27
 ①