


B/86

254

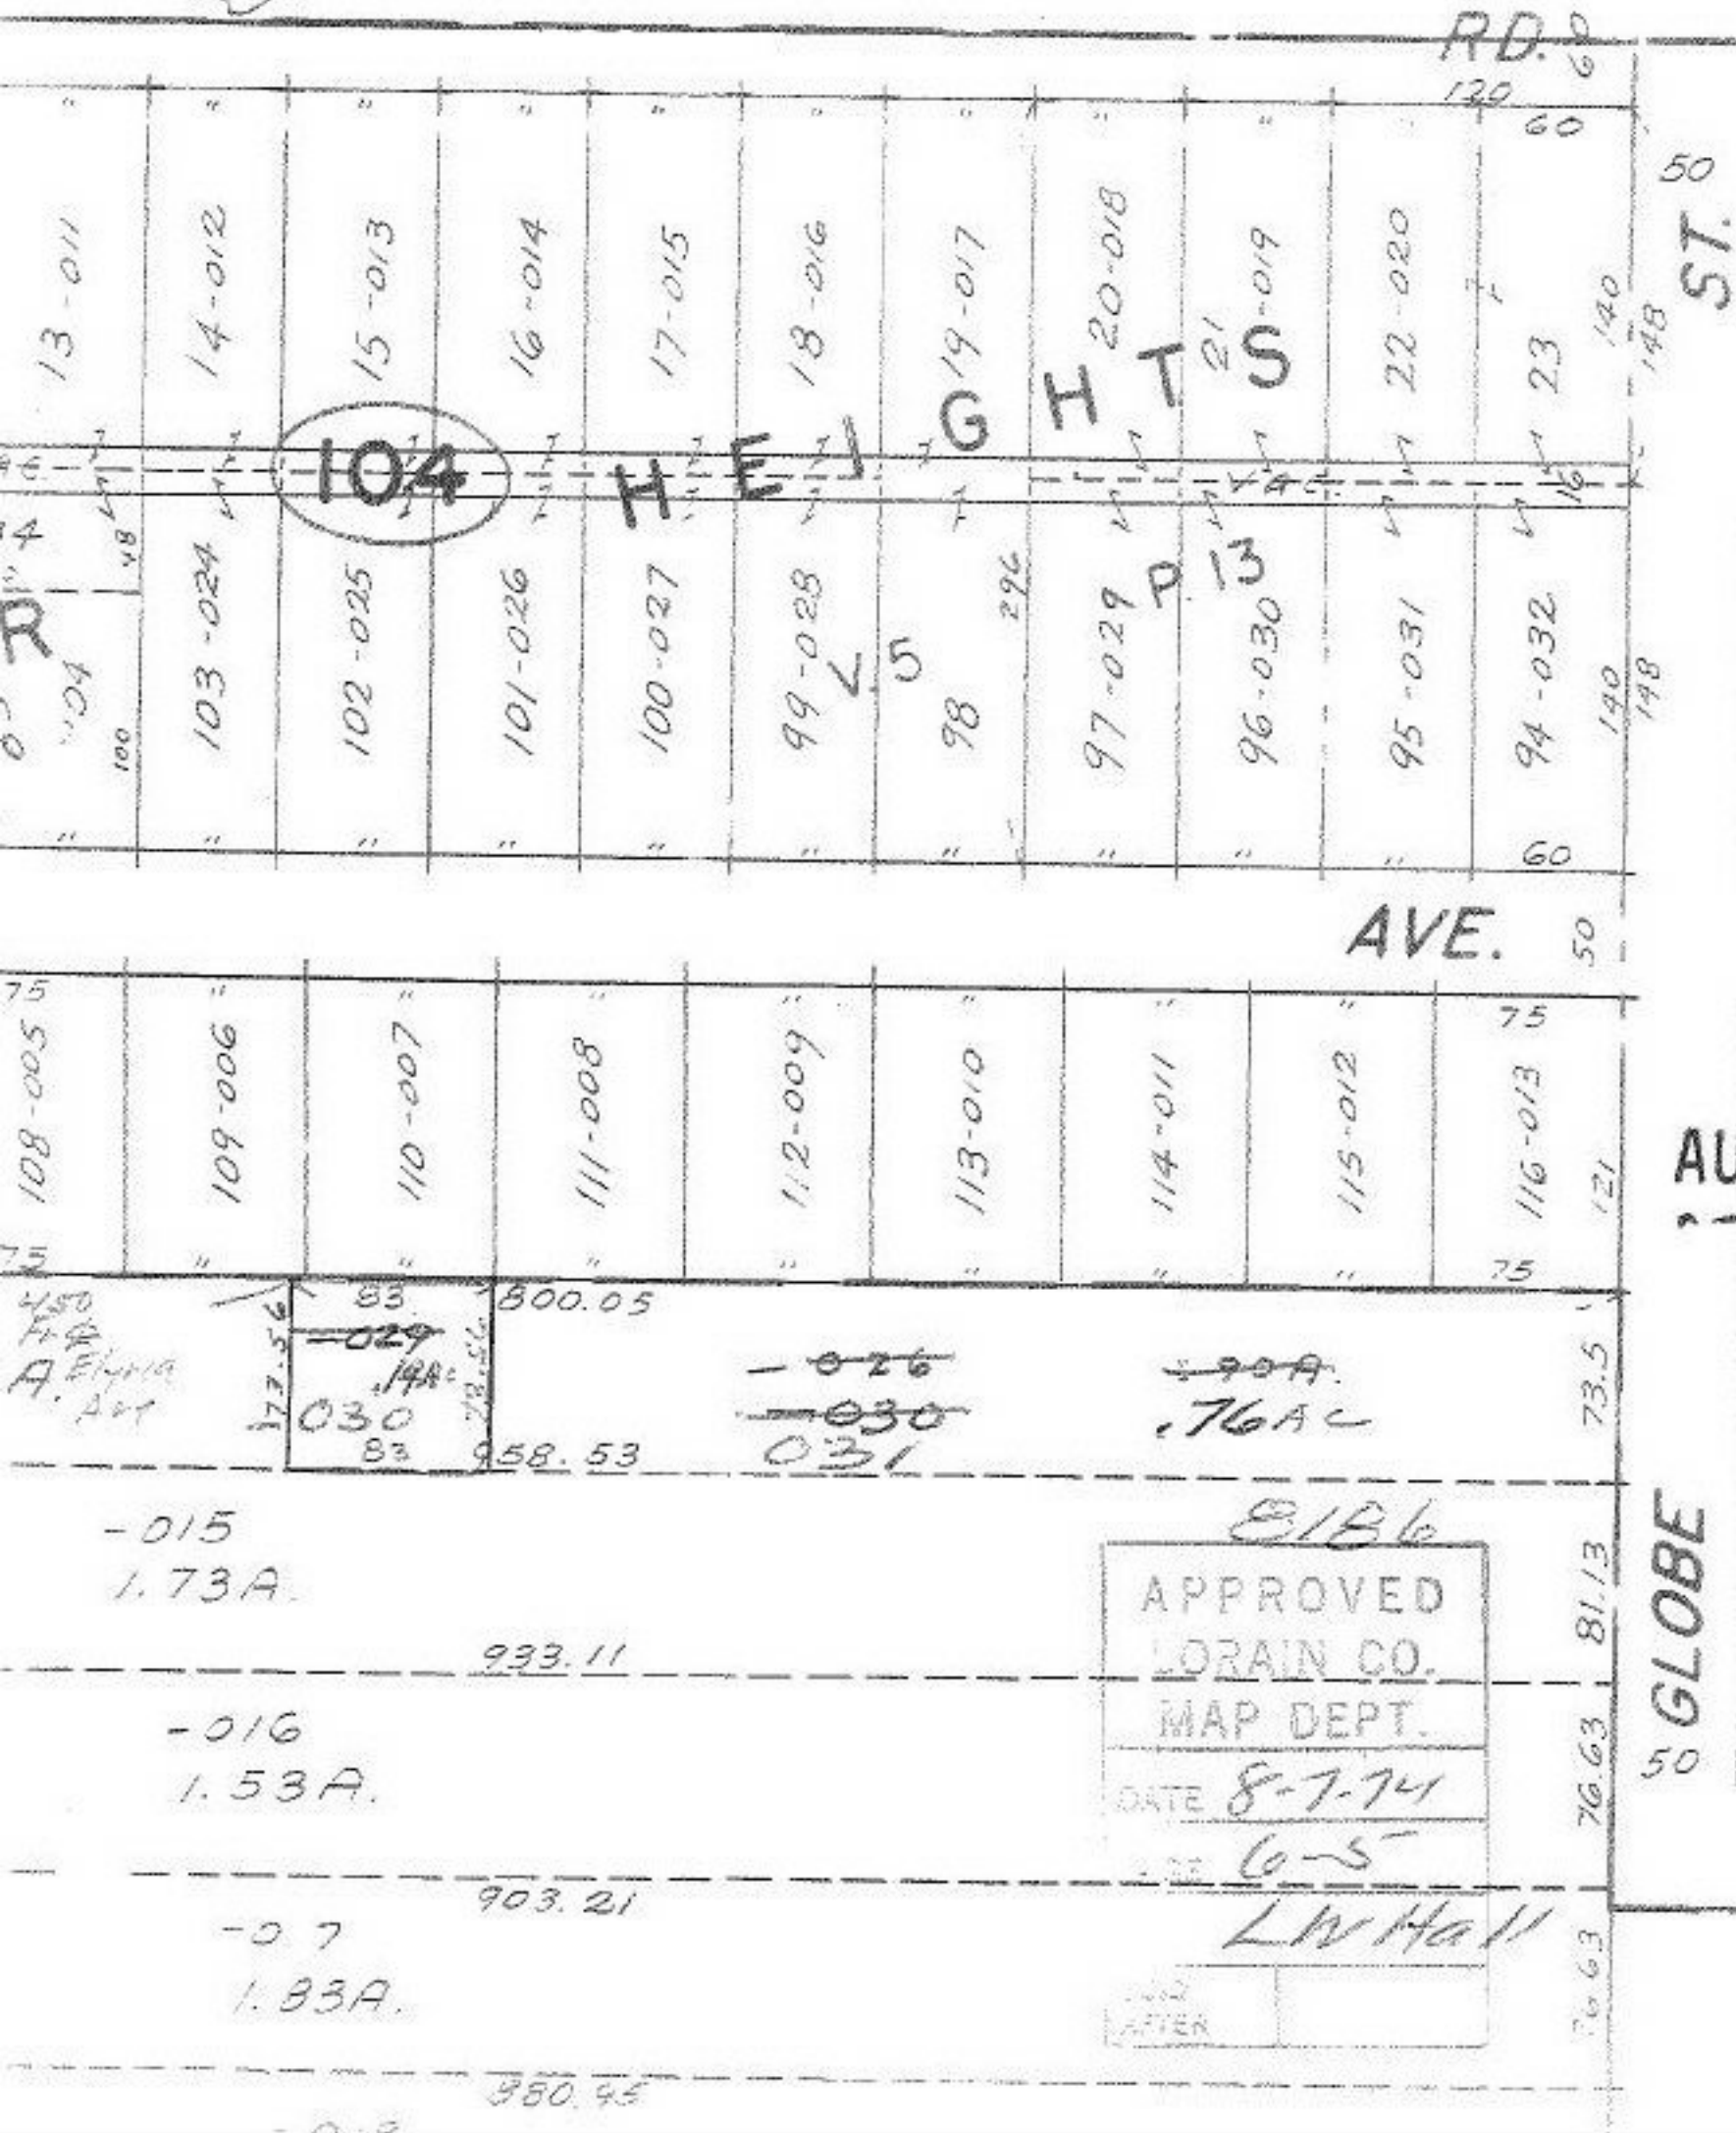

AUG 15 1974

PRJ
PRS

BIB6
 APPROVED
 LORAIN CO.
 MAP DEPT.
 DATE 8-7-74
 SHEET 6-5
 L.W. Hall

50 GLOBE