


8188

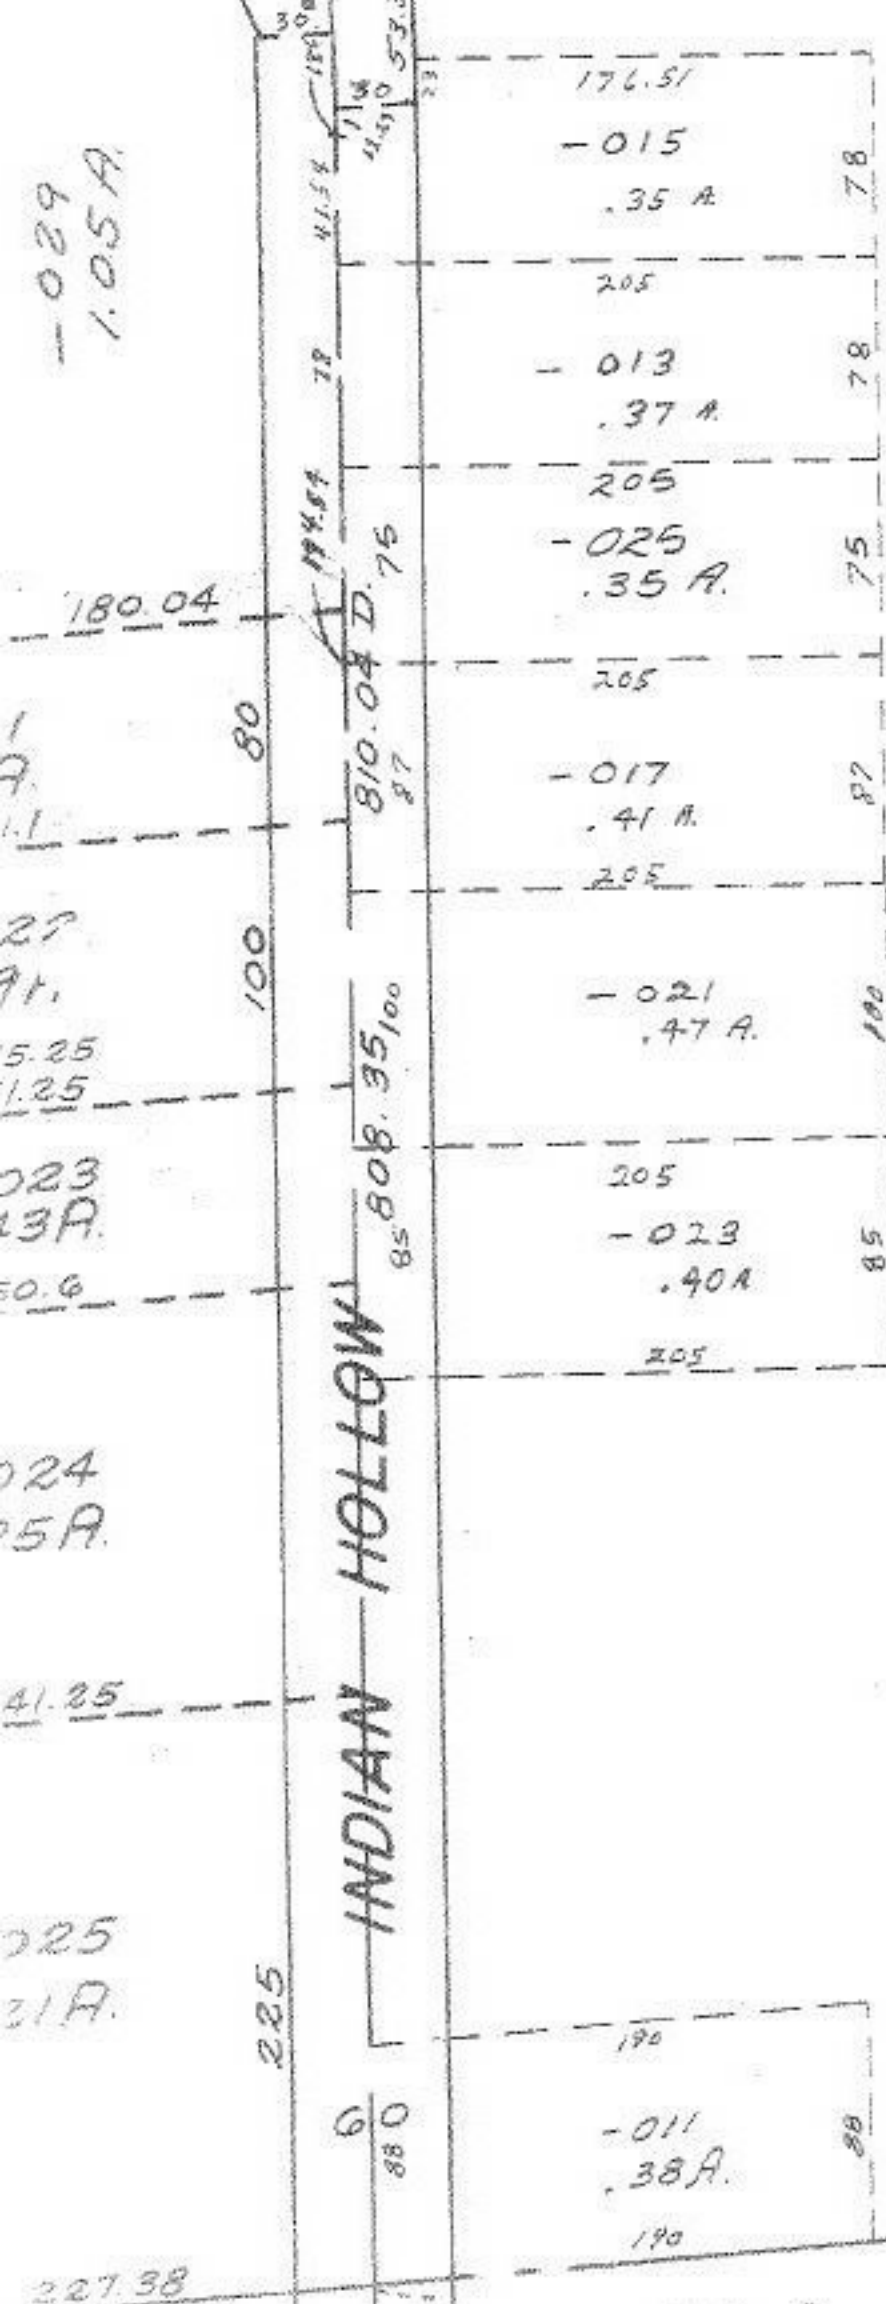

110

-028

~~026~~
~~8.72 A.~~

PLD

AUG 15 1974

30
8.42 AC.

PLD

8188
APPROVED
LORAIN CO.
MAP DEPT.
DATE 8-8-74
10-00-00714
LW Hall

10-00-014-D