


DELL

20 20

135	126 - 001	127 - 002	128 - 003	129 - 004	130 - 005	131 - 006	132 - 007	133 - 008	134 - 009	135 - 010	136 - 011	137 - 012	138 - 013	139 - 014
135	119 - 025	118 - 026	117 - 027	116 - 028	115 - 029	114 - 030	113 - 031	112 - 032	111 - 033	110 - 034	109 - 035	108 - 036	107 - 037	106 - 038
24	56													

Qud  
9-20-74

CLINTON

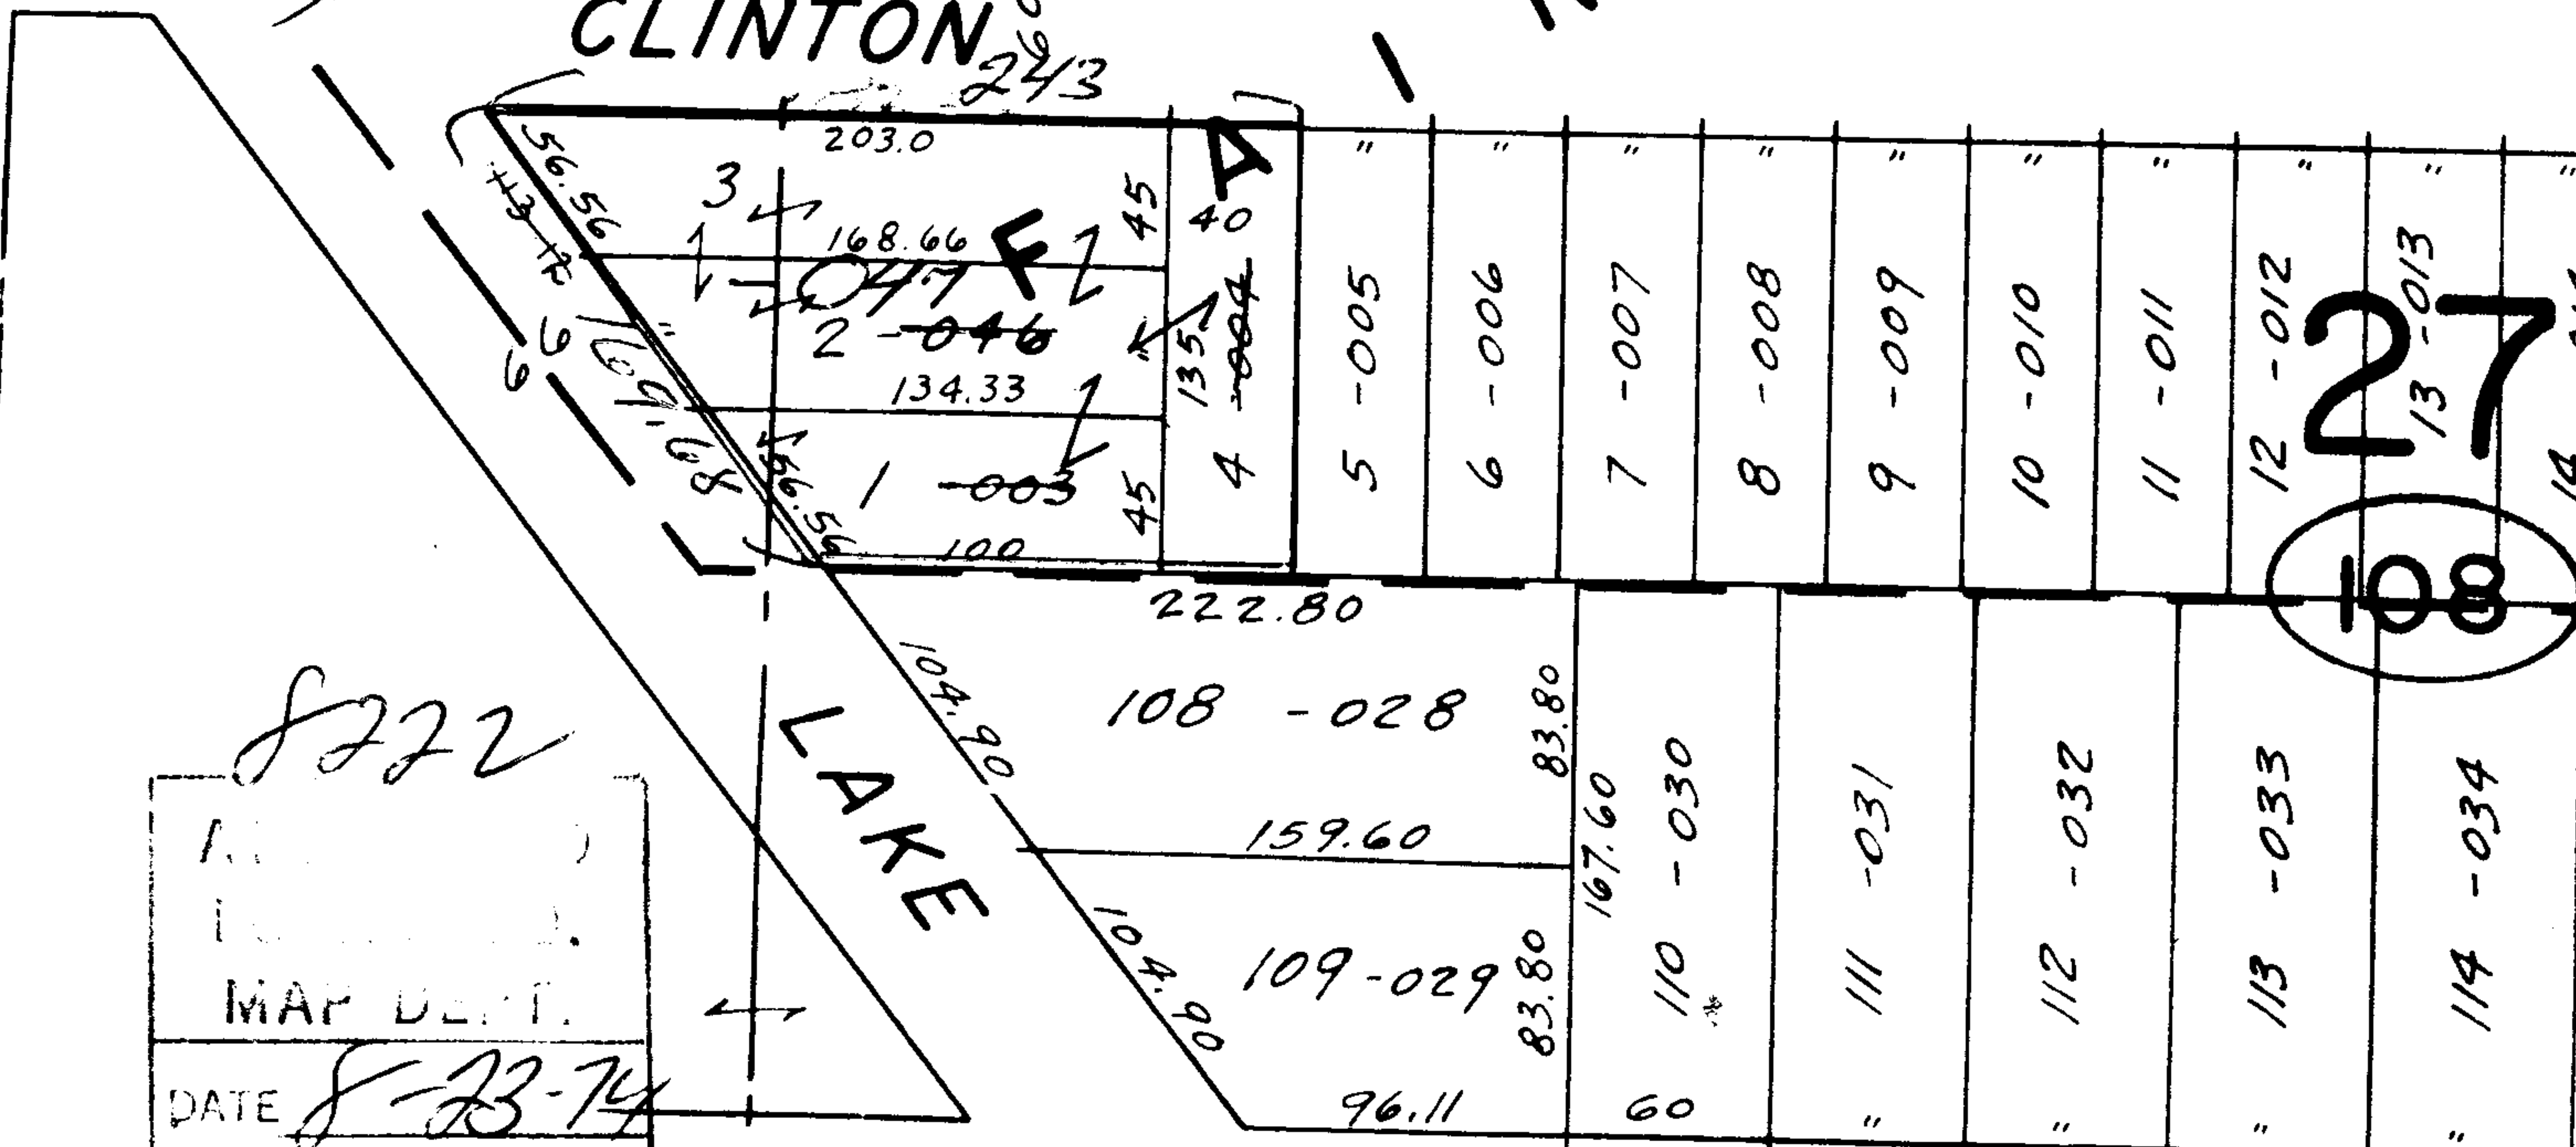

8722

MAP DEPT.

DATE 8-23-74

GE 6-80


W.H. Hall

VOID AFTER

LAKE

HIGH

PRR  
9-30-74

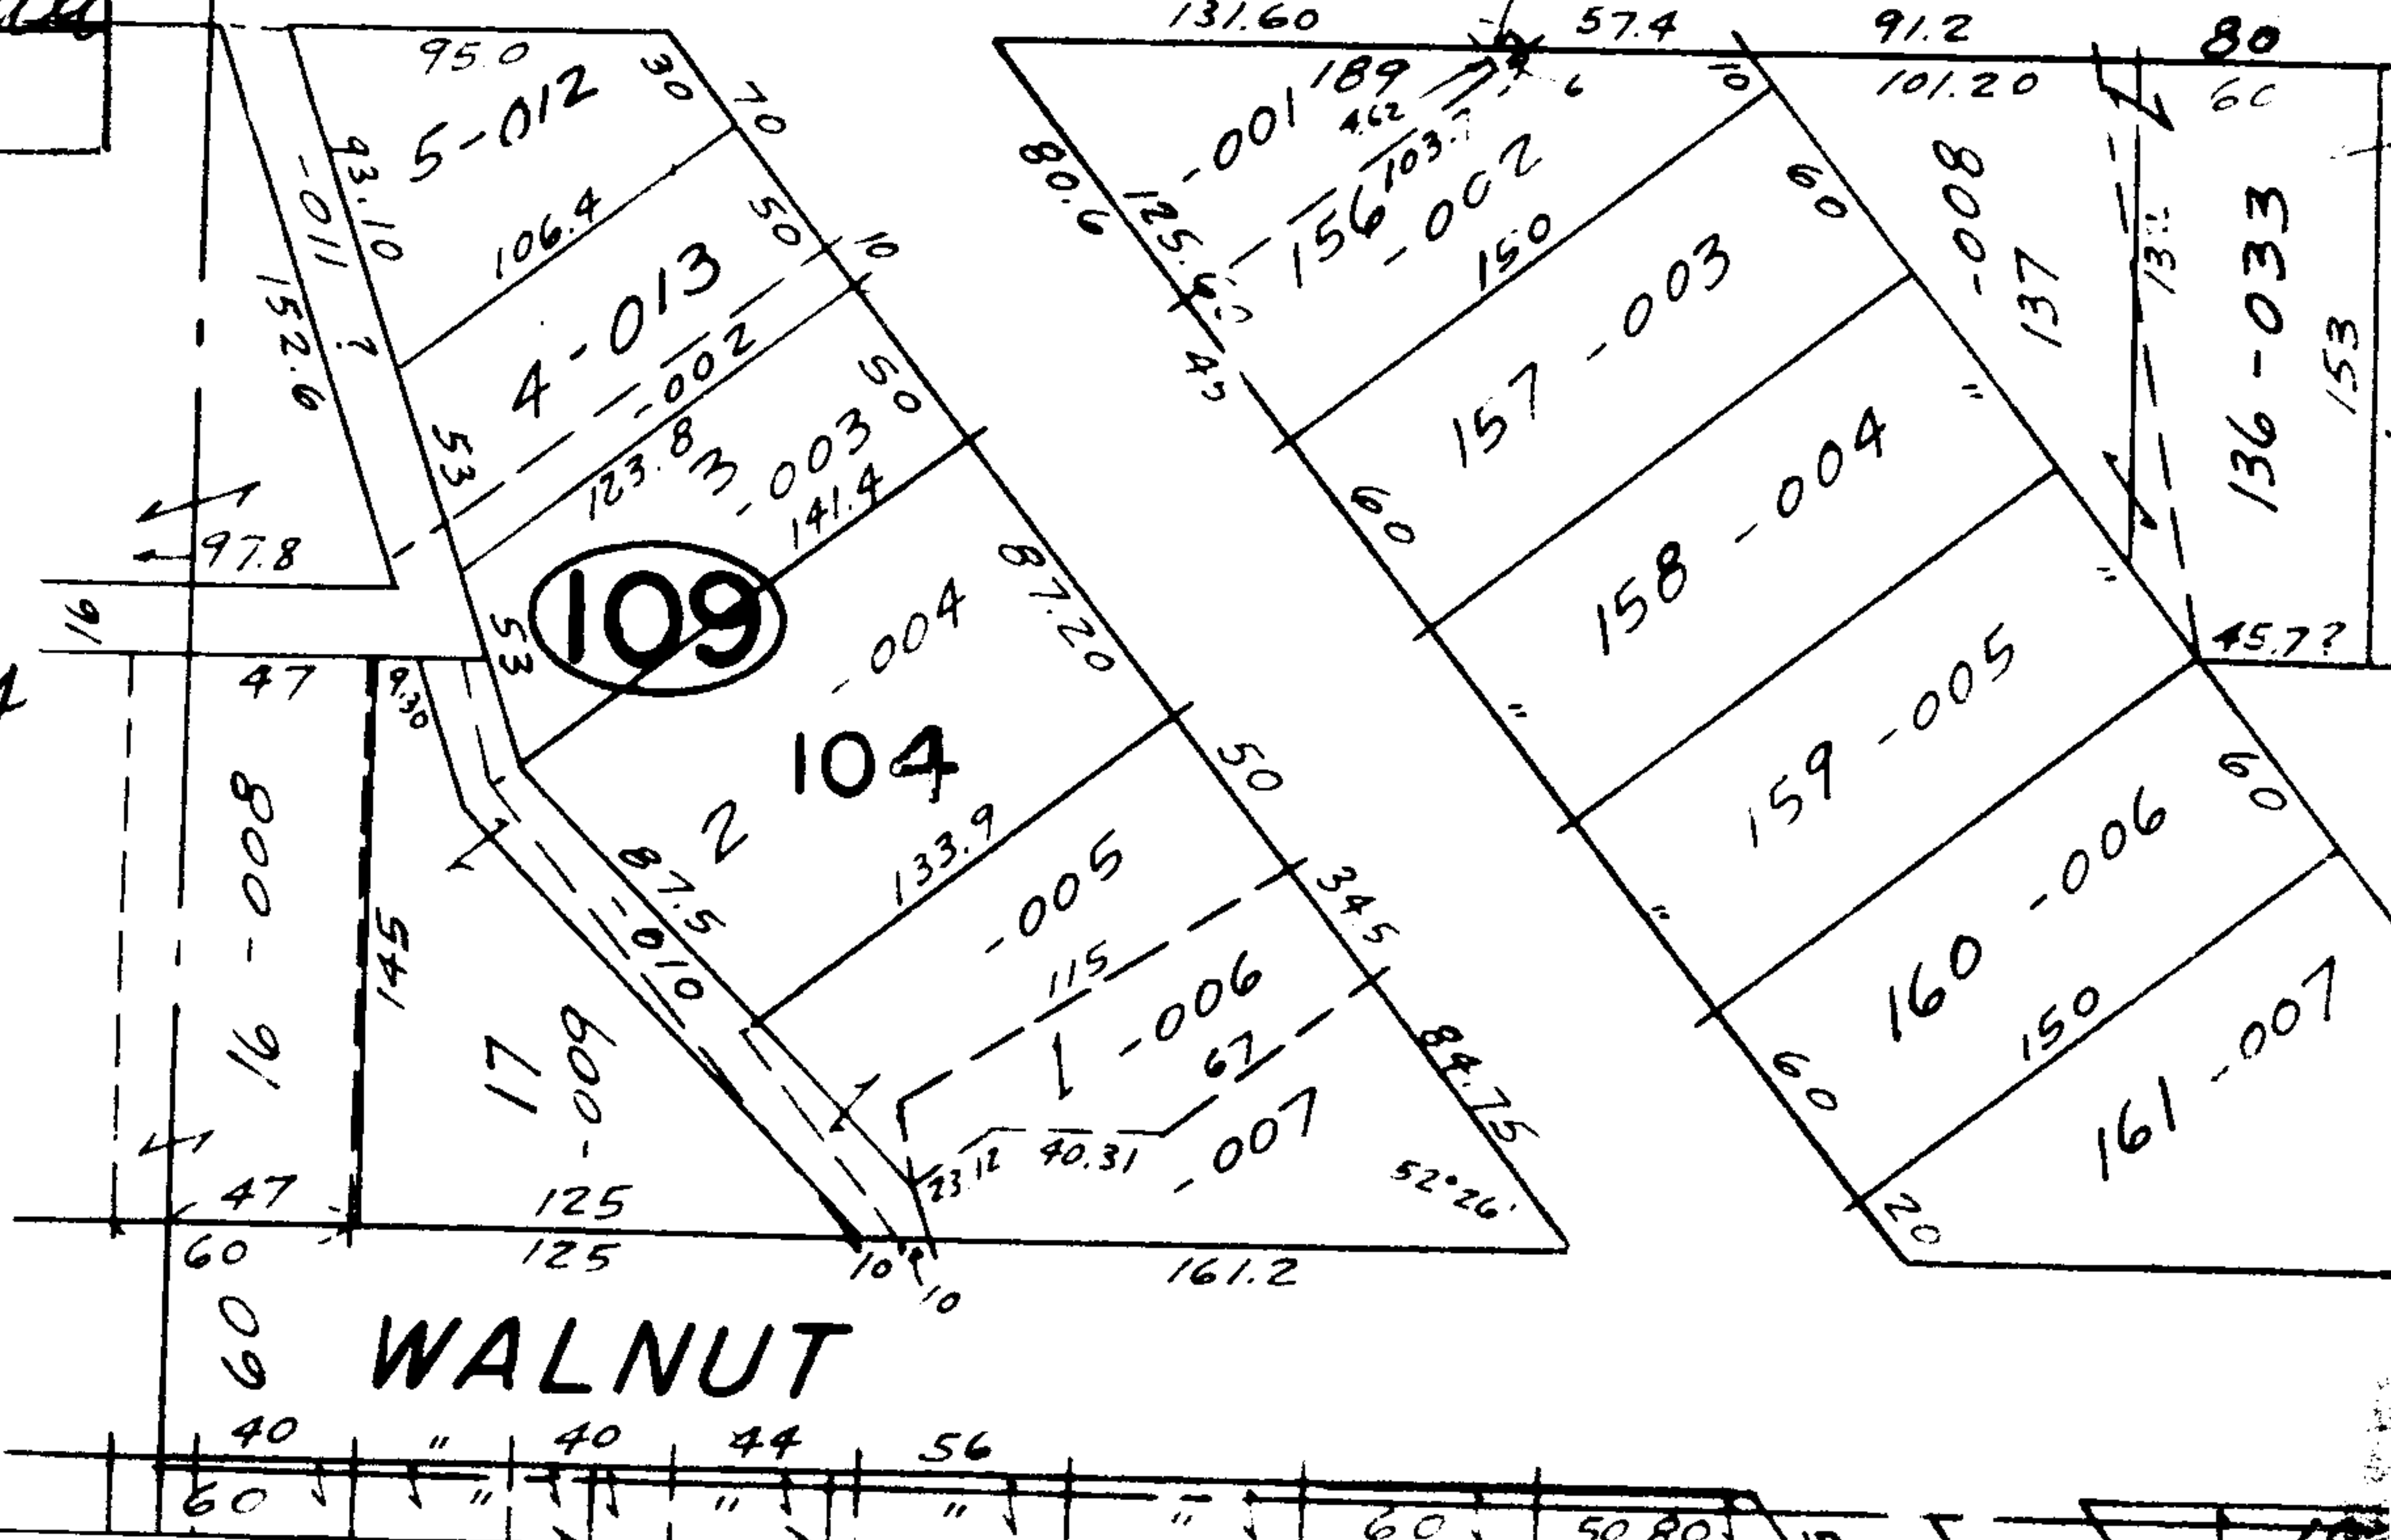

WALNUT