


SEE 1-L

8234

05-00-095-000-007  
~~48-00Ac~~  
47.20

OCT 24 1974

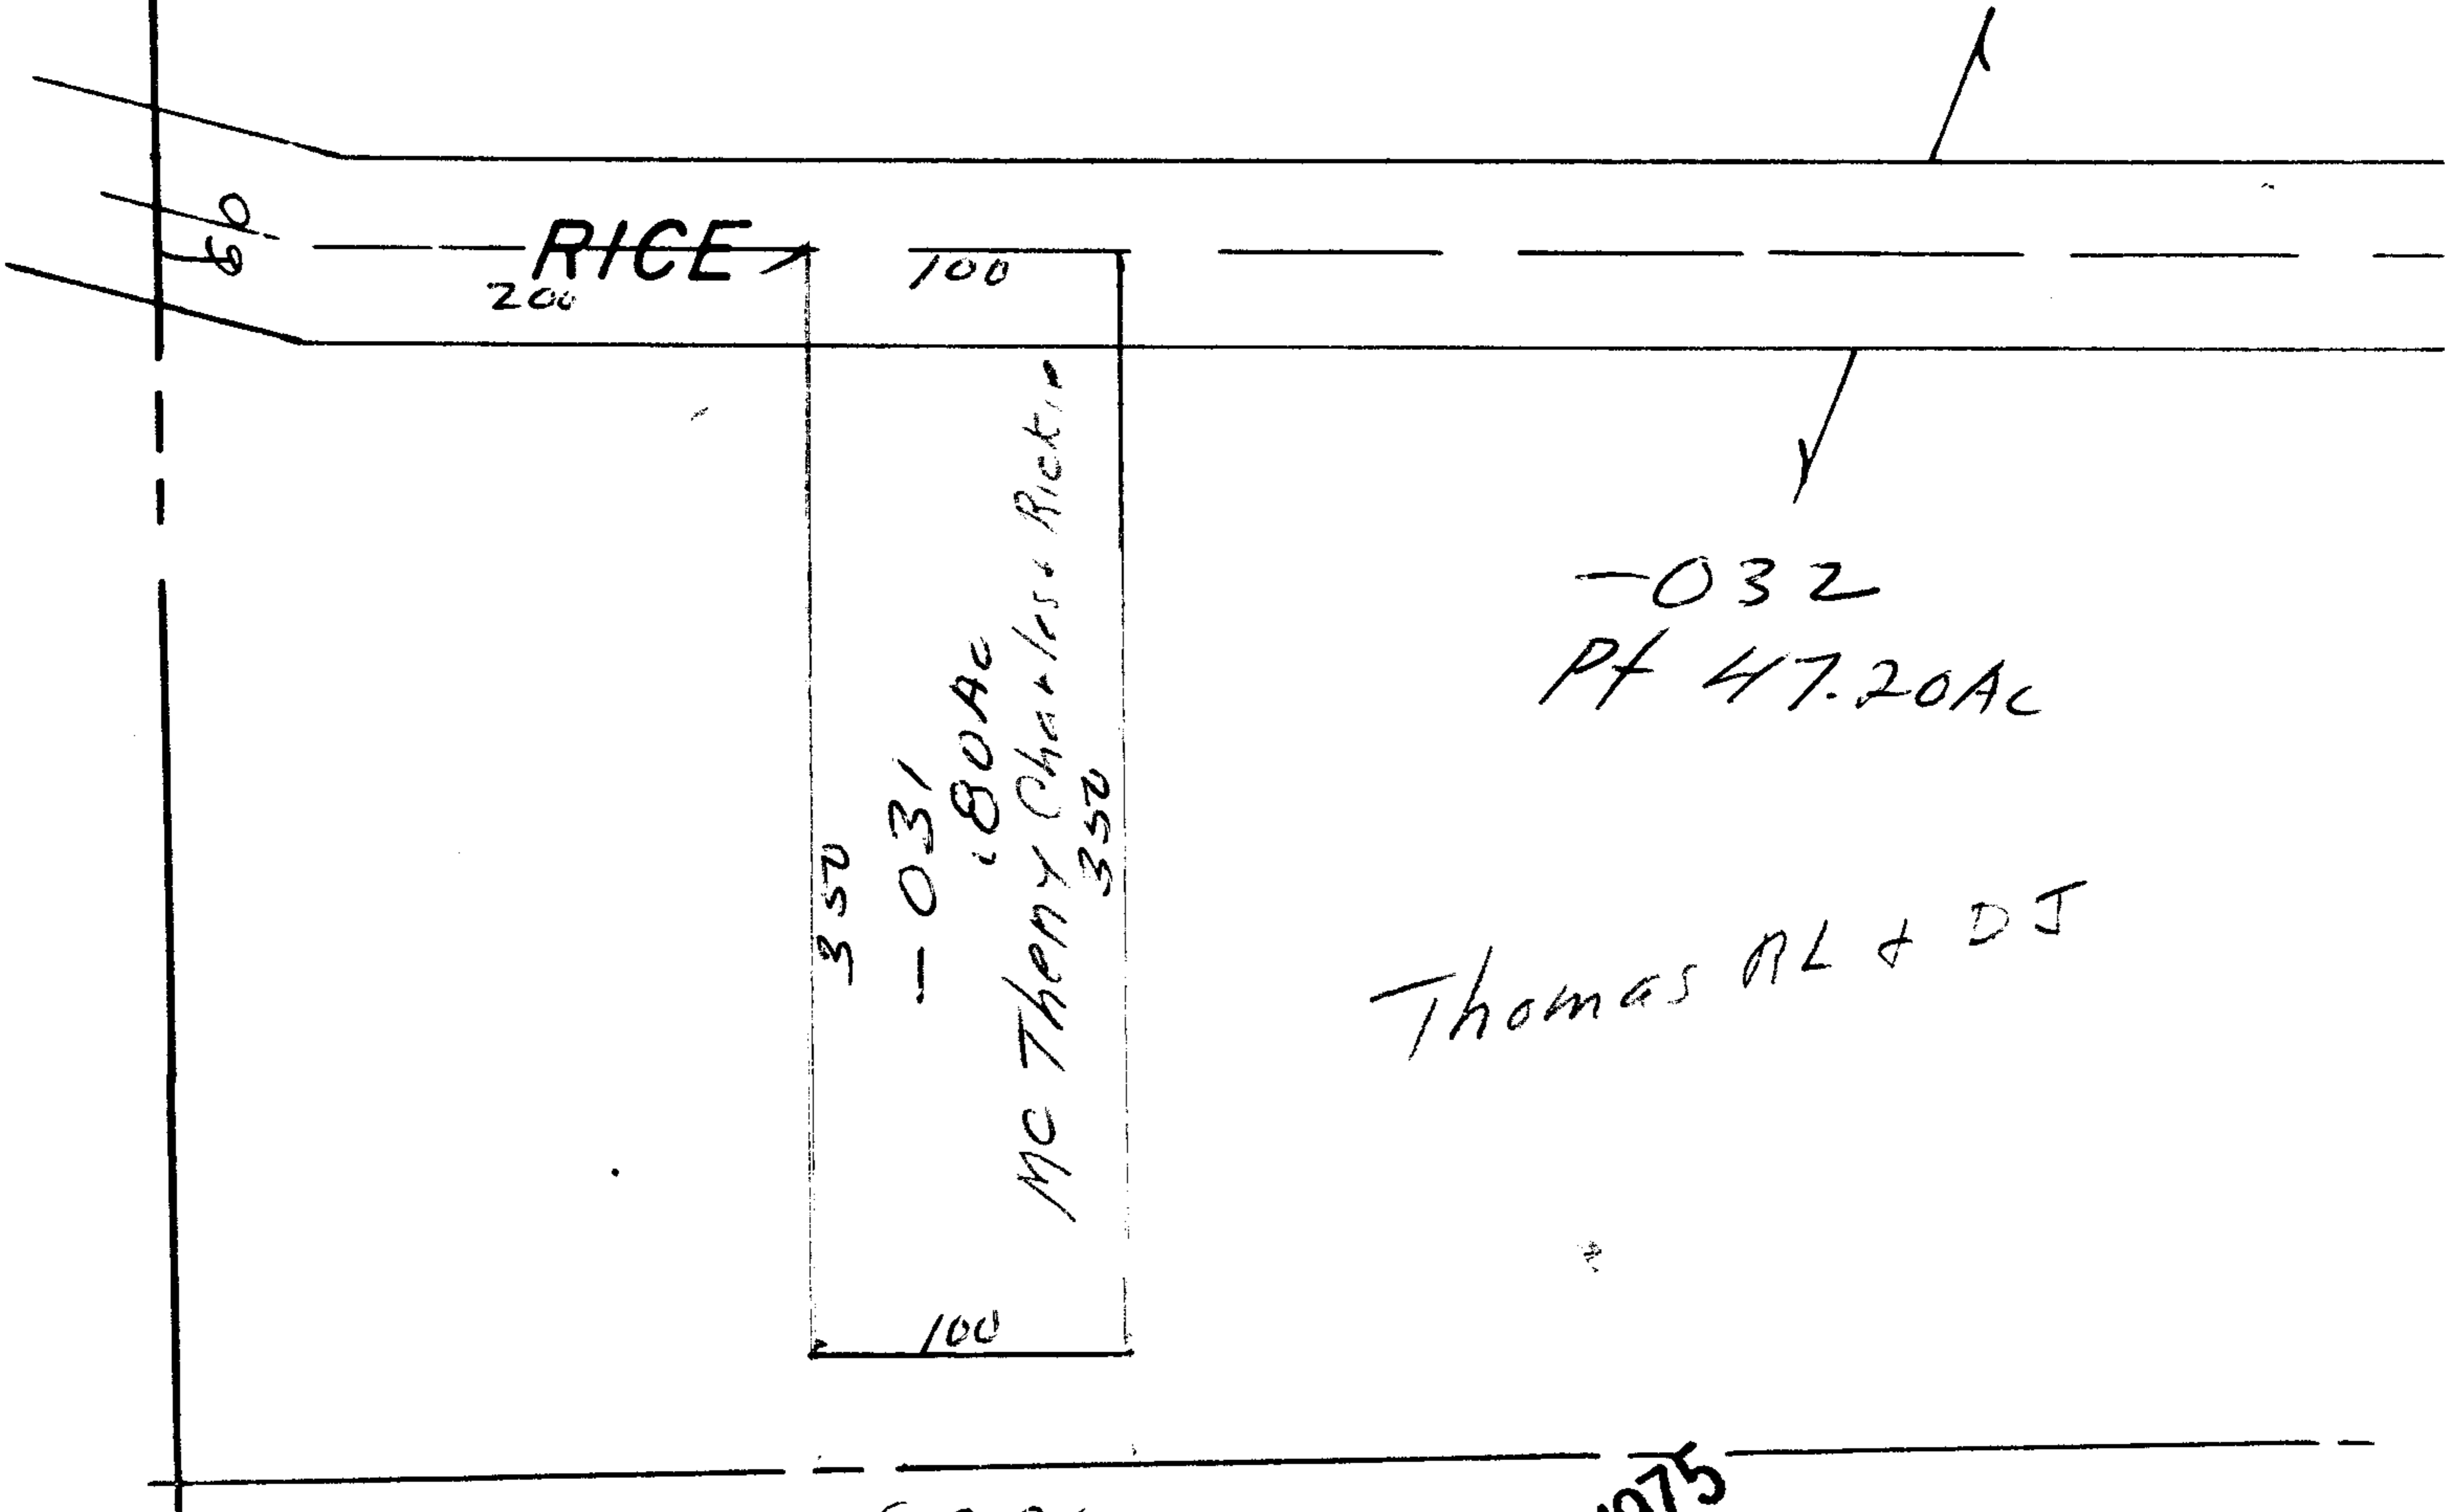

DEC 31 1975

8234

APPROVED LORAIN CO. MAP DEPT.	
DATE	8-27-74
PAGE	5-00-095A
BY	LW Hall
VOID AFTER	

Copyright 1963

5-00-095-A

AMHERST TW

SCALE: 1" = 100'