


PRR  
9-6-74

2409


WOODHILL

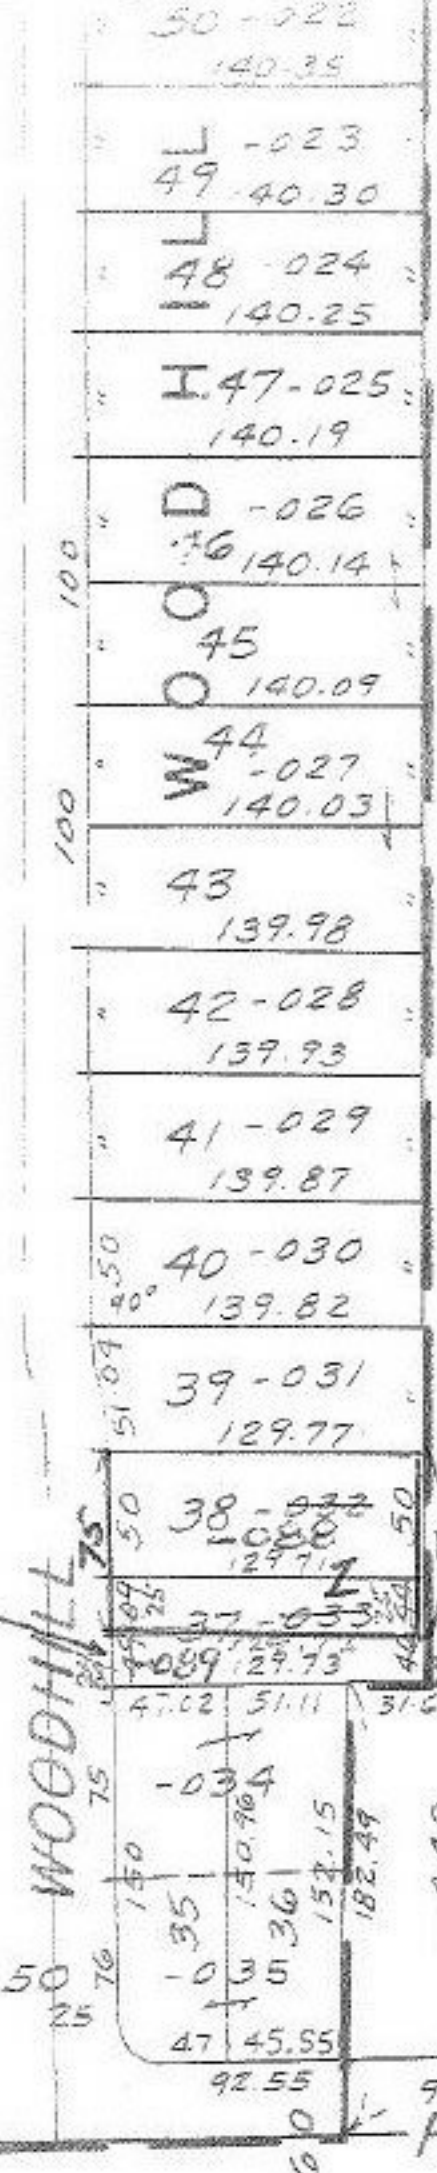

106

8251  
 APPROVED.  
 LORAIN CO.  
 MAP DEPT.  
 DATE 9-5-74  
 PAGE 05-00-0388  
 BY L W HALL  
 VOID AFTER

8251

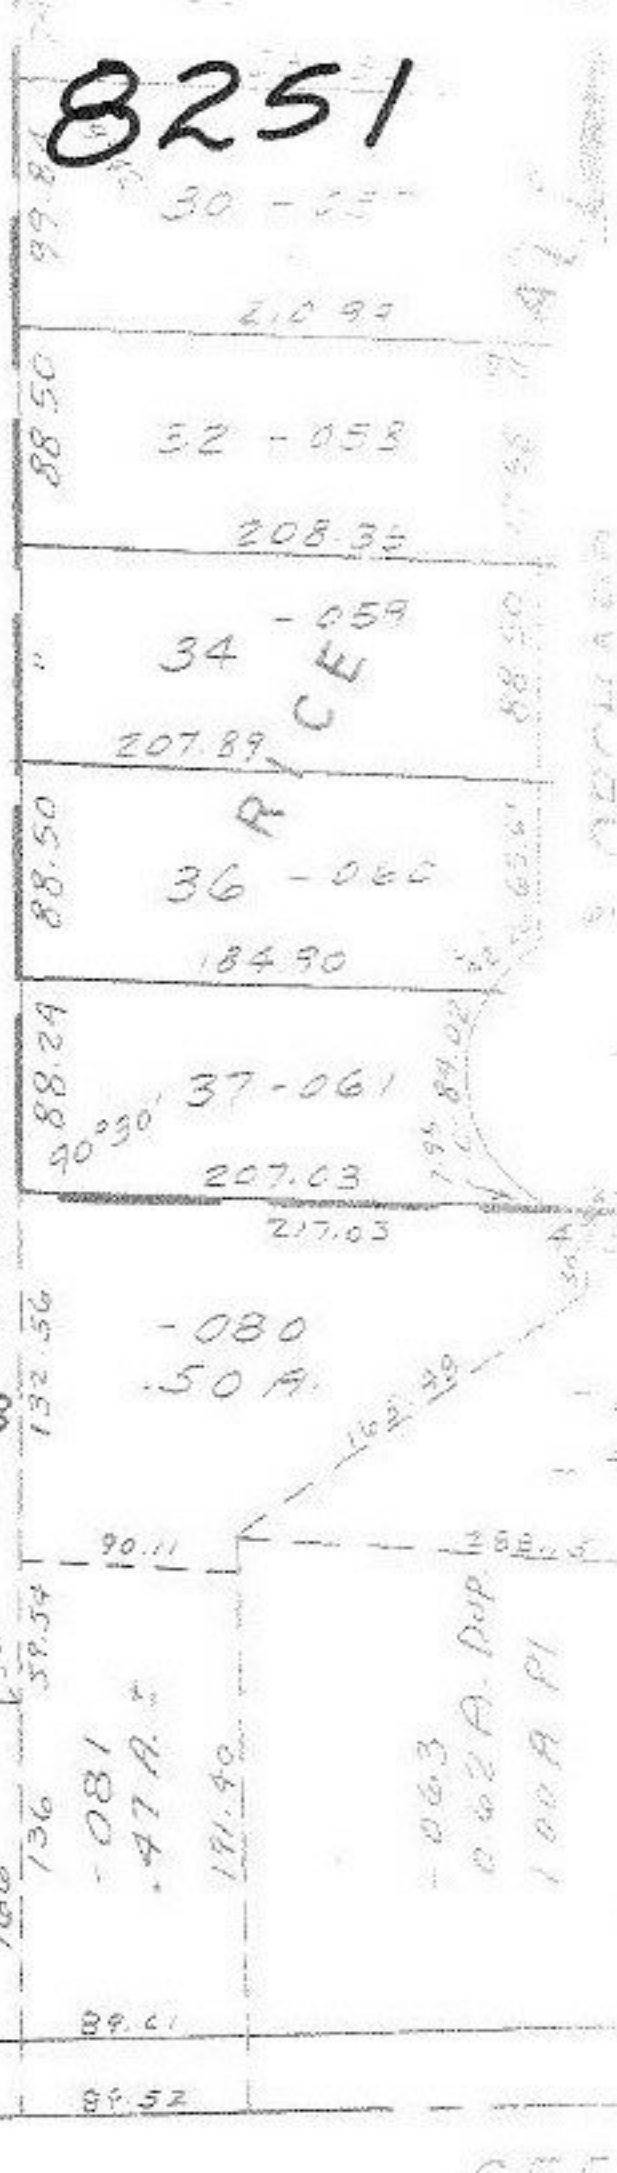

SEE

PRR  
9-30-74

# AMHERST TWP.

SCALE: 1" = 100'