

57

R

PAUL?
#8262

T
-004
59.50 A

-005
53.8

165
165

-002
A 28 A.


-001
9.71 A

62

Move

Per Deeds
V. 122 P. 608
V. 146 P. 422
V. 407 P. 244

PRT
10-7-74

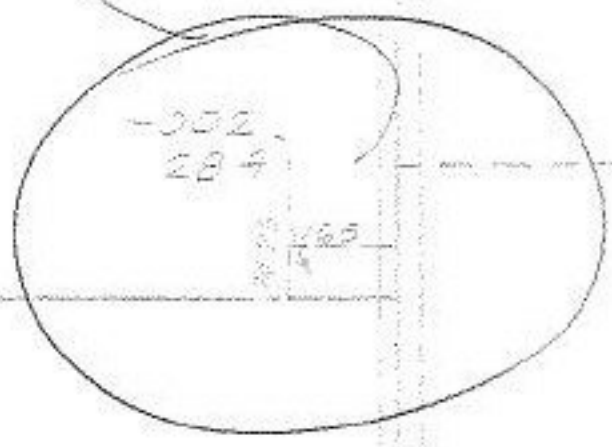

App Correction Only

Pg 19-H

-00
9.71 A

63

PRT
10-7-74
R

FOSTER
A