
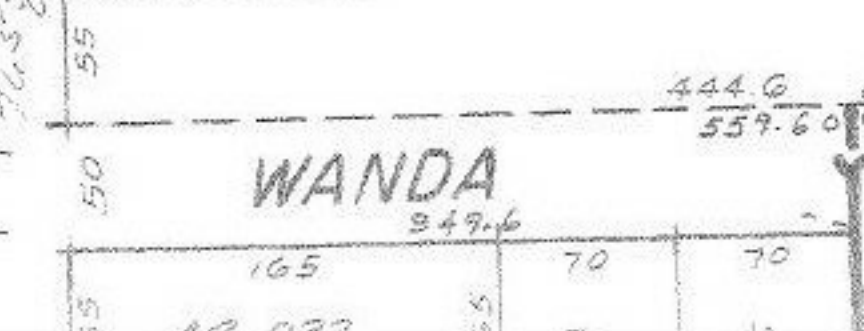
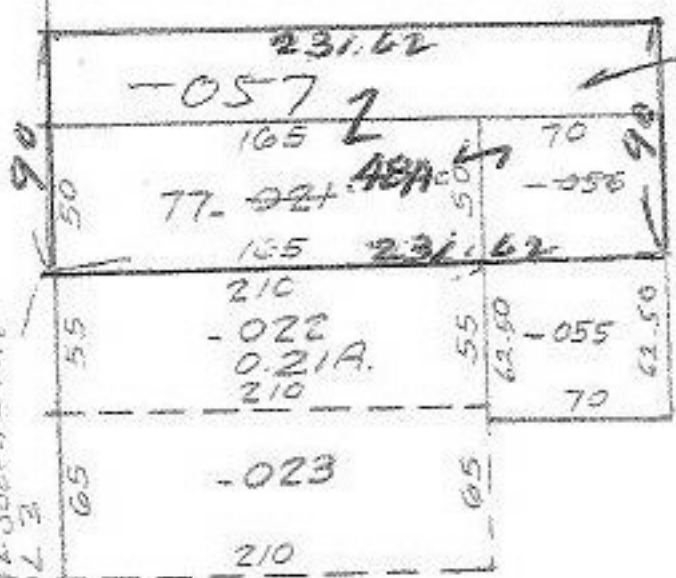
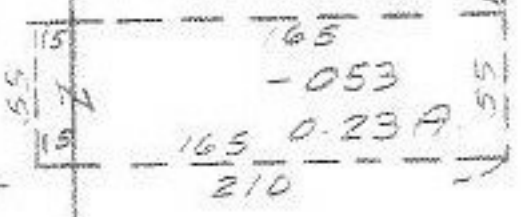
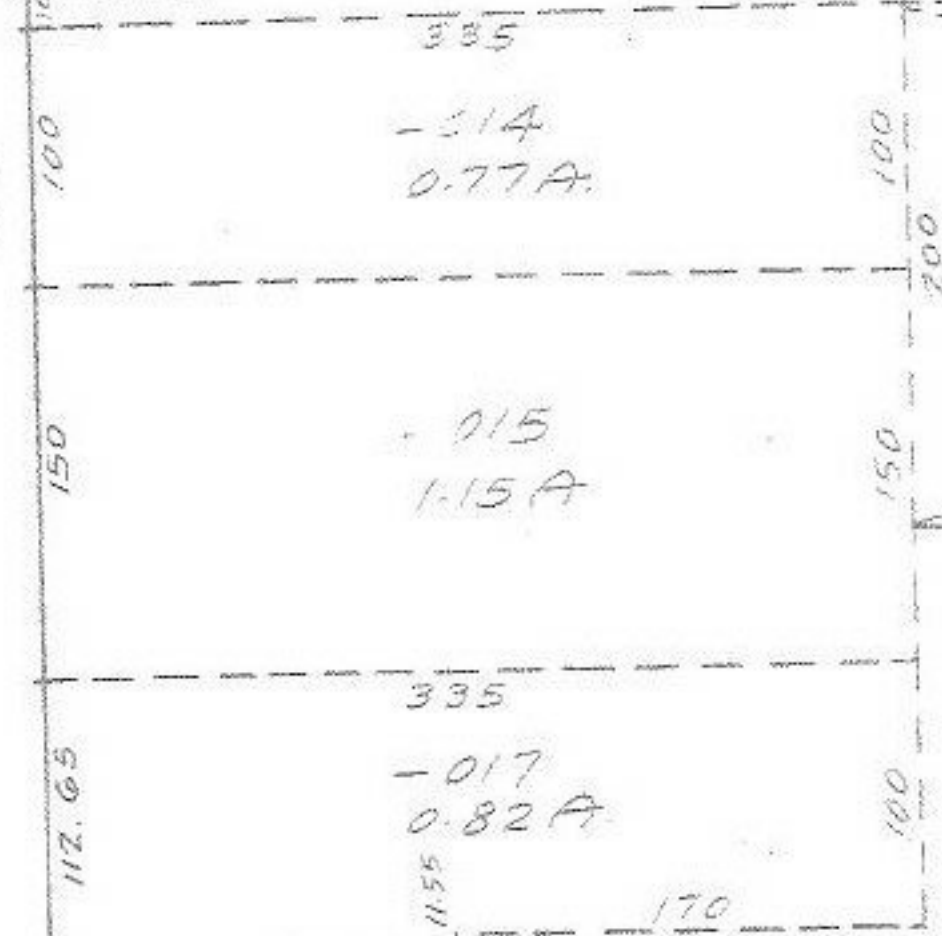


8264

SEE 10-00-003-F

301

20

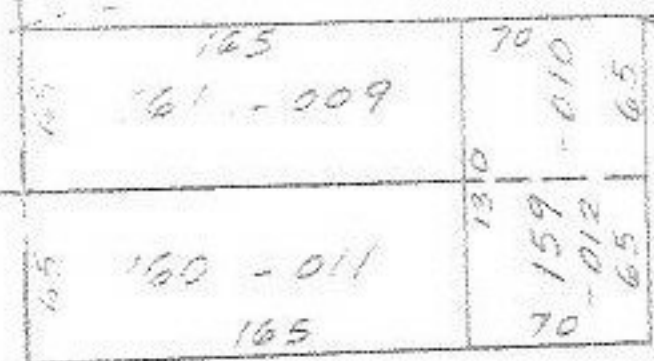

8264
APPROVED
9-11-74
10-00-003G
LW Hall

8.8 8/25/86
-020
12.35A
12.14A
-058

131

Est TO = 2.1 AC

ALTA

PKB 9-20-74

PKB 10-2-74

-025
1.47A



131.35

LAGRANGE
76.5-14-Subdiv. Line
021.3