

82-86

8286

APPROVED
LORAIN CO.
MAP DEPT.

DATE 9-24-71

PAGE 6-137

LN Hall

West Branch


MUSSEY

14th

16th

AVE.

WEST

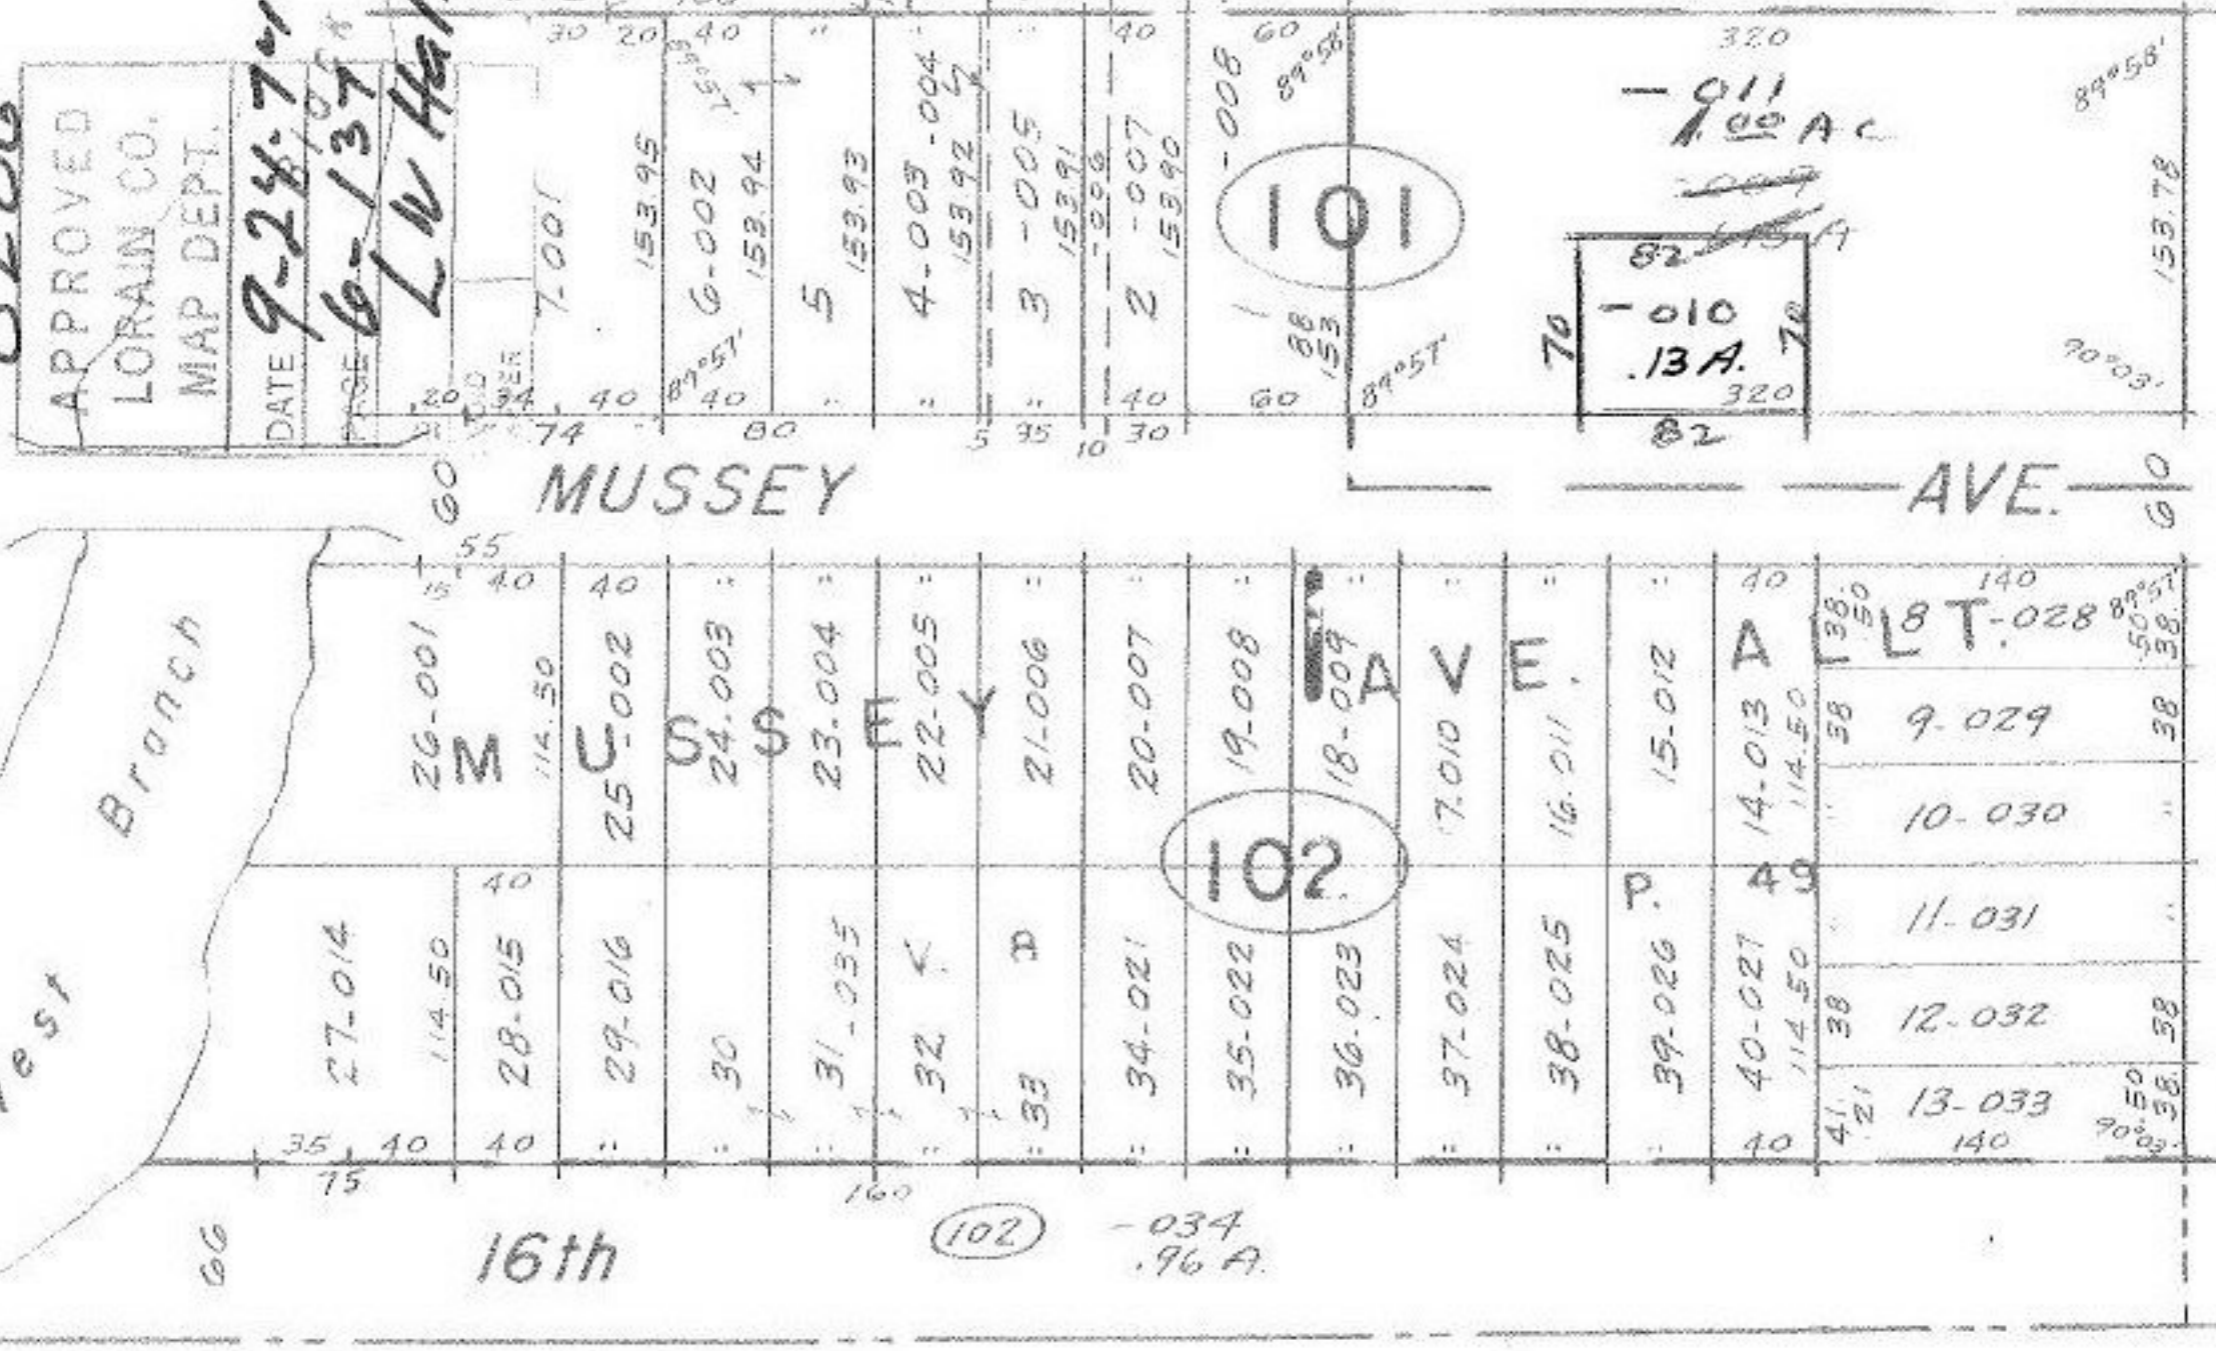

SEE 10-00-003-C

82
70 Calculation
5740.544 = 13 AC
413560

PP

PP 9-30-74

PP 9-30-74

Copyright 1963

ELYRIA

SCALE 1" = 100'

6-137