

- 003
49.50 A.

8300

7.00
7.50

- 005
40.00 A.

- 001
50.00 A.


#8300

APPROVED
LORAIN CO.
MAP DEPT.
DATE 9-26-74
PAGE 15-6
BY Paul
VOID AFTER

- 002
50.00 A.

95

LATTASBURG - ELYRIA

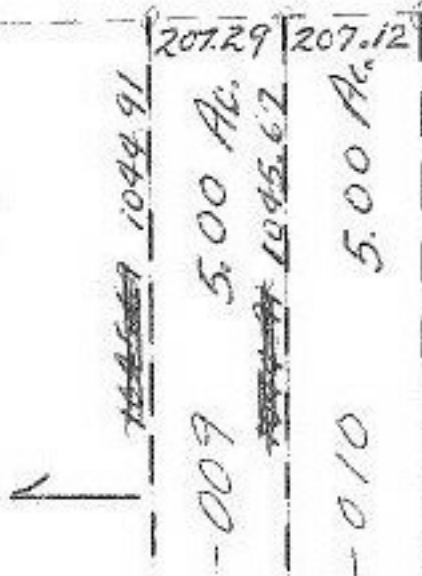

PPS
10.7.74

- 011

37.90 Ac.

667.45 WEBSTER

209.54 209.38

LAGRANGE TWP.

Paul
10-8-74