


8305

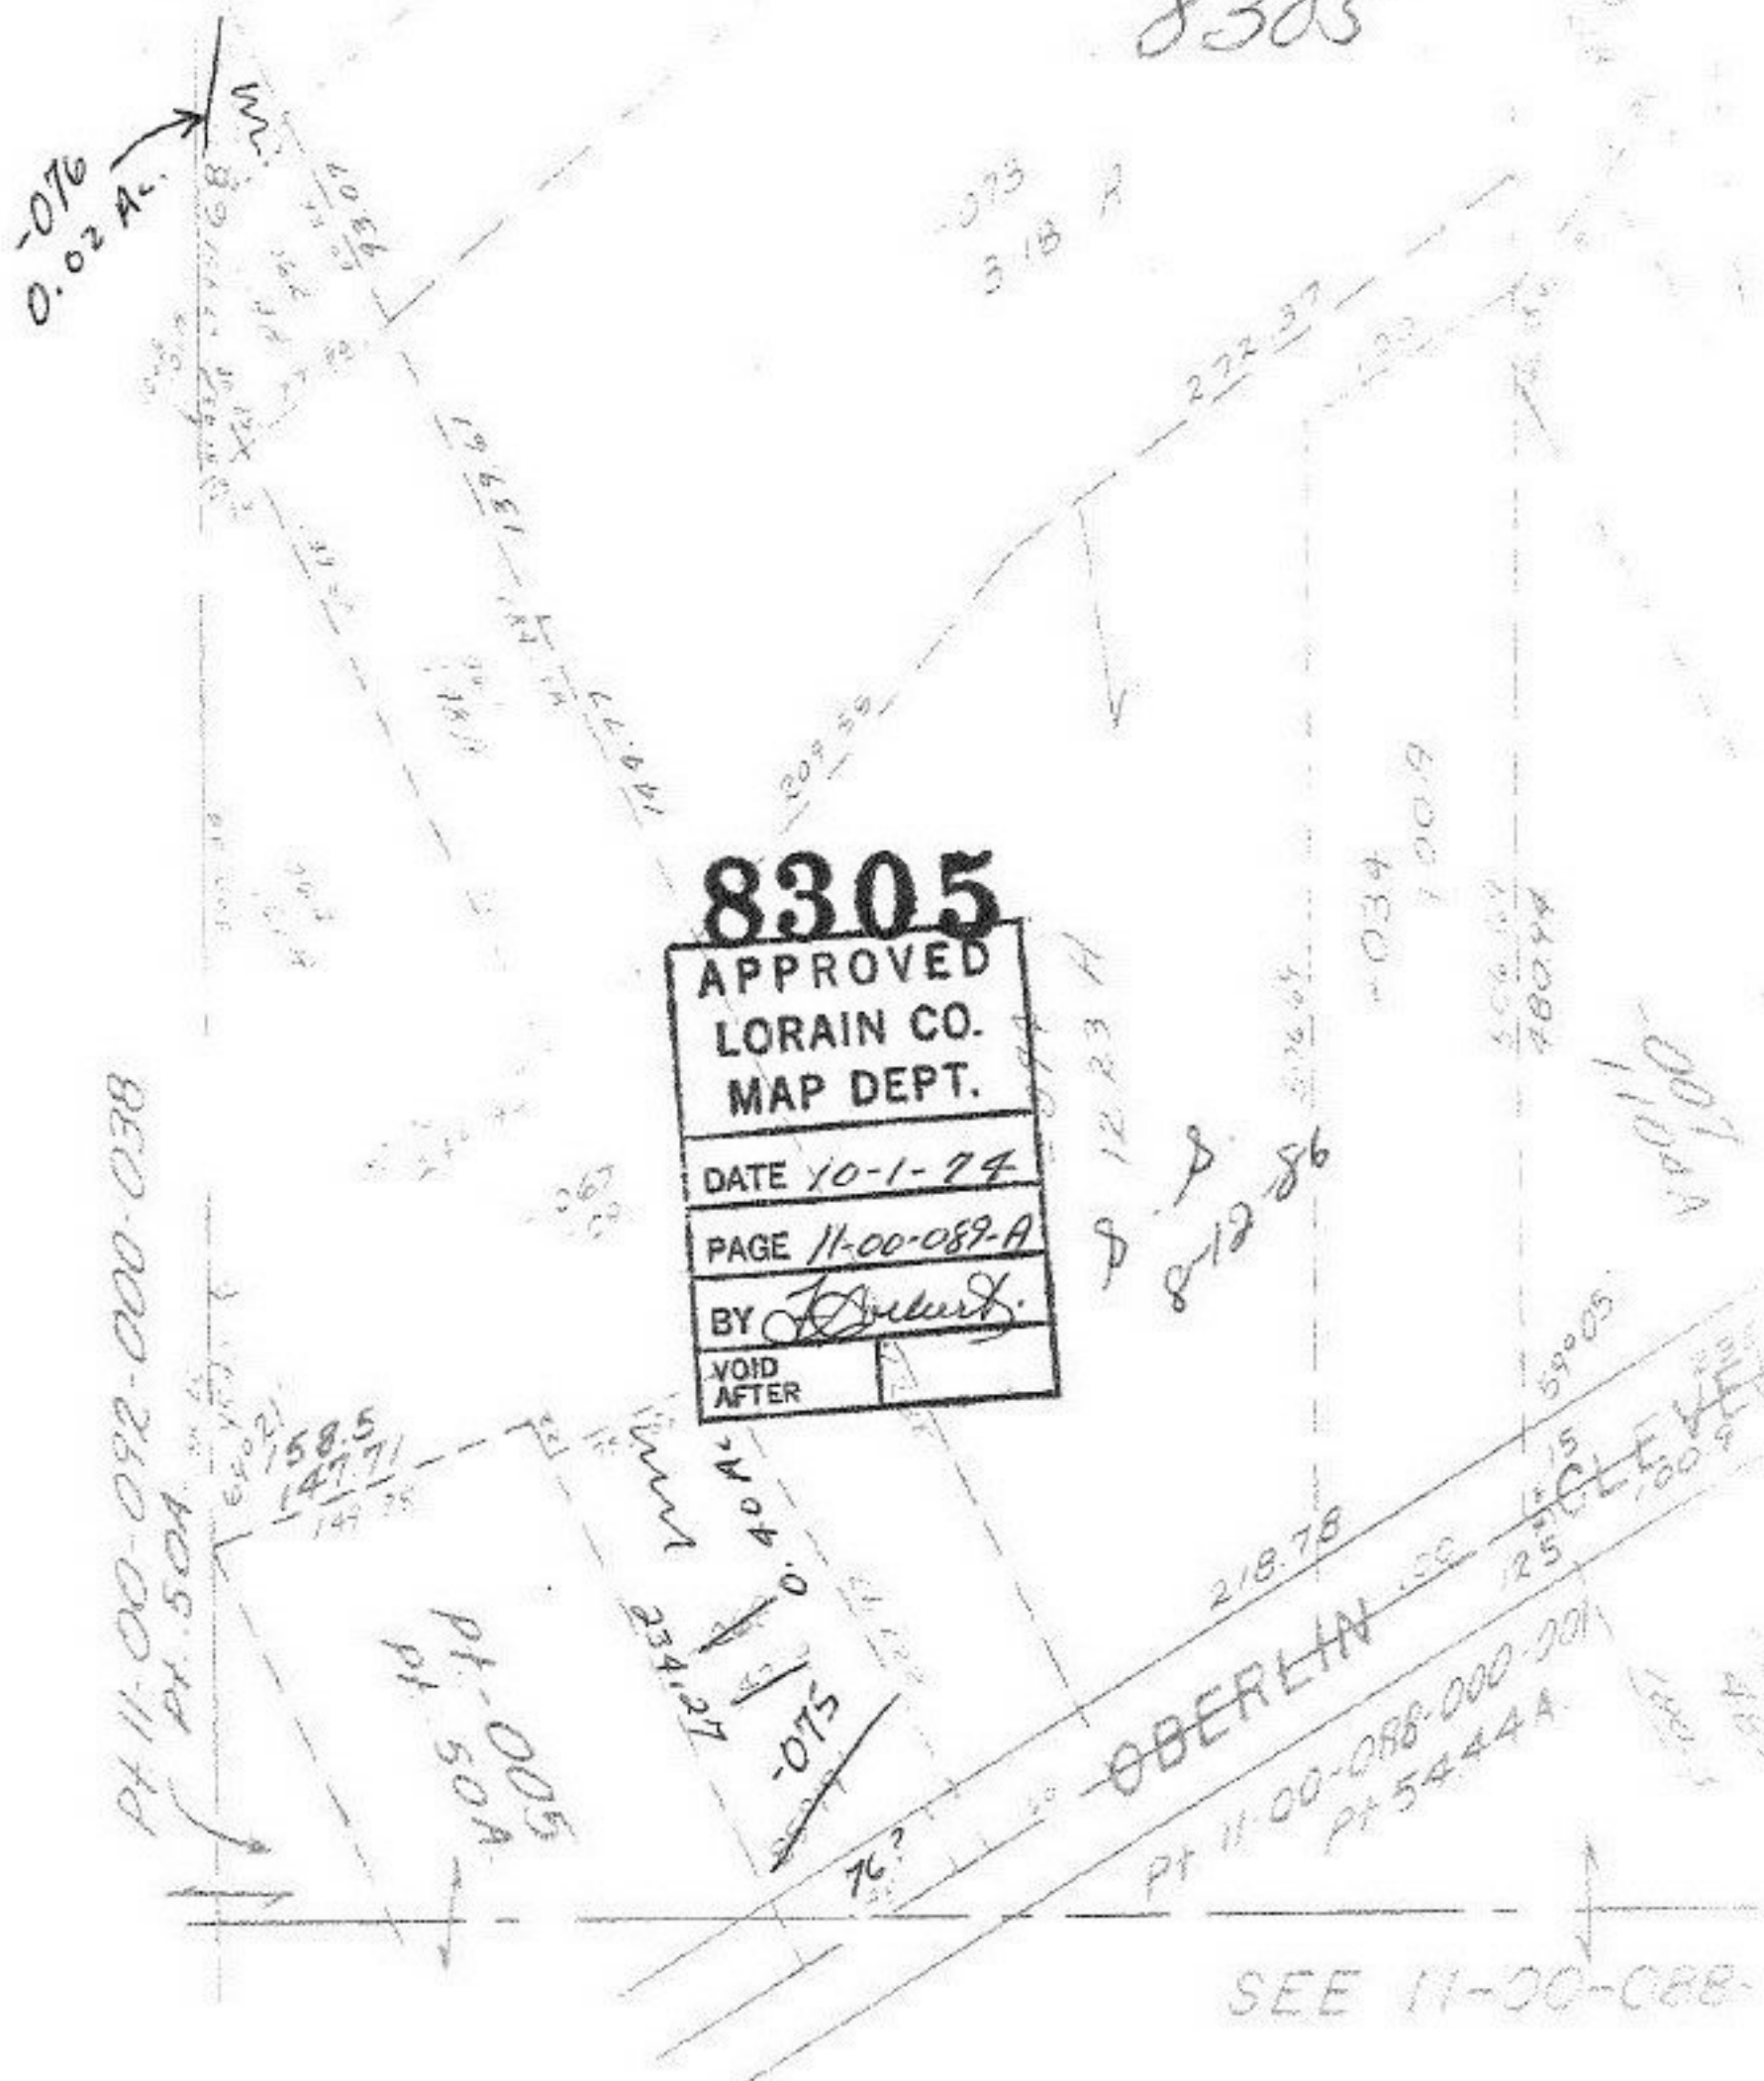

EATON TWP.

SCALE

-A