


OCT 16 1974

8318


SEE

CENTER RIDGE

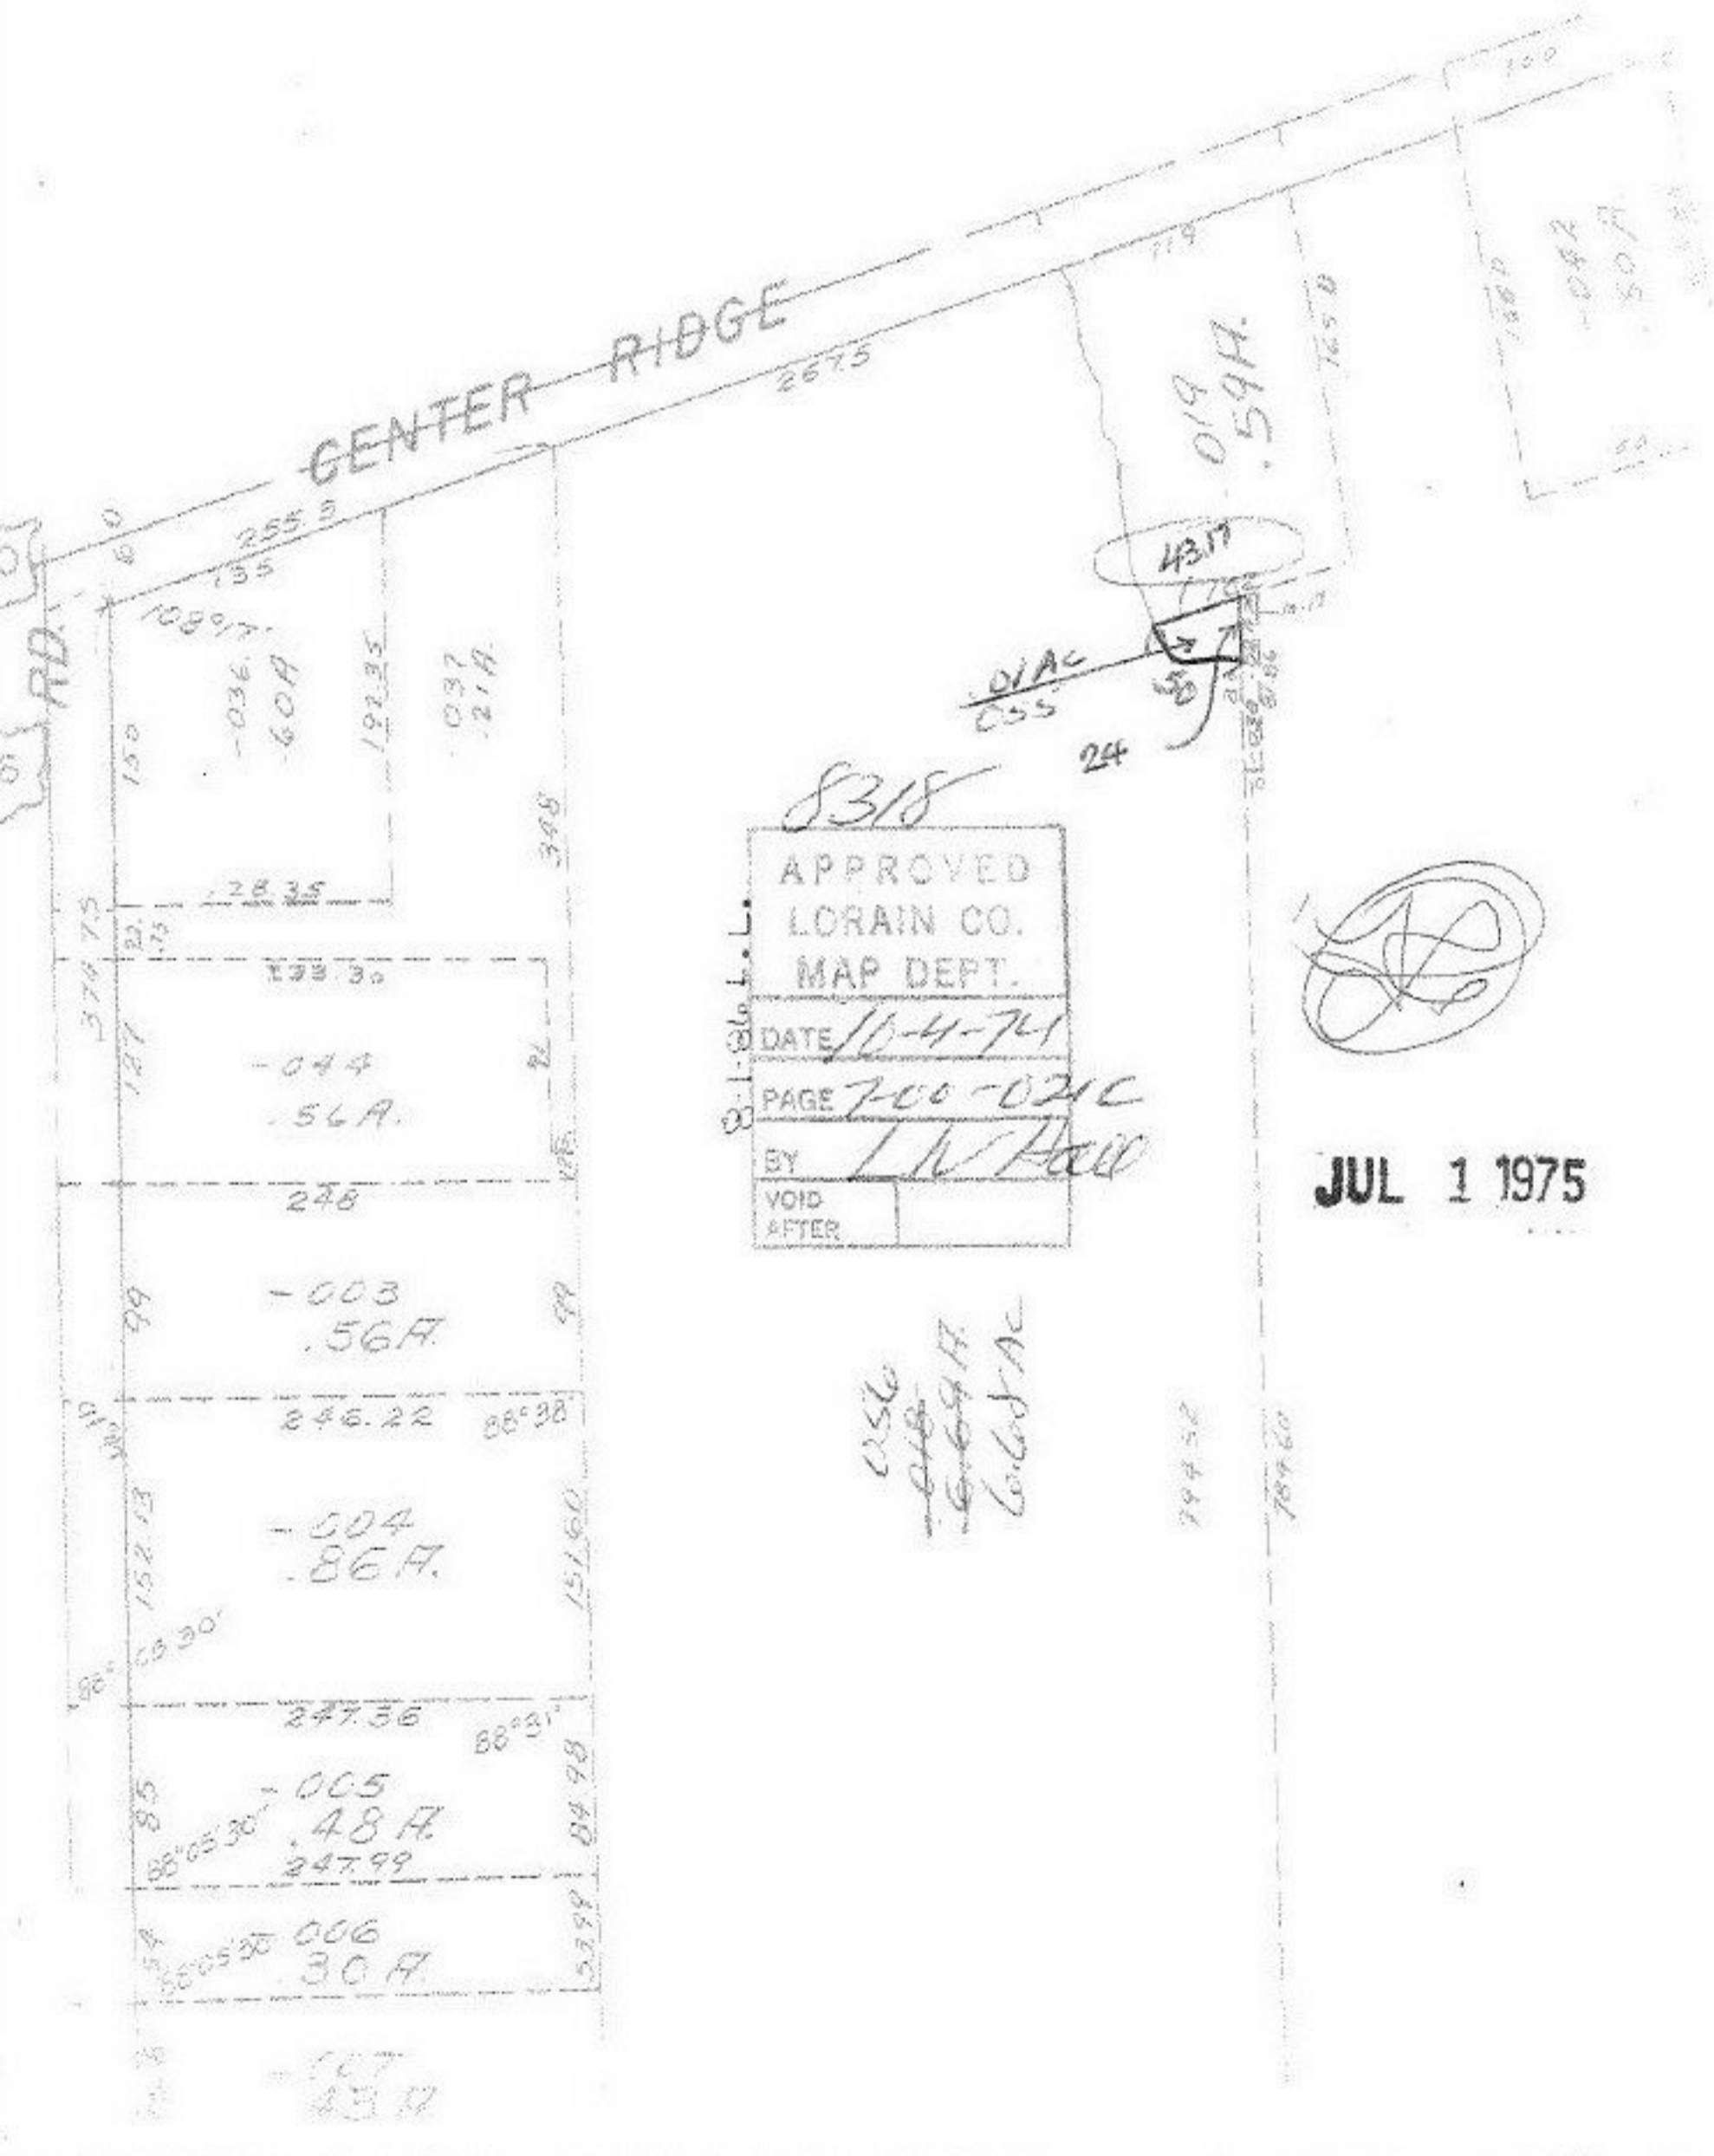

8318

APPROVED
LORAIN CO.
MAP DEPT.
DATE 10-4-74
PAGE 700-021C
BY LNH
VOID AFTER

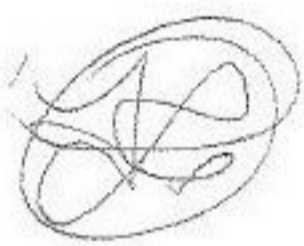

JUL 1 1975

0256
 018
 6.69A
 Cor. Lot Ac

794.52
 784.60