

003 6.70 A  
26847

- 004  
38.40 A

#8344

2556.41

21

- 001  
5737.1


1964.30

TRACT  
NEW LONDON - EAST

SEE 21-F FOR PARCEL NOS.

OBERLIN

ASHLAND

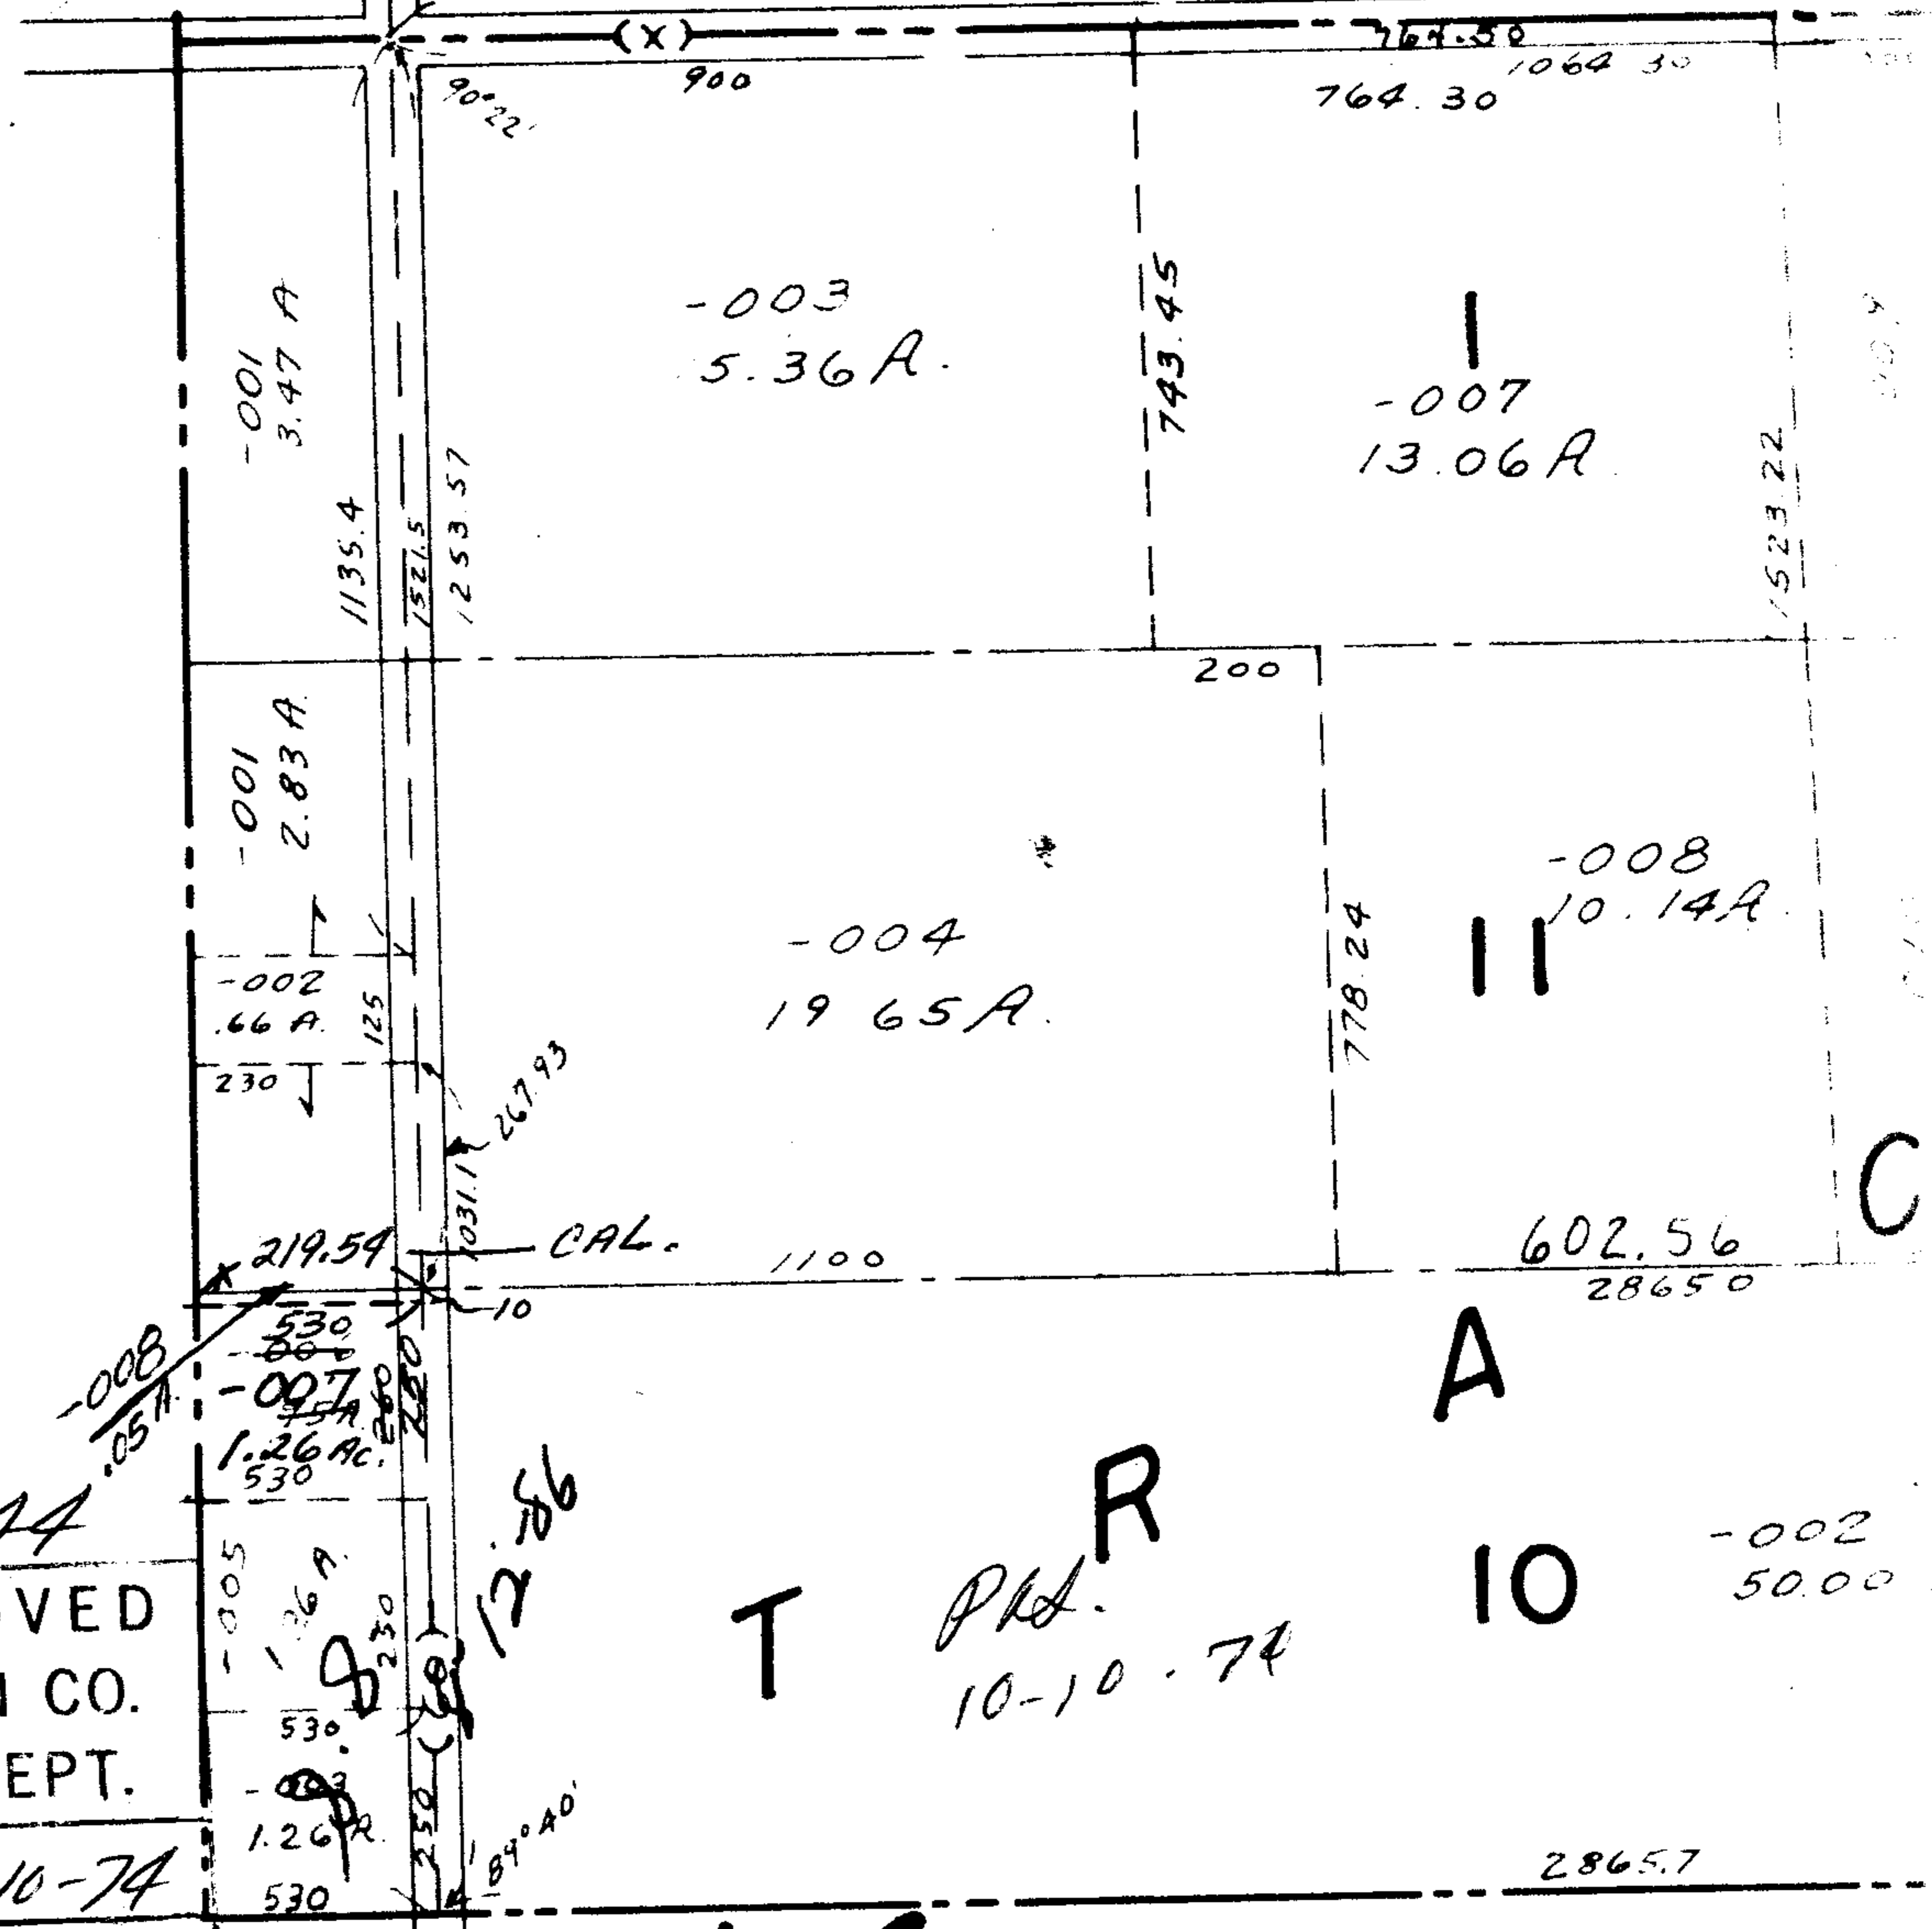

PRR  
10-11-74

#8344

APPROVED LORAIN CO. MAP DEPT.	
DATE	10-10-74
PAGE	21-F + 21-G
BY	Paul
VOID AFTER	



21-B

HUNTINGTON

SCALE: 1" = 400'

Copyright 1962

21-G