

PT 325A

8346

PT 01-00-034-000-020

2 1/2

PT 268A

OCT 11 1974

PT 01-00-034-000-021

PT 255A

PT 01-00-034-000-025

PT 241 AC

146.73

697.40

~~PT 01-00-034-000-024~~

SEE I-E

SEE

~~PT 268A~~

PT 01-00-034-000-026

PT 2.27 AC

146.73

8346

APPROVED. LORAIN CO. MAP DEPT.
DATE 10-11-74
PAGE I-E + I-00-035-A
BY Paul
VOID AFTER

PT 01-00-034-000-022


PT 215A

PT 01-00-034-000-023

PT 201A

578.16

VERNA

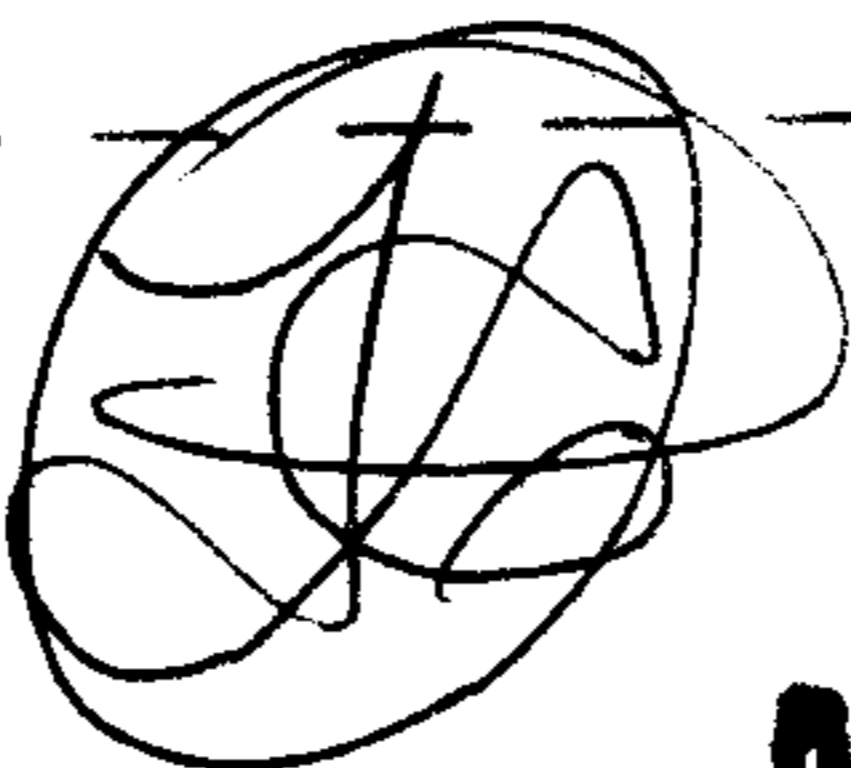

APR 16 1975