



OCT 18 1974

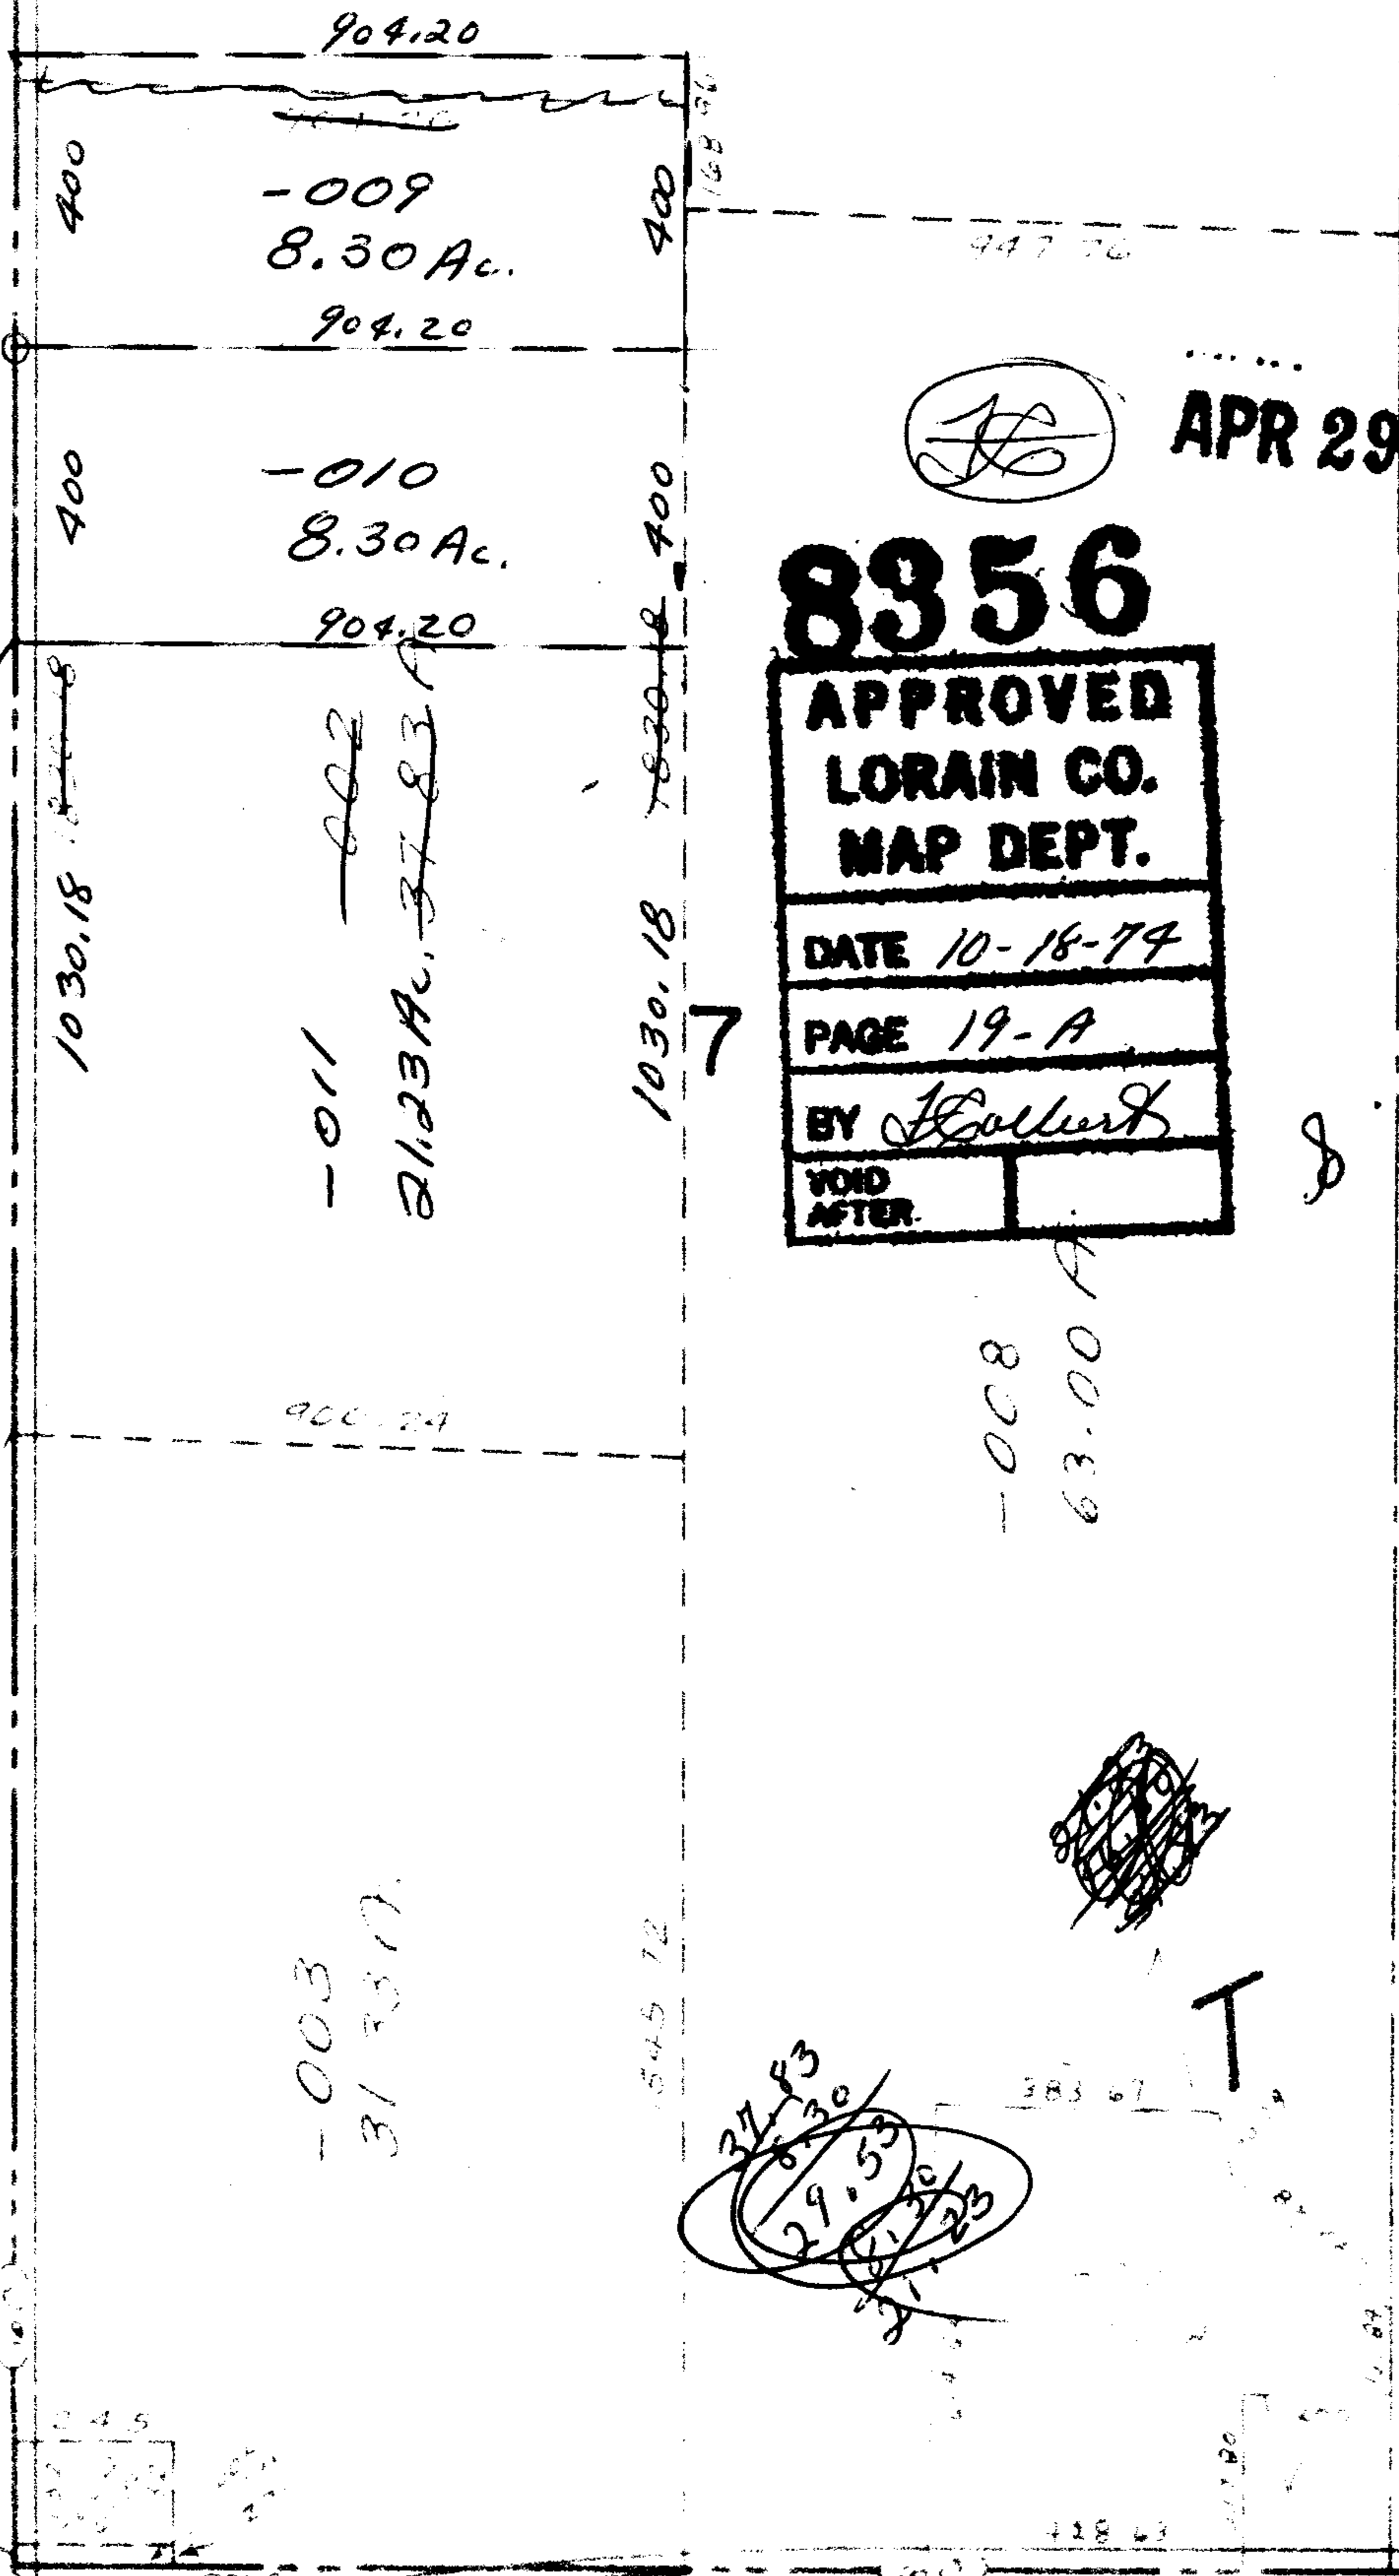

  
 APR 29 1975  
**8356**  
**APPROVED**  
**LORAIN CO.**  
**MAP DEPT.**  
 DATE 10-18-74  
 PAGE 19-A  
 BY *Holler*  
 VOID AFTER:

-001  
 100.00 Ac.  
 6

8  
 8-12-80

-008  
 63.00 Ac.

R

37.43  
 6.30  
 29.53  
 21.23  
 21.23

2728.43

WEST 572

MEDINA - NORWALK

**PENFIELD TWP**

SCALE: 1" = 400'

Copyright 1962

9-A