

OCT 21 1974

OSBORNE

- 002  
22 63A

2212	- 003
<u>155.35</u>	30 37A
2056.65	781
206.82	<u>298.63</u>
<u>91.81</u>	482.37
298.63	

RD.

2056.65

83

1  
 - 016 1613.36 6.38A 91.81  
 - 017 1541.02 6.08A  
 482.37


- 018  
30.75 A.

8357

APPROVED	
LORAIN CO.	
MAP DEPT.	
DATE	10-18-74
PAGE	12-A
BY	J. Albert
VOID AFTER	



MAY 21 1975

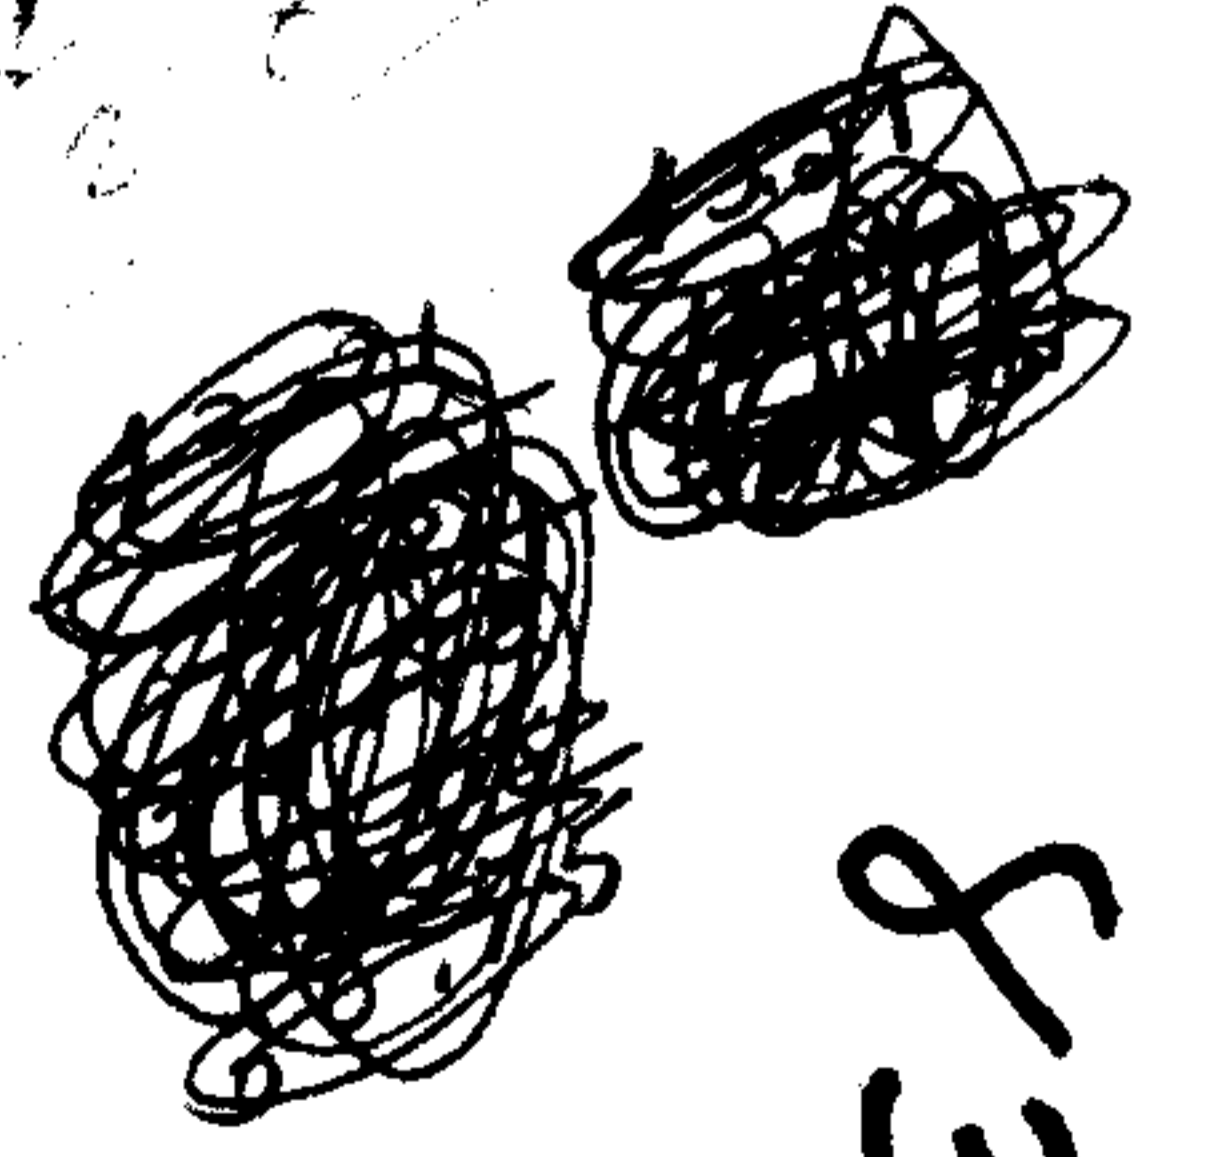

8357